04-00-010-115-???
04-00-010-G

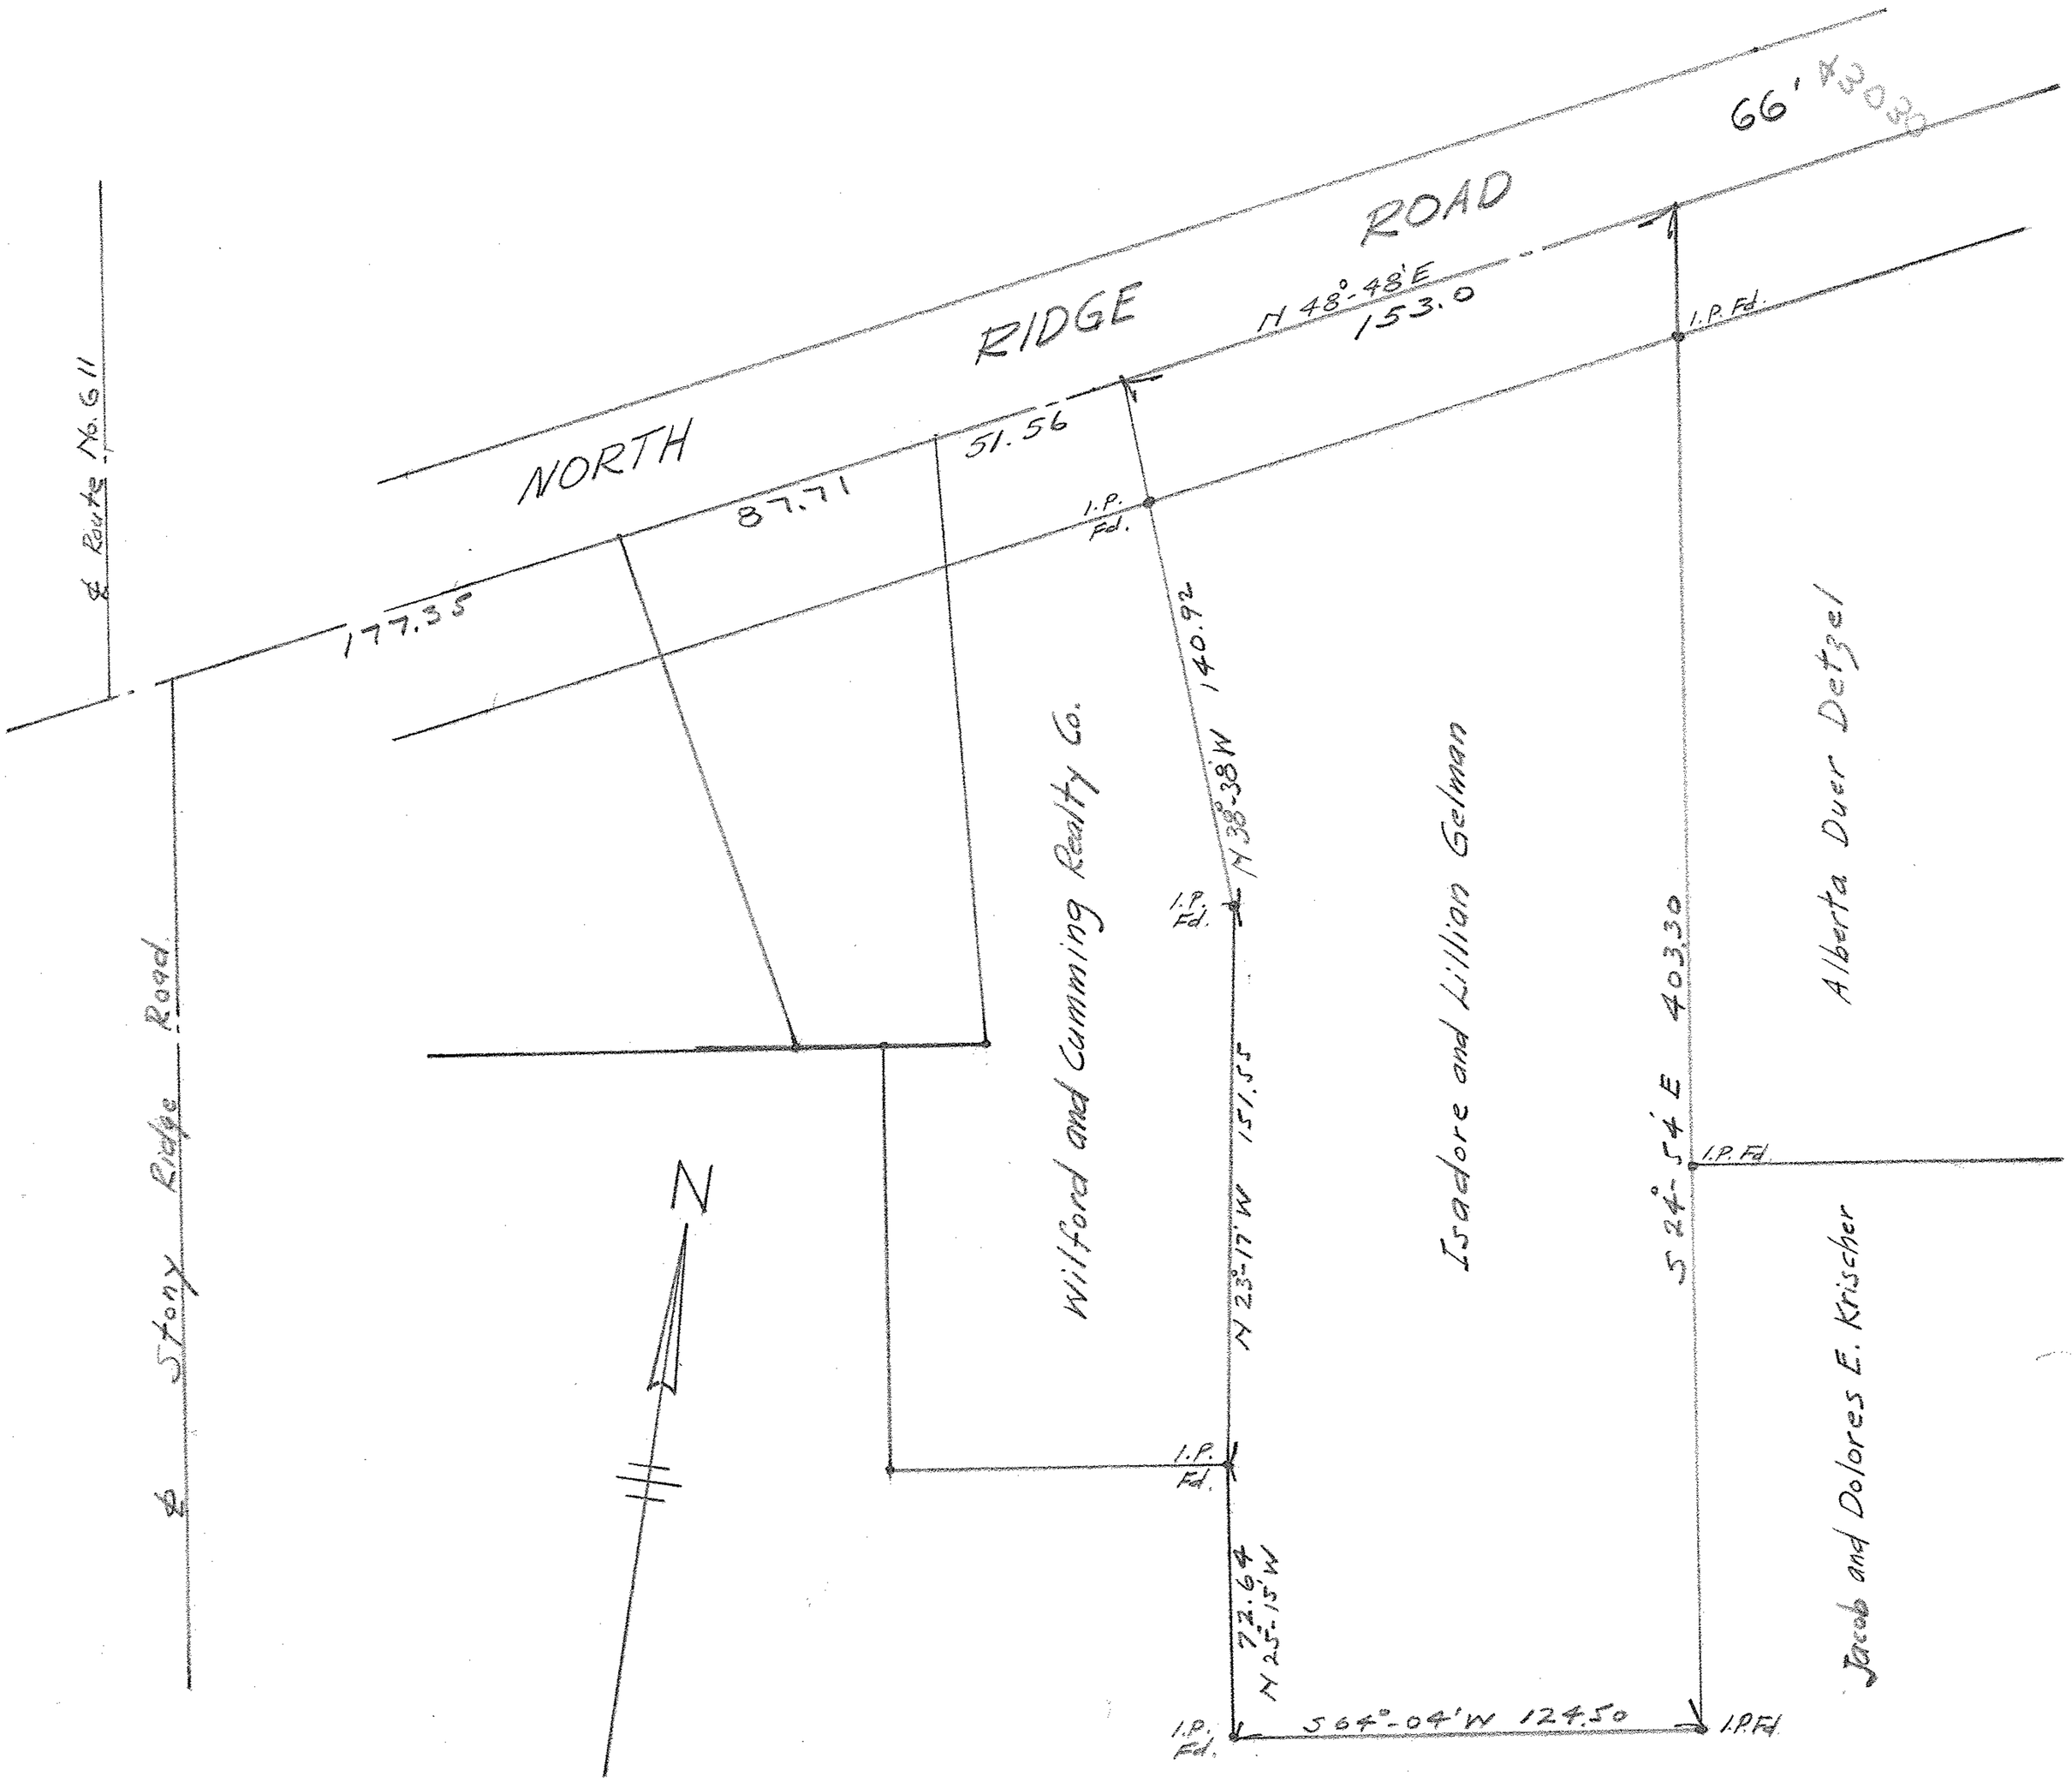

Sketch Of Isadore Gelman Property
In Part Of Original Avon Township Sec. No. 10
Now In The Village Of Avon, Lorain County, Ohio
Scale:- 1" = 40' November 12, 1960
J. H. Getz, Registered Engineer and Surveyor