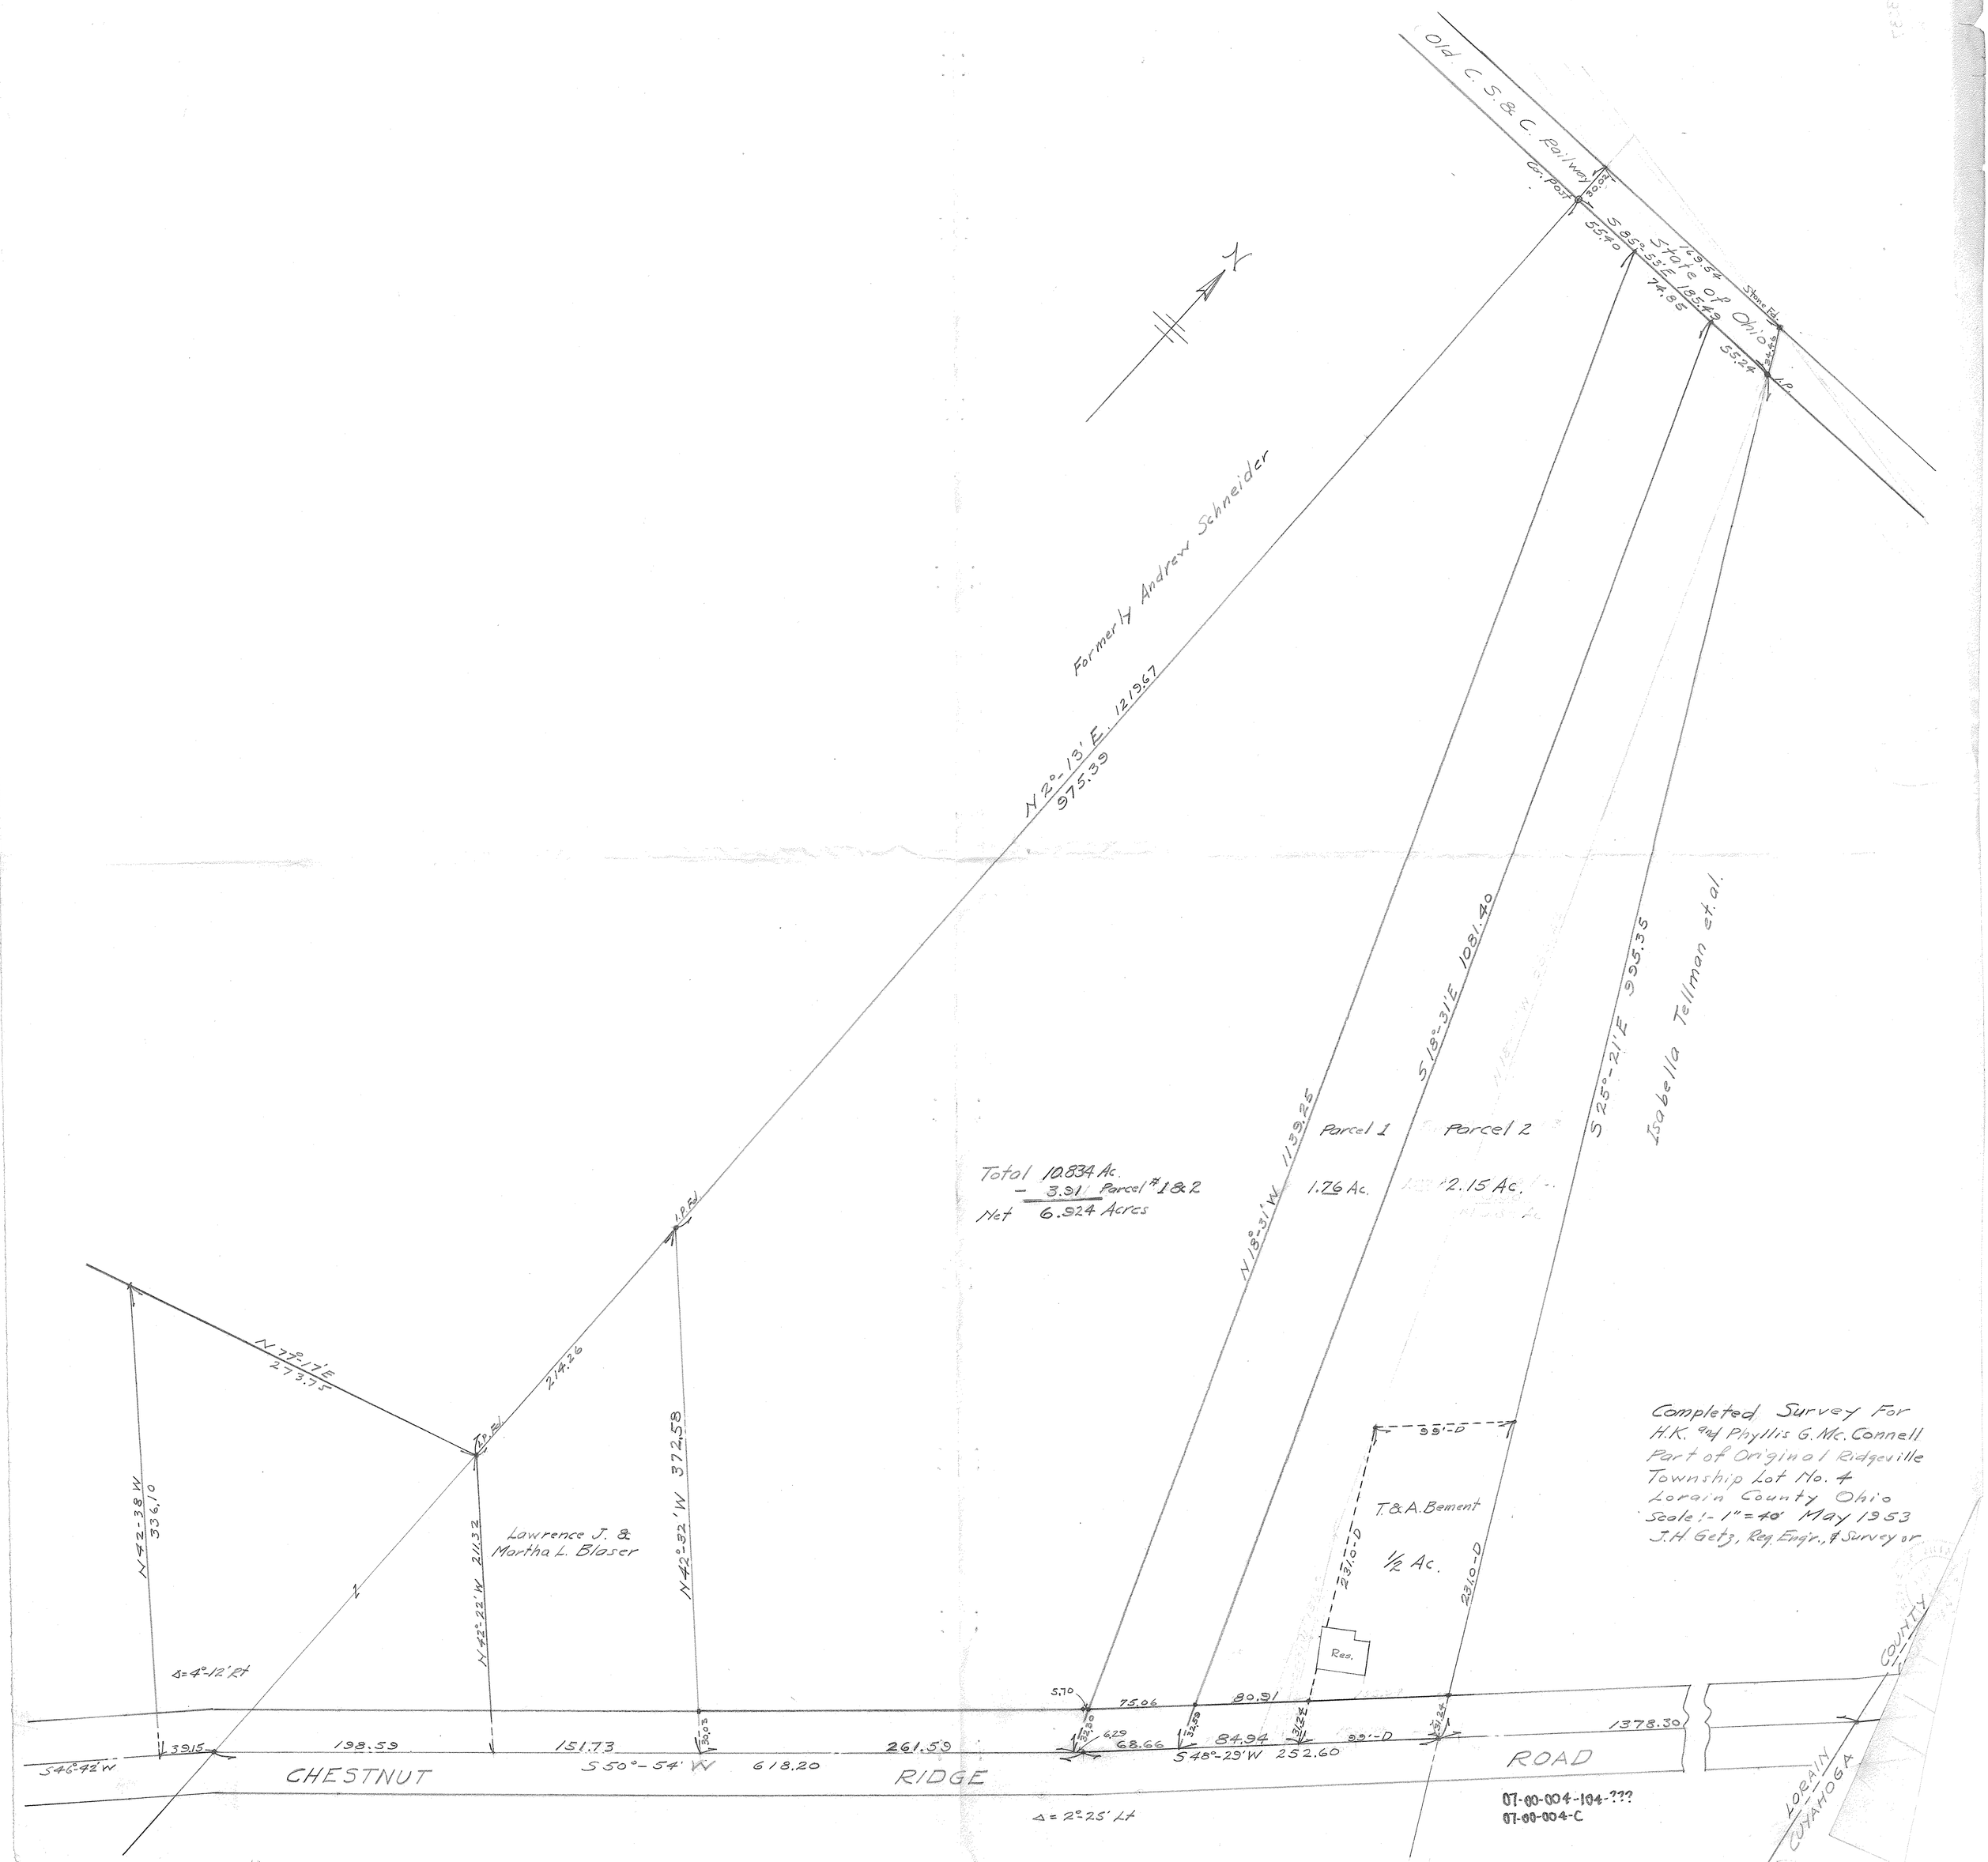
Old C. S. & C. Railway
Co. Post
30.04
S 85°-53' E 185.49
55.40
74.85
169.54
State of Ohio
Stone Fd.
3.46
55.24
I.P.
N
Formerly Andrew Schneider
N 2°-13' E 121.67
975.39
S 18°-31' E 1081.40
S 25°-21' E 995.35
Isabella Tellman et. al.
Parcel 1
Parcel 2
Total 10.834 Ac.
- 3.91 Parcel #1 & 2
Net 6.924 Acres
N 18°-31' W 1139.25
1.76 Ac.
2.15 Ac.
I.P. Fd.
N 77°-17' E
279.75
214.26
N 42°-38' W
336.10
N 42°-22' W 211.32
N 42°-32' W 372.58
Lawrence J. & Martha L. Blaser
Δ = 4°-12' Rt
99'-D
T. & A. Bement
1/2 Ac.
231.0-D
Res.
5.70
75.06
80.91
6.29
68.66
84.94
252.60
99'-D
1378.30
3.91
198.59
151.73
261.59
618.20
S 50°-54' W
S 48°-29' W
S 46°-42' W
CHESTNUT
RIDGE
ROAD
Δ = 2°-25' Lt
07-00-004-104-???
07-00-004-C
LORAIN
CUYAHOGA
COUNTY
Completed Survey For
H.K. and Phyllis G. Mc. Connell
Part of Original Ridgeville
Township Lot No. 4
Lorain County Ohio
Scale:- 1" = 40' May 1953
J.H. Getz, Reg. Engr., & Surveyor