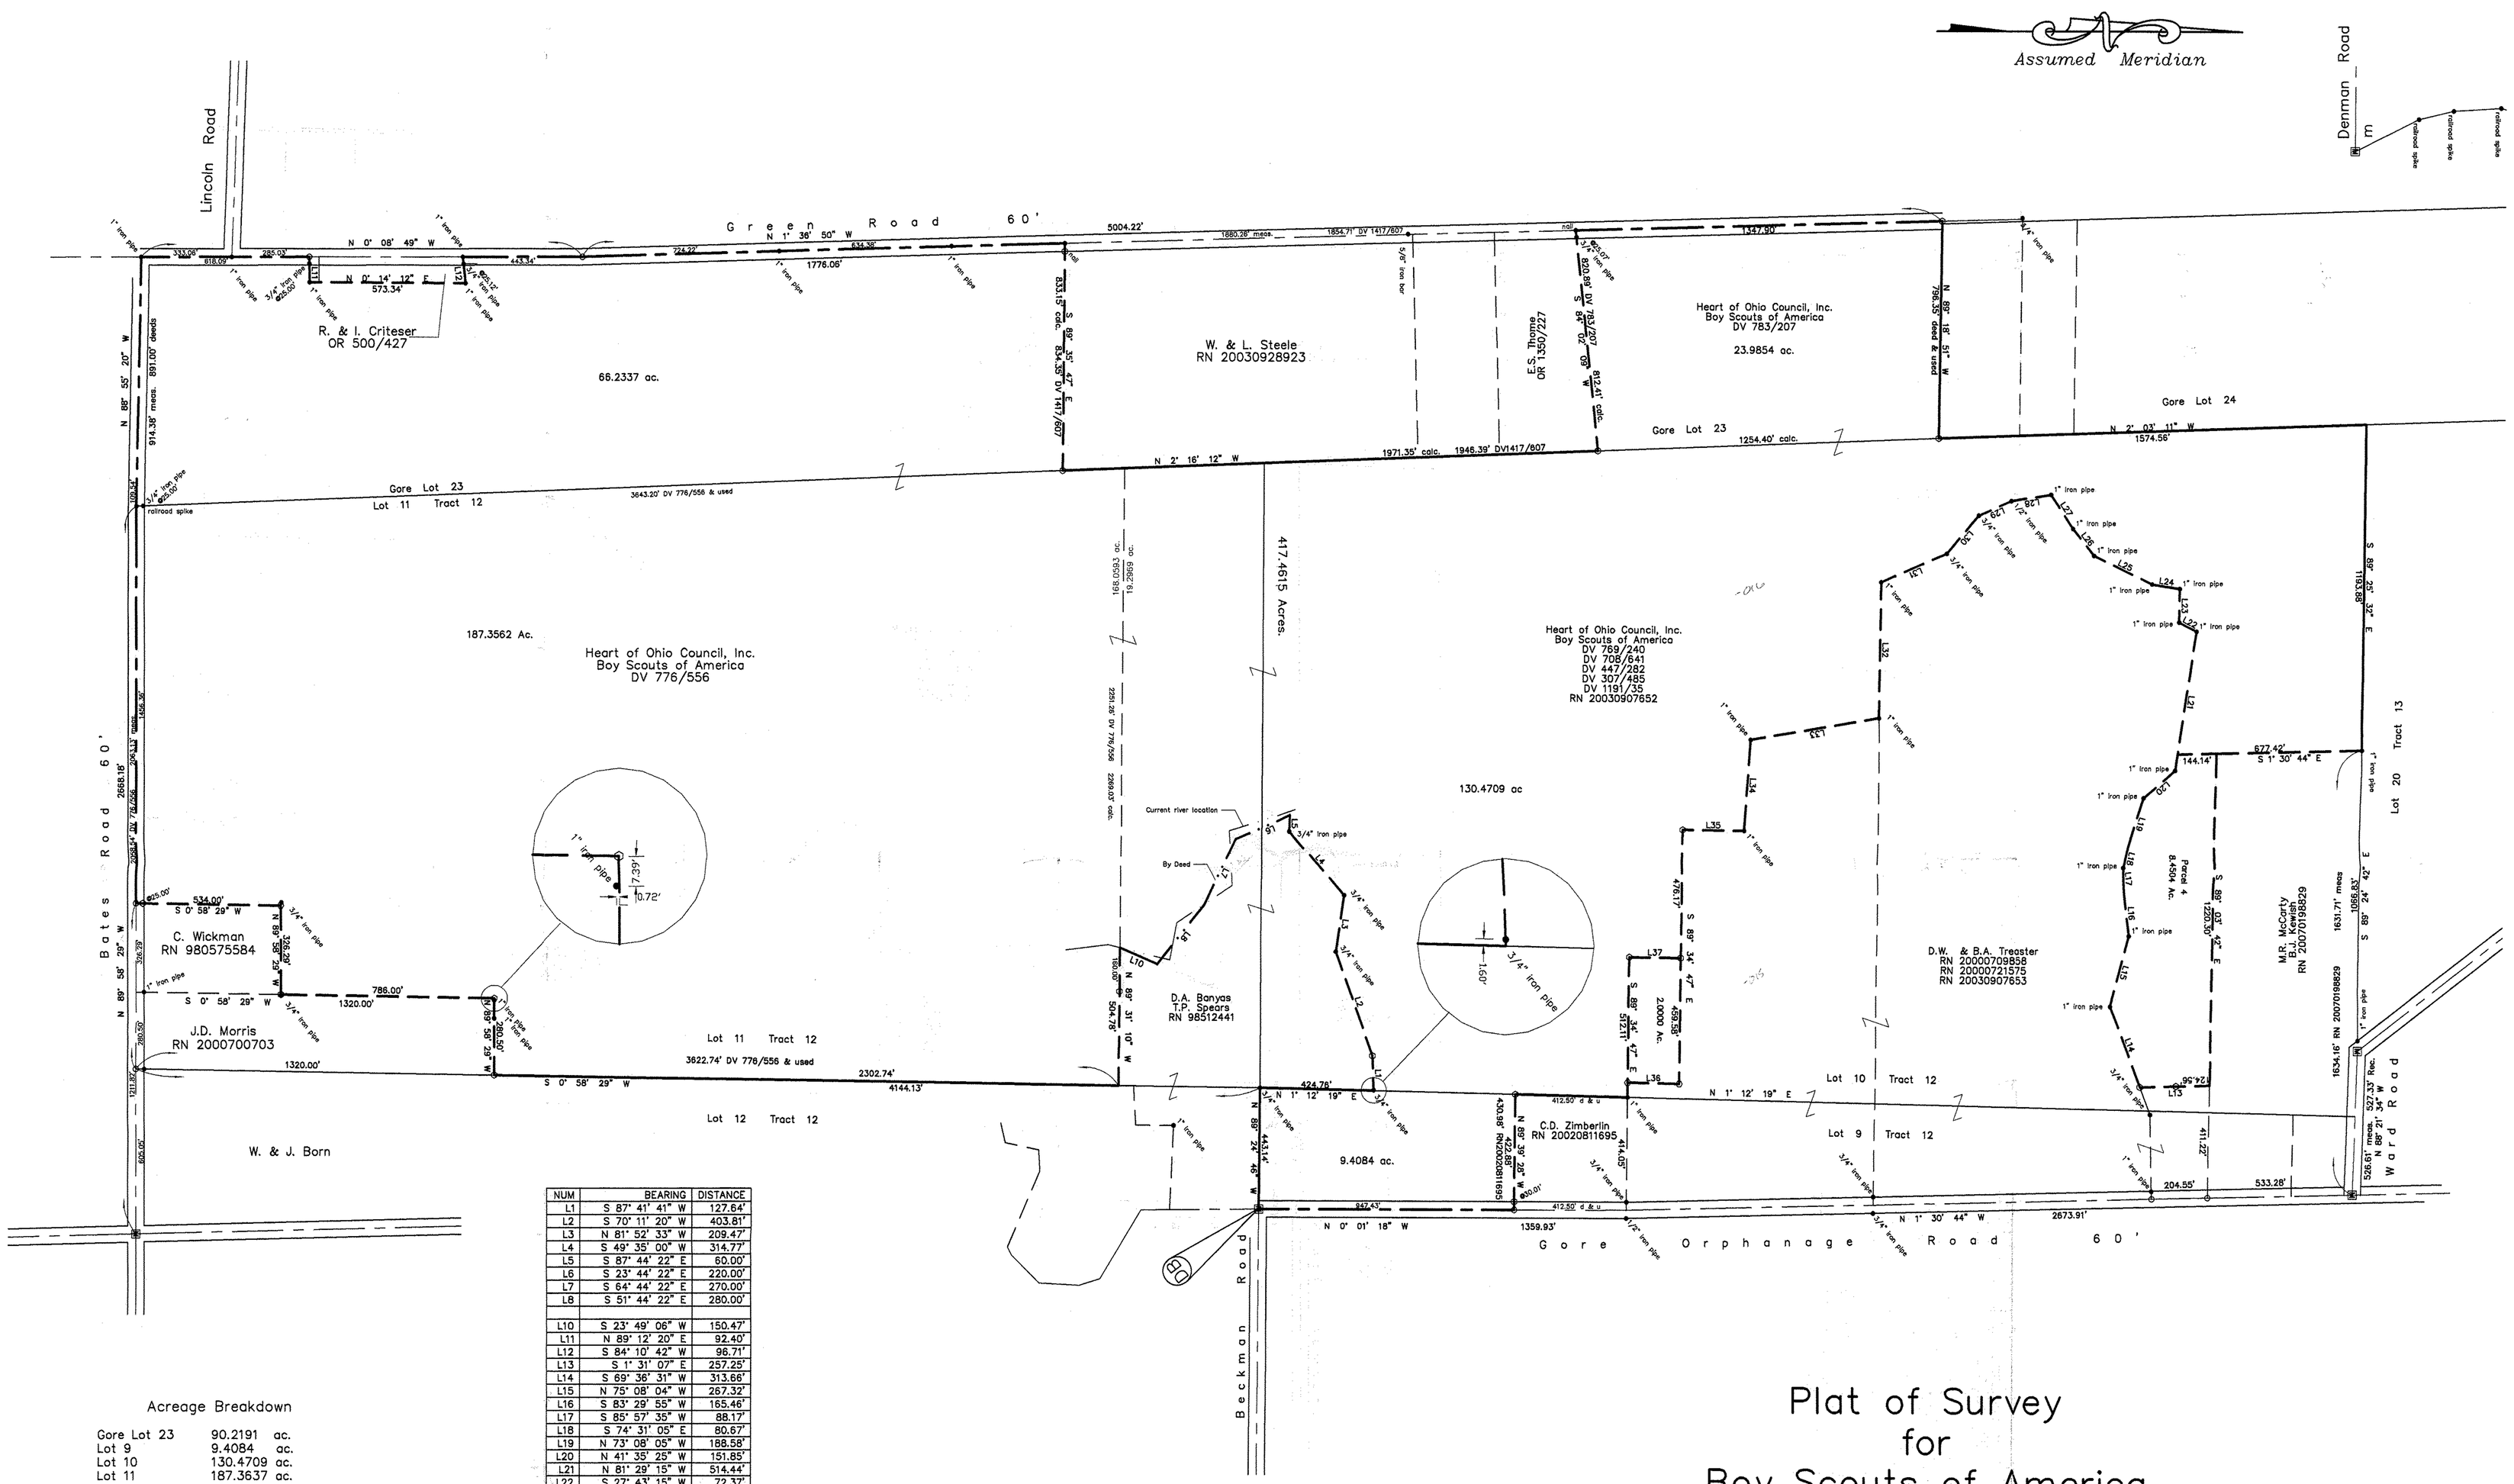

NUM	BEARING	DISTANCE
L1	S 87° 41' 41" W	127.64'
L2	S 70° 11' 20" W	403.81'
L3	N 81° 52' 33" W	209.47'
L4	S 49° 35' 00" W	314.77'
L5	S 87° 44' 22" E	60.00'
L6	S 23° 44' 22" E	220.00'
L7	S 64° 44' 22" E	270.00'
L8	S 51° 44' 22" E	280.00'
L10	S 23° 49' 06" W	150.47'
L11	N 89° 12' 20" E	92.40'
L12	S 84° 10' 42" W	96.71'
L13	S 1° 31' 07" E	257.25'
L14	S 69° 36' 31" W	313.66'
L15	N 75° 08' 04" W	267.32'
L16	S 83° 29' 55" W	165.46'
L17	S 85° 57' 35" W	88.17'
L18	S 74° 31' 05" E	80.67'
L19	N 73° 08' 05" W	188.58'
L20	N 41° 35' 25" W	151.85'
L21	N 81° 29' 15" W	514.44'
L22	S 27° 43' 15" W	72.37'
L23	N 88° 43' 05" W	122.99'
L24	S 8° 59' 35" W	104.02'
L25	S 25° 55' 55" W	237.74'
L26	S 51° 47' 05" W	125.88'
L27	S 57° 12' 05" W	148.01'
L28	S 8° 56' 14" E	149.77'
L29	S 24° 25' 00" E	131.13'
L30	S 49° 53' 39" E	182.98'
L31	S 23° 33' 28" E	263.27'
L32	S 89° 24' 04" E	499.32'
L33	S 9° 34' 16" E	479.69'
L34	S 85° 54' 36" E	335.47'
L35	S 0° 42' 10" W	225.59'
L36	N 1° 12' 19" E	189.93'
L37	S 0° 42' 10" W	189.92'

Acreage Breakdown

Gore Lot 23	90.2191	ac.
Lot 9	9.4084	ac.
Lot 10	130.4709	ac.
Lot 11	187.3637	ac.
Total	417.4615	AC.

STATE OF OHIO
Timothy O. Riley
#S-6925
PROFESSIONAL SURVEYOR

Timothy Riley
Reg. Surveyor No. 6925

Plat of Survey for Boy Scouts of America

Being a part of Lot 23 within the Gore Strip and a part of Lots 9, 10, and 11 wihtin Tract 12, Henrietta Township, Lorain County, Ohio

○ 9/16" hex bar set
● Monument found
○ Nail Set
[M] Monument Box
0 1 2 3
Inch Scale
E/C 1:10000

Timothy Riley
Engineer - Surveyor
Norwalk, Ohio

Boy Scout Camp	
Gore Orphanage Rd	
Green & Bates Rd	
Henrietta Township	
Date: 6-29-2007	
Scale: 1" = 300'	
Dwn By: CAD	
Ckd By: TOR	
Project No. 32006 1	
Sheet No. / Total Shts.	

08-12-010-000-016 & -015