07-00-028-103-037
07-00-028-D
P4
028

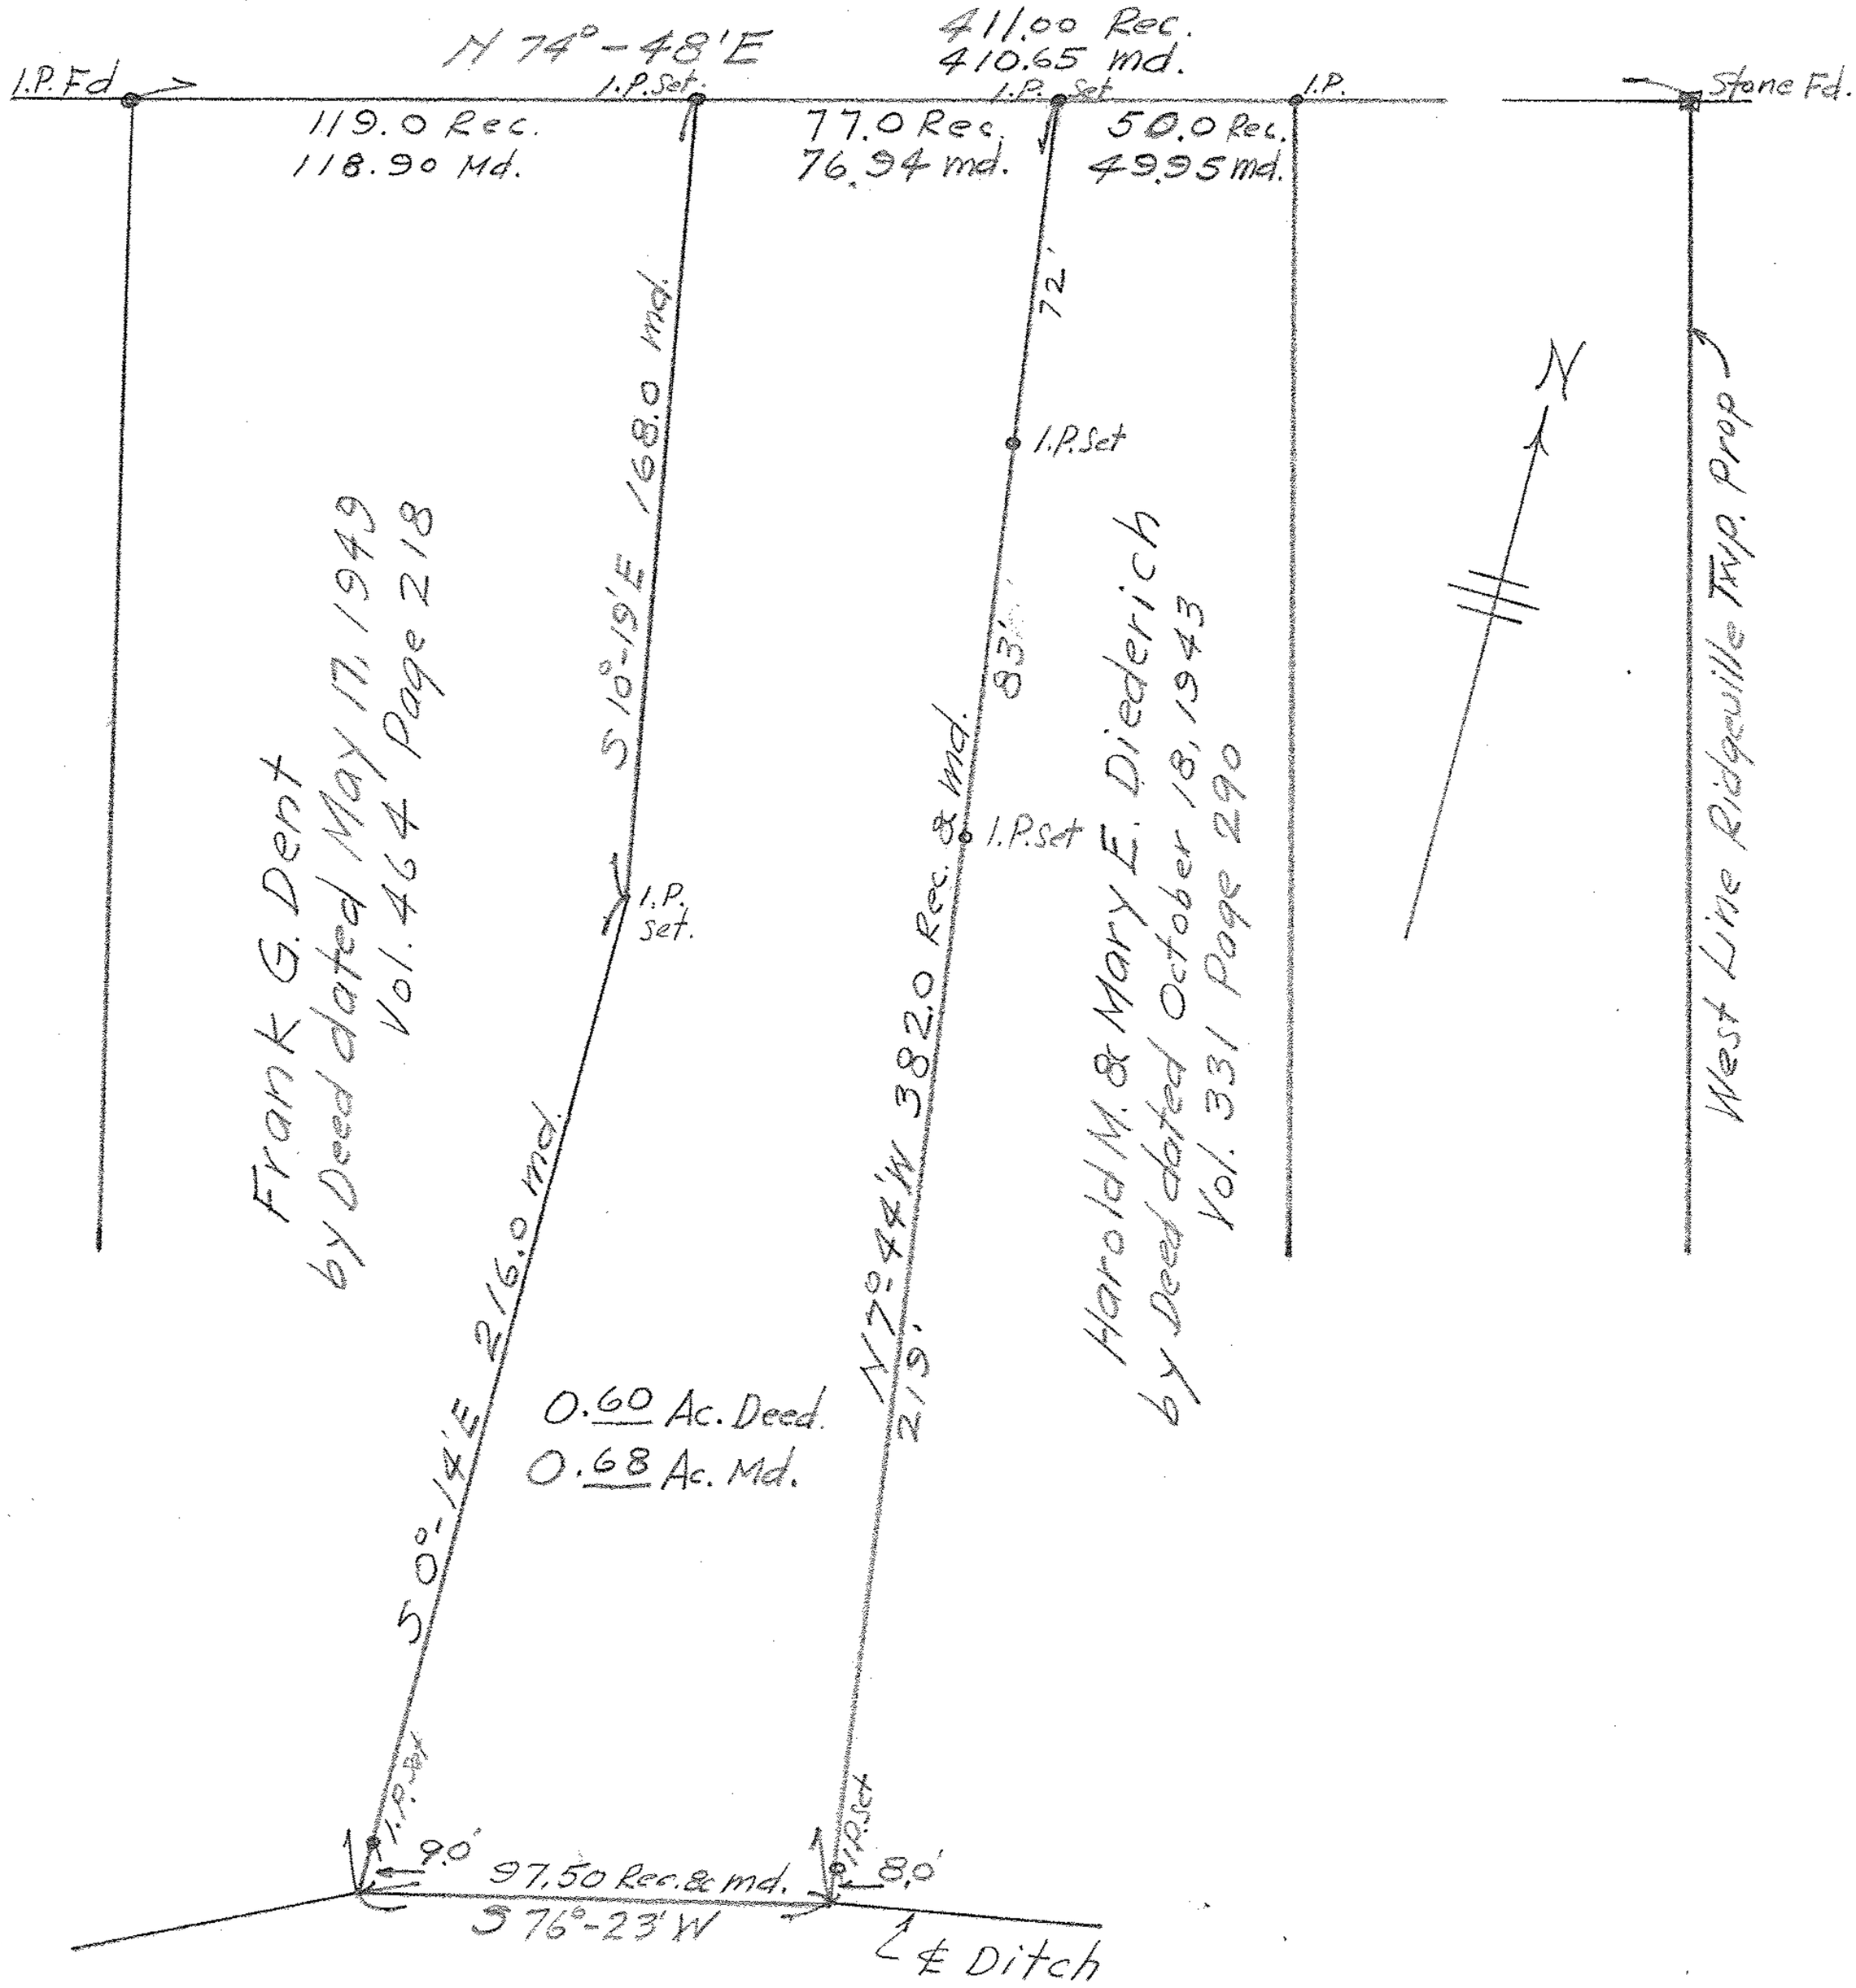

Survey For Anthony & Rosemary Jarven
In Part of Original Ridgeville Twp. Lot No. 28
Ridgeville Township, Lorain County Ohio
Scale 1"= 40' July 25, 1950
J. H. Getz, Reg. Engr. and Surveyor