
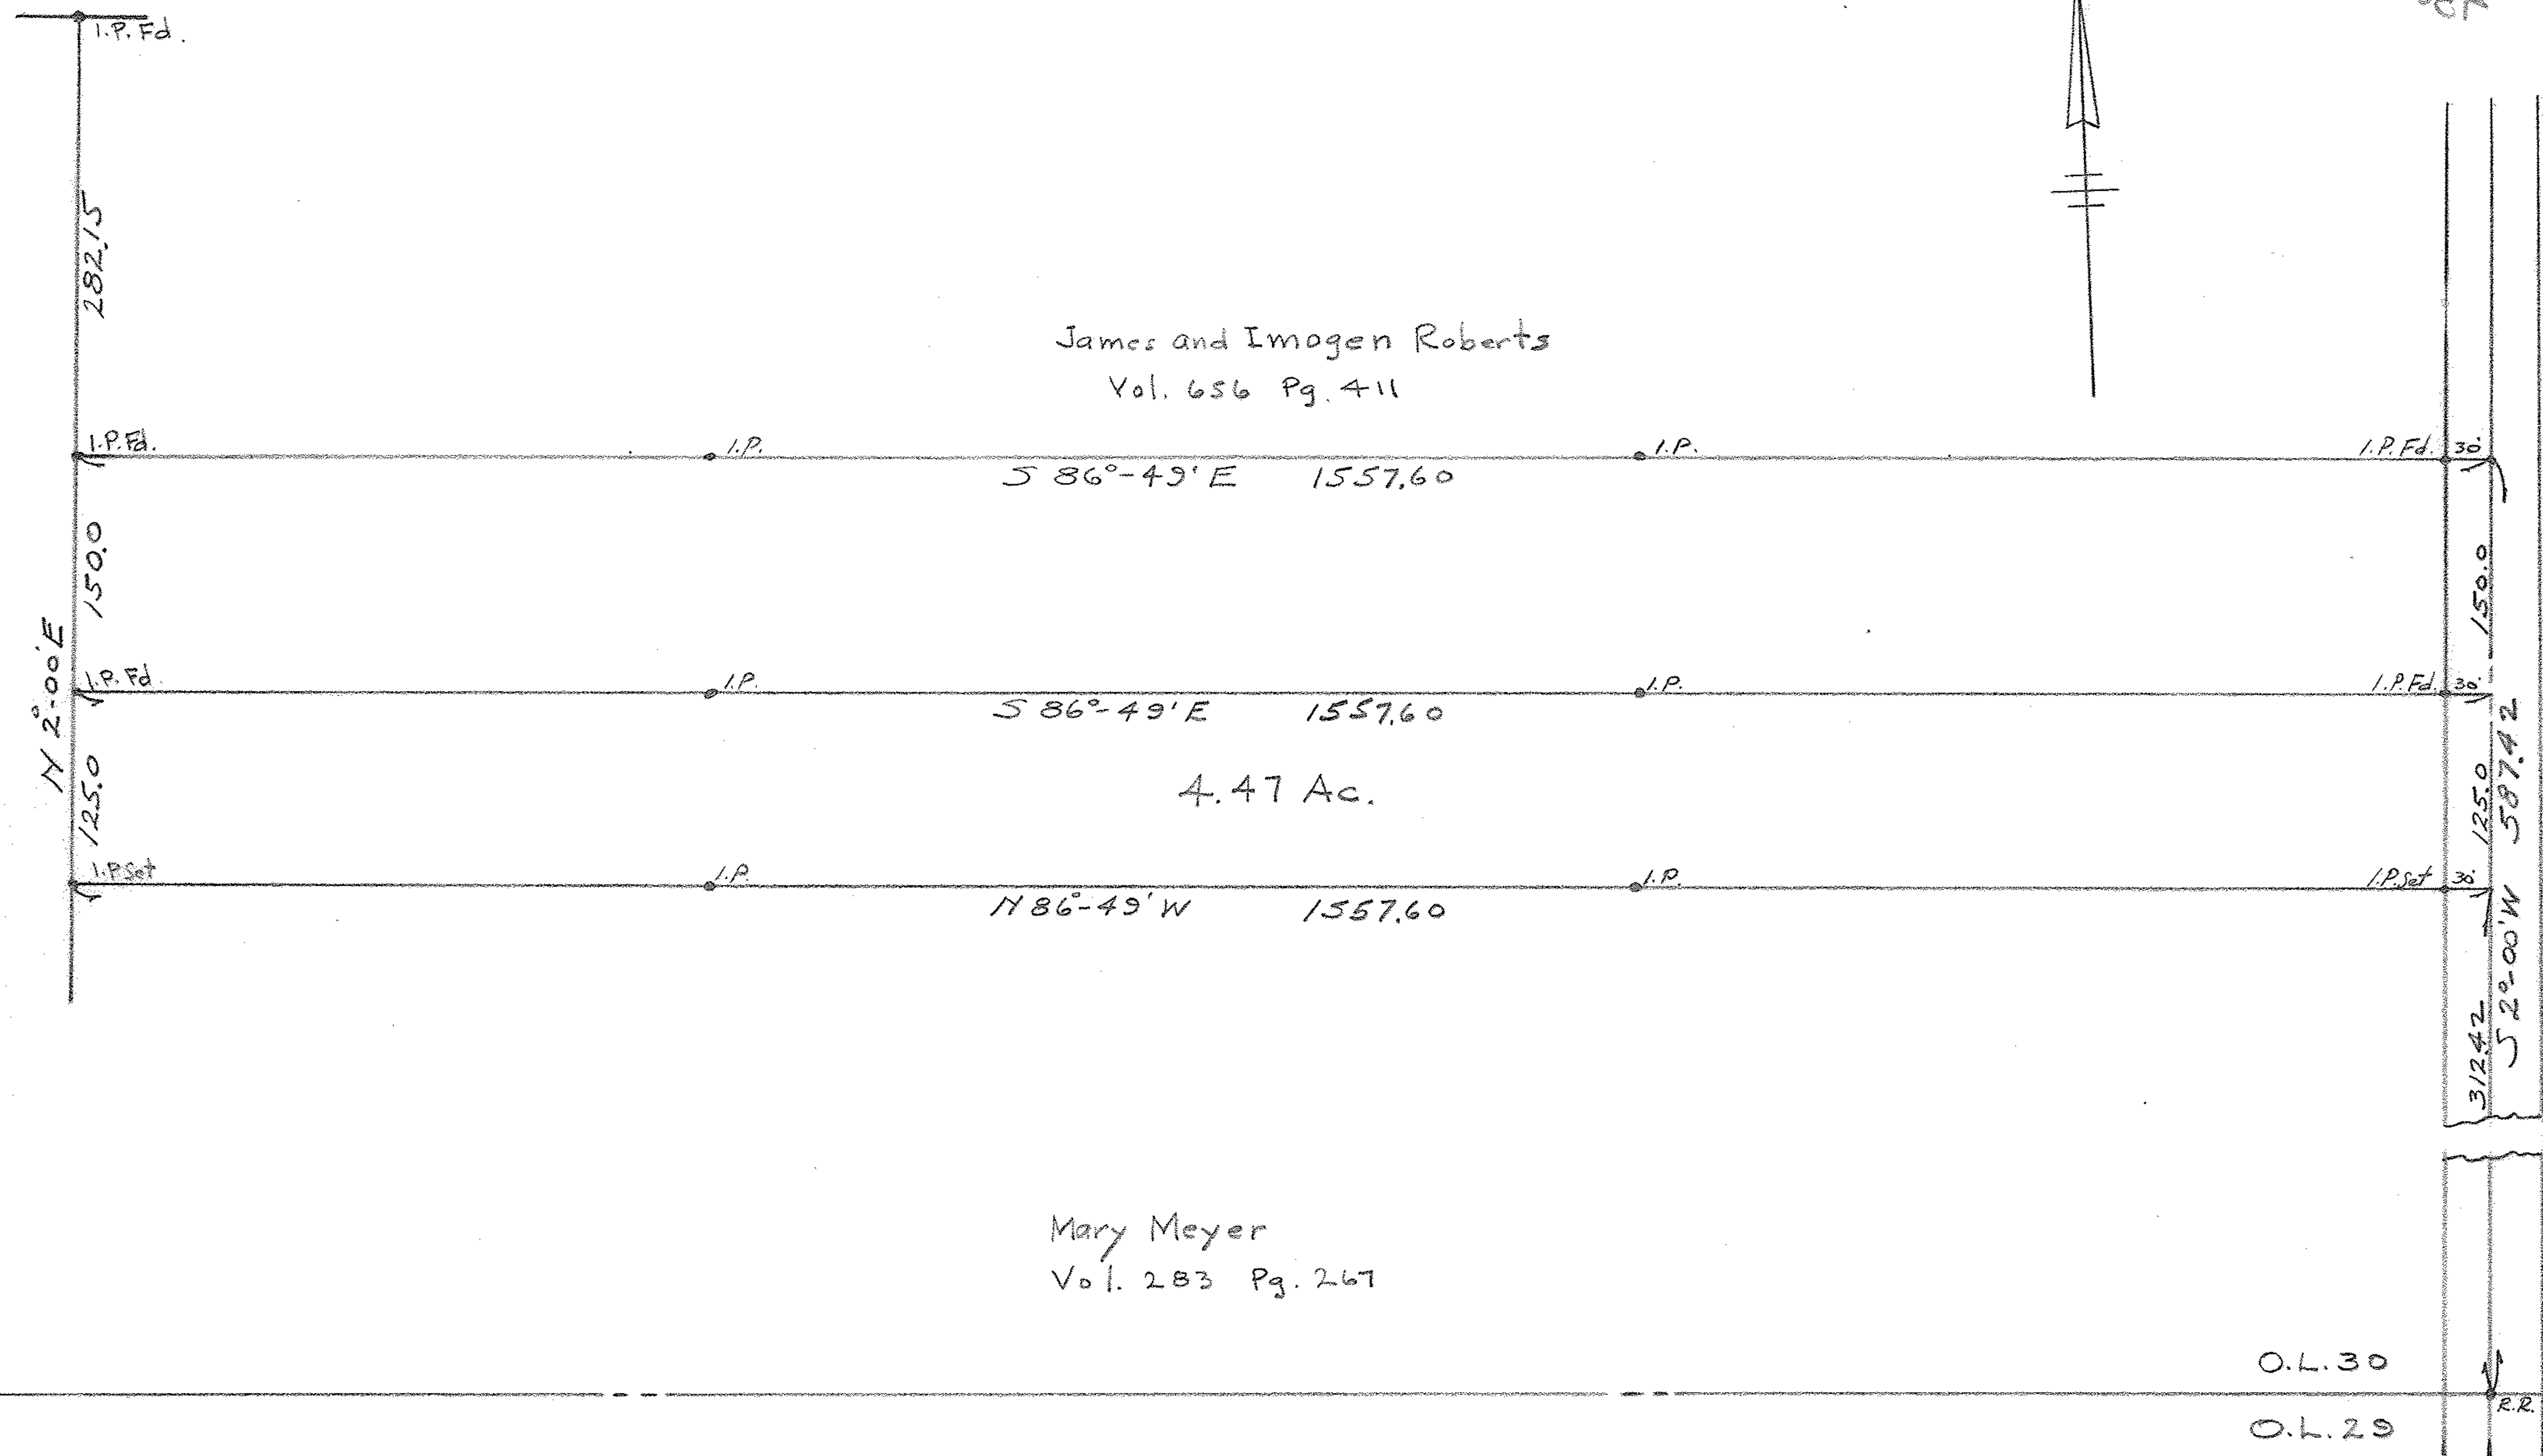


7-B
1208A

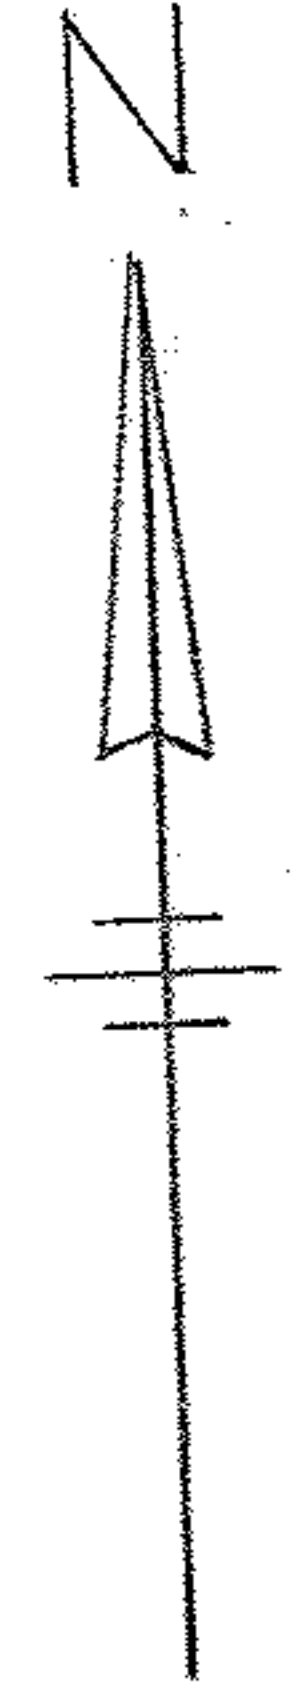

Survey of 4.47 Acre Parcel for
Mary Meyer
In part of Original Ridgerville Twp. Lot No. 30
Now in the Village of North Ridgerville, Lorain County, Ohio
Scale: 1" = 100' May 7, 1960 J.H. Getz, Reg. Engineer and Surveyor