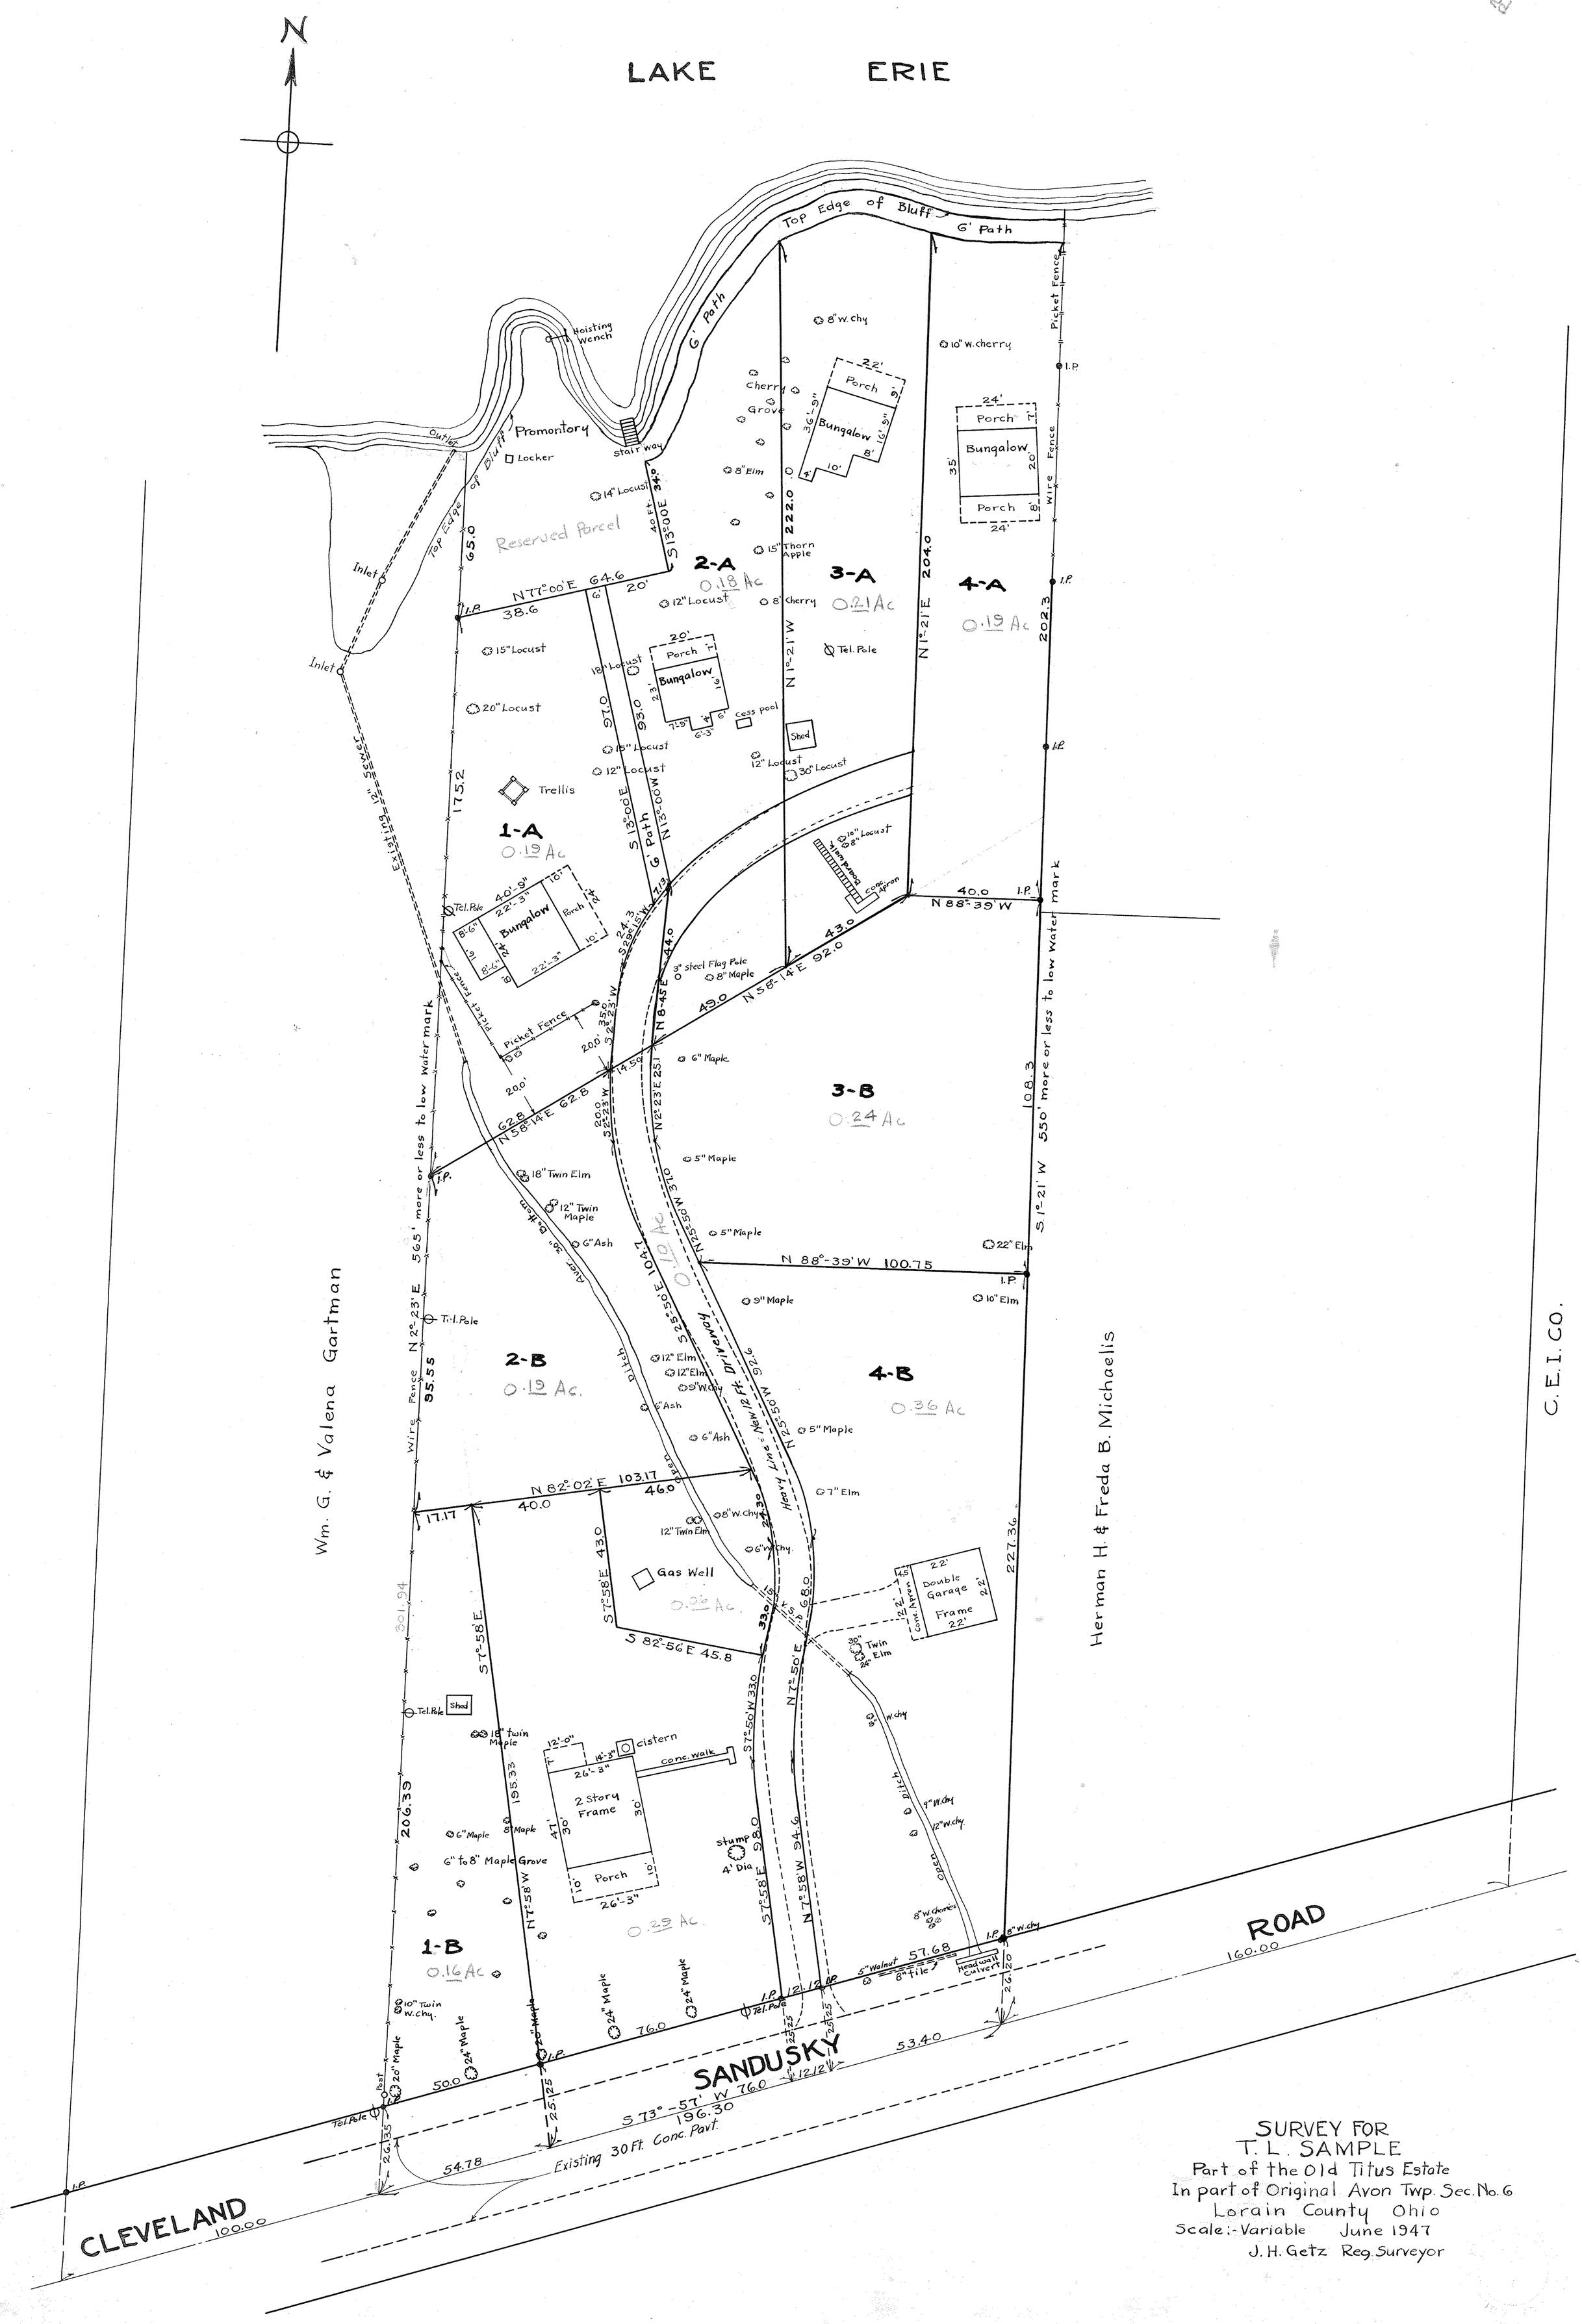04-00-006-101-???
04-00-006-A