07-00-045-101-038
07-00-045-B

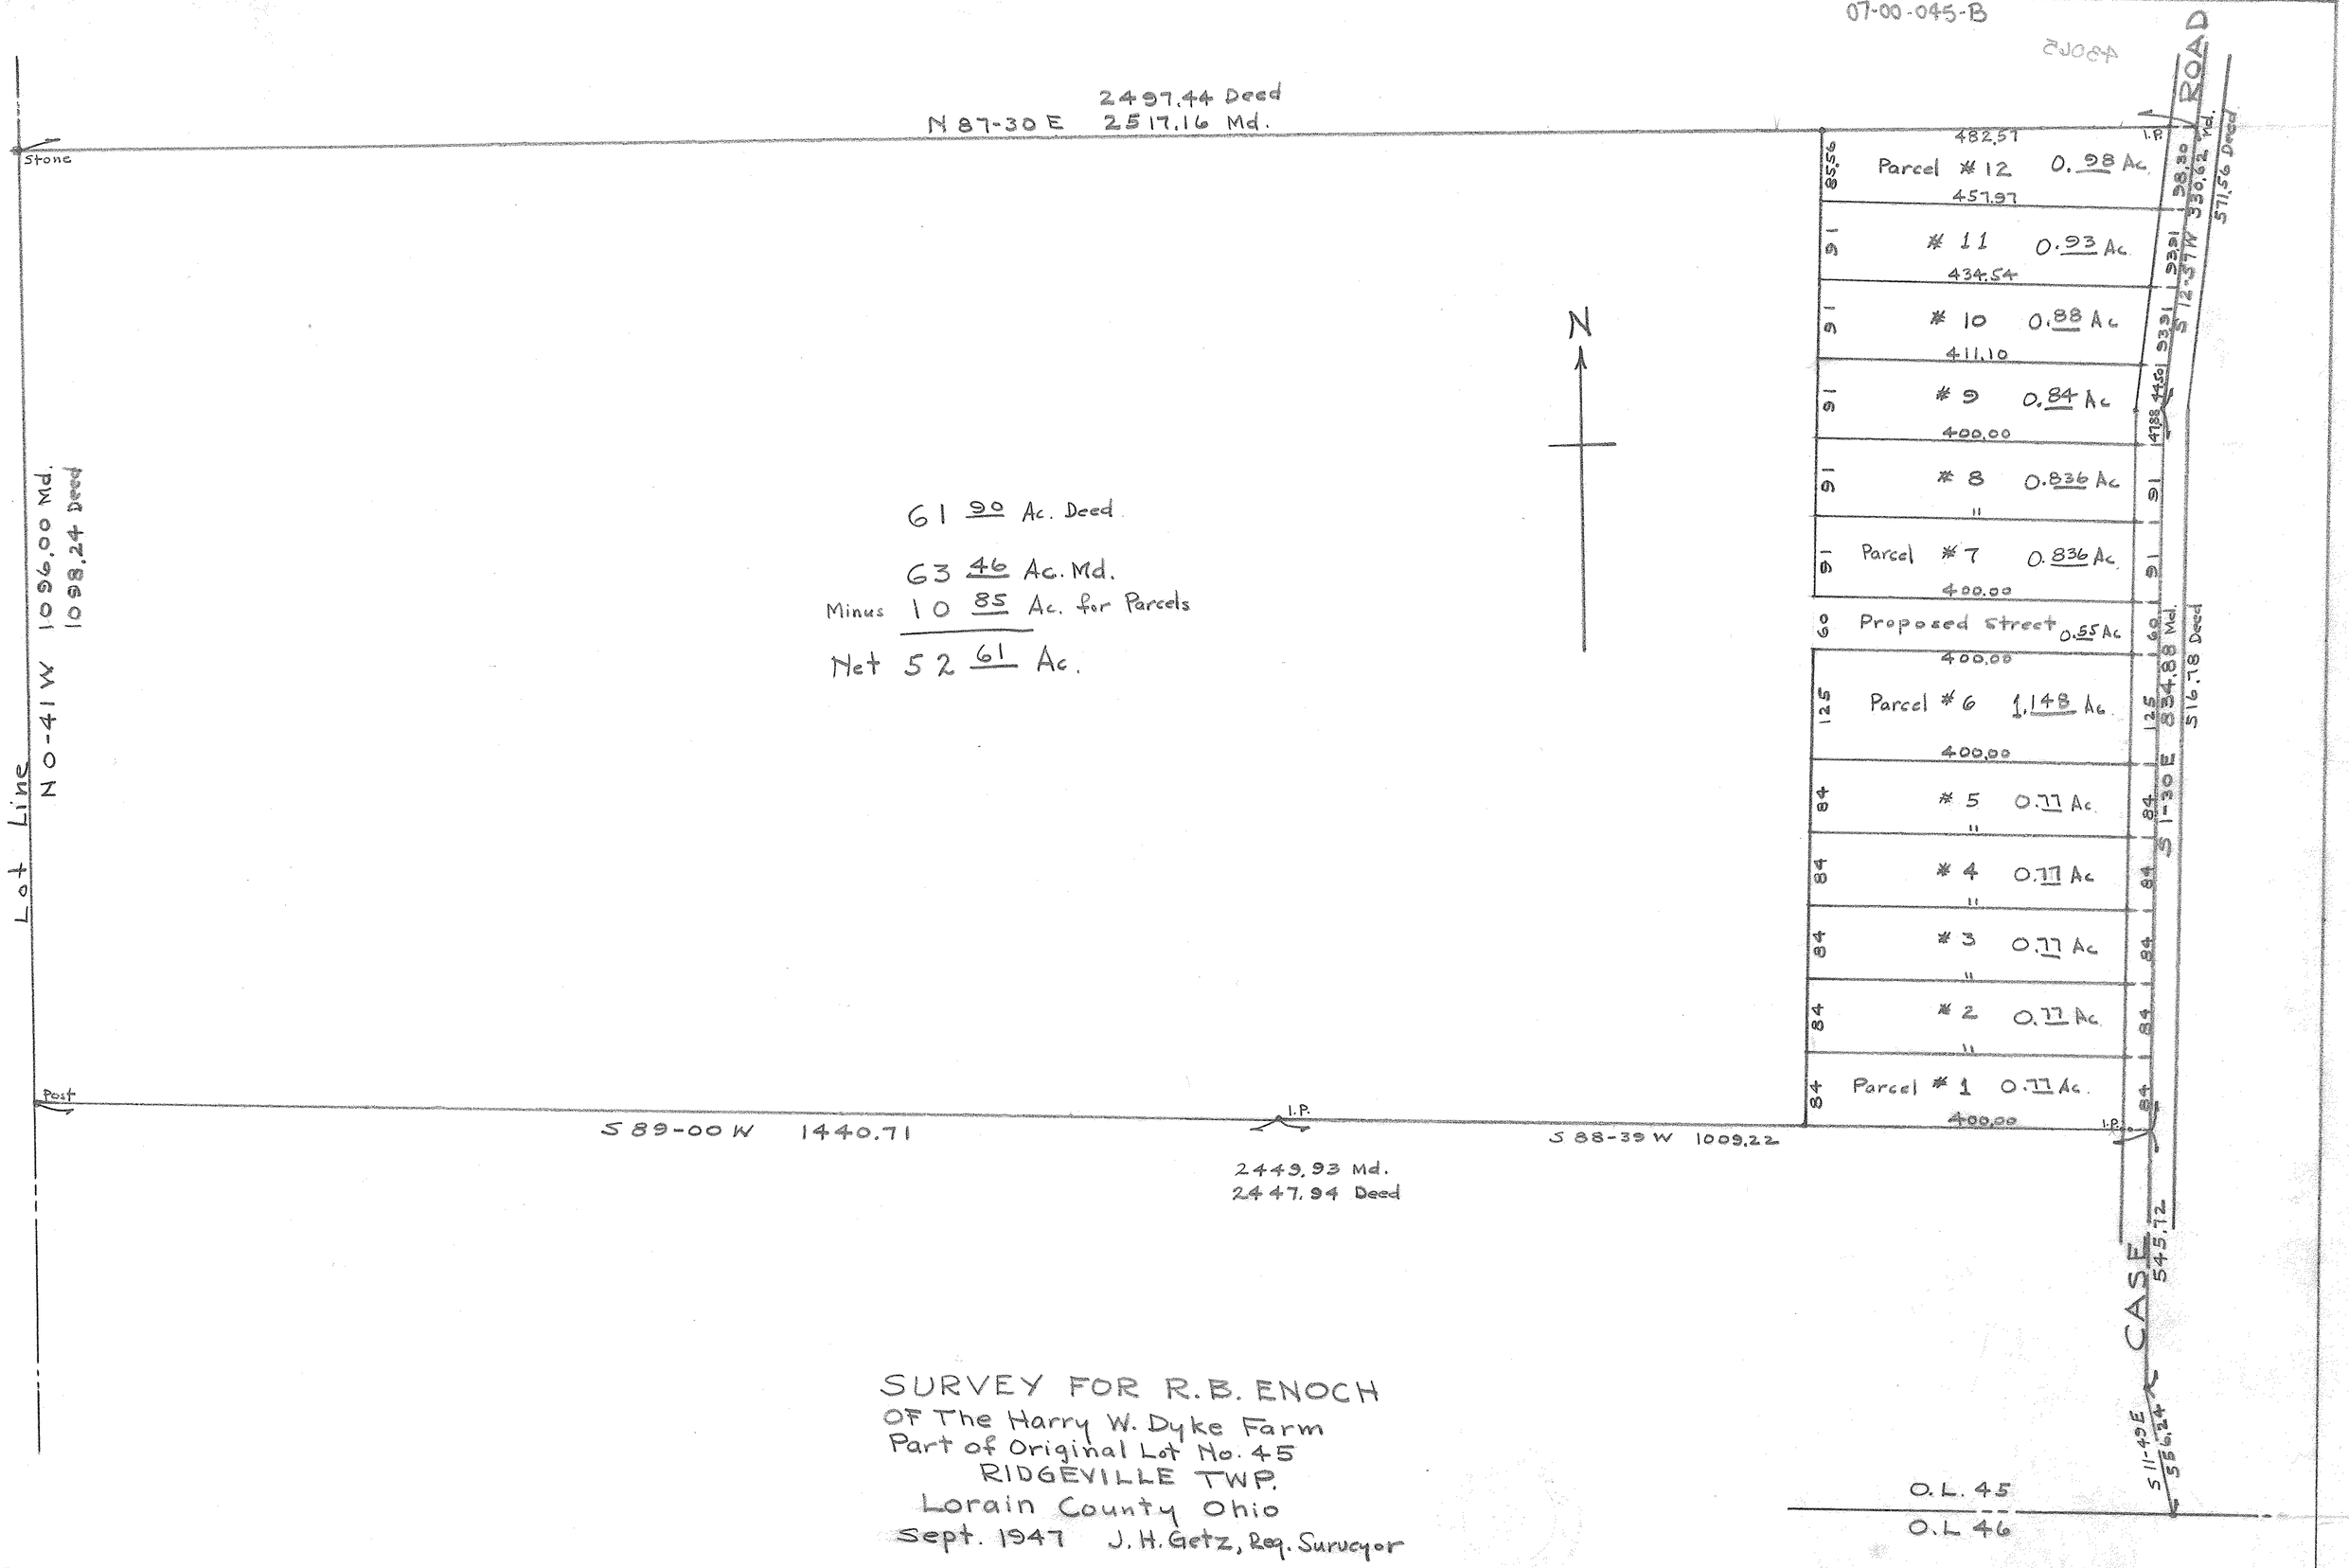

SURVEY FOR R.B. ENOCH
Of The Harry W. Dyke Farm
Part of Original Lot No. 45
RIDGEVILLE TWP.
Lorain County Ohio
Sept. 1947 J.H. Getz, Reg. Surveyor