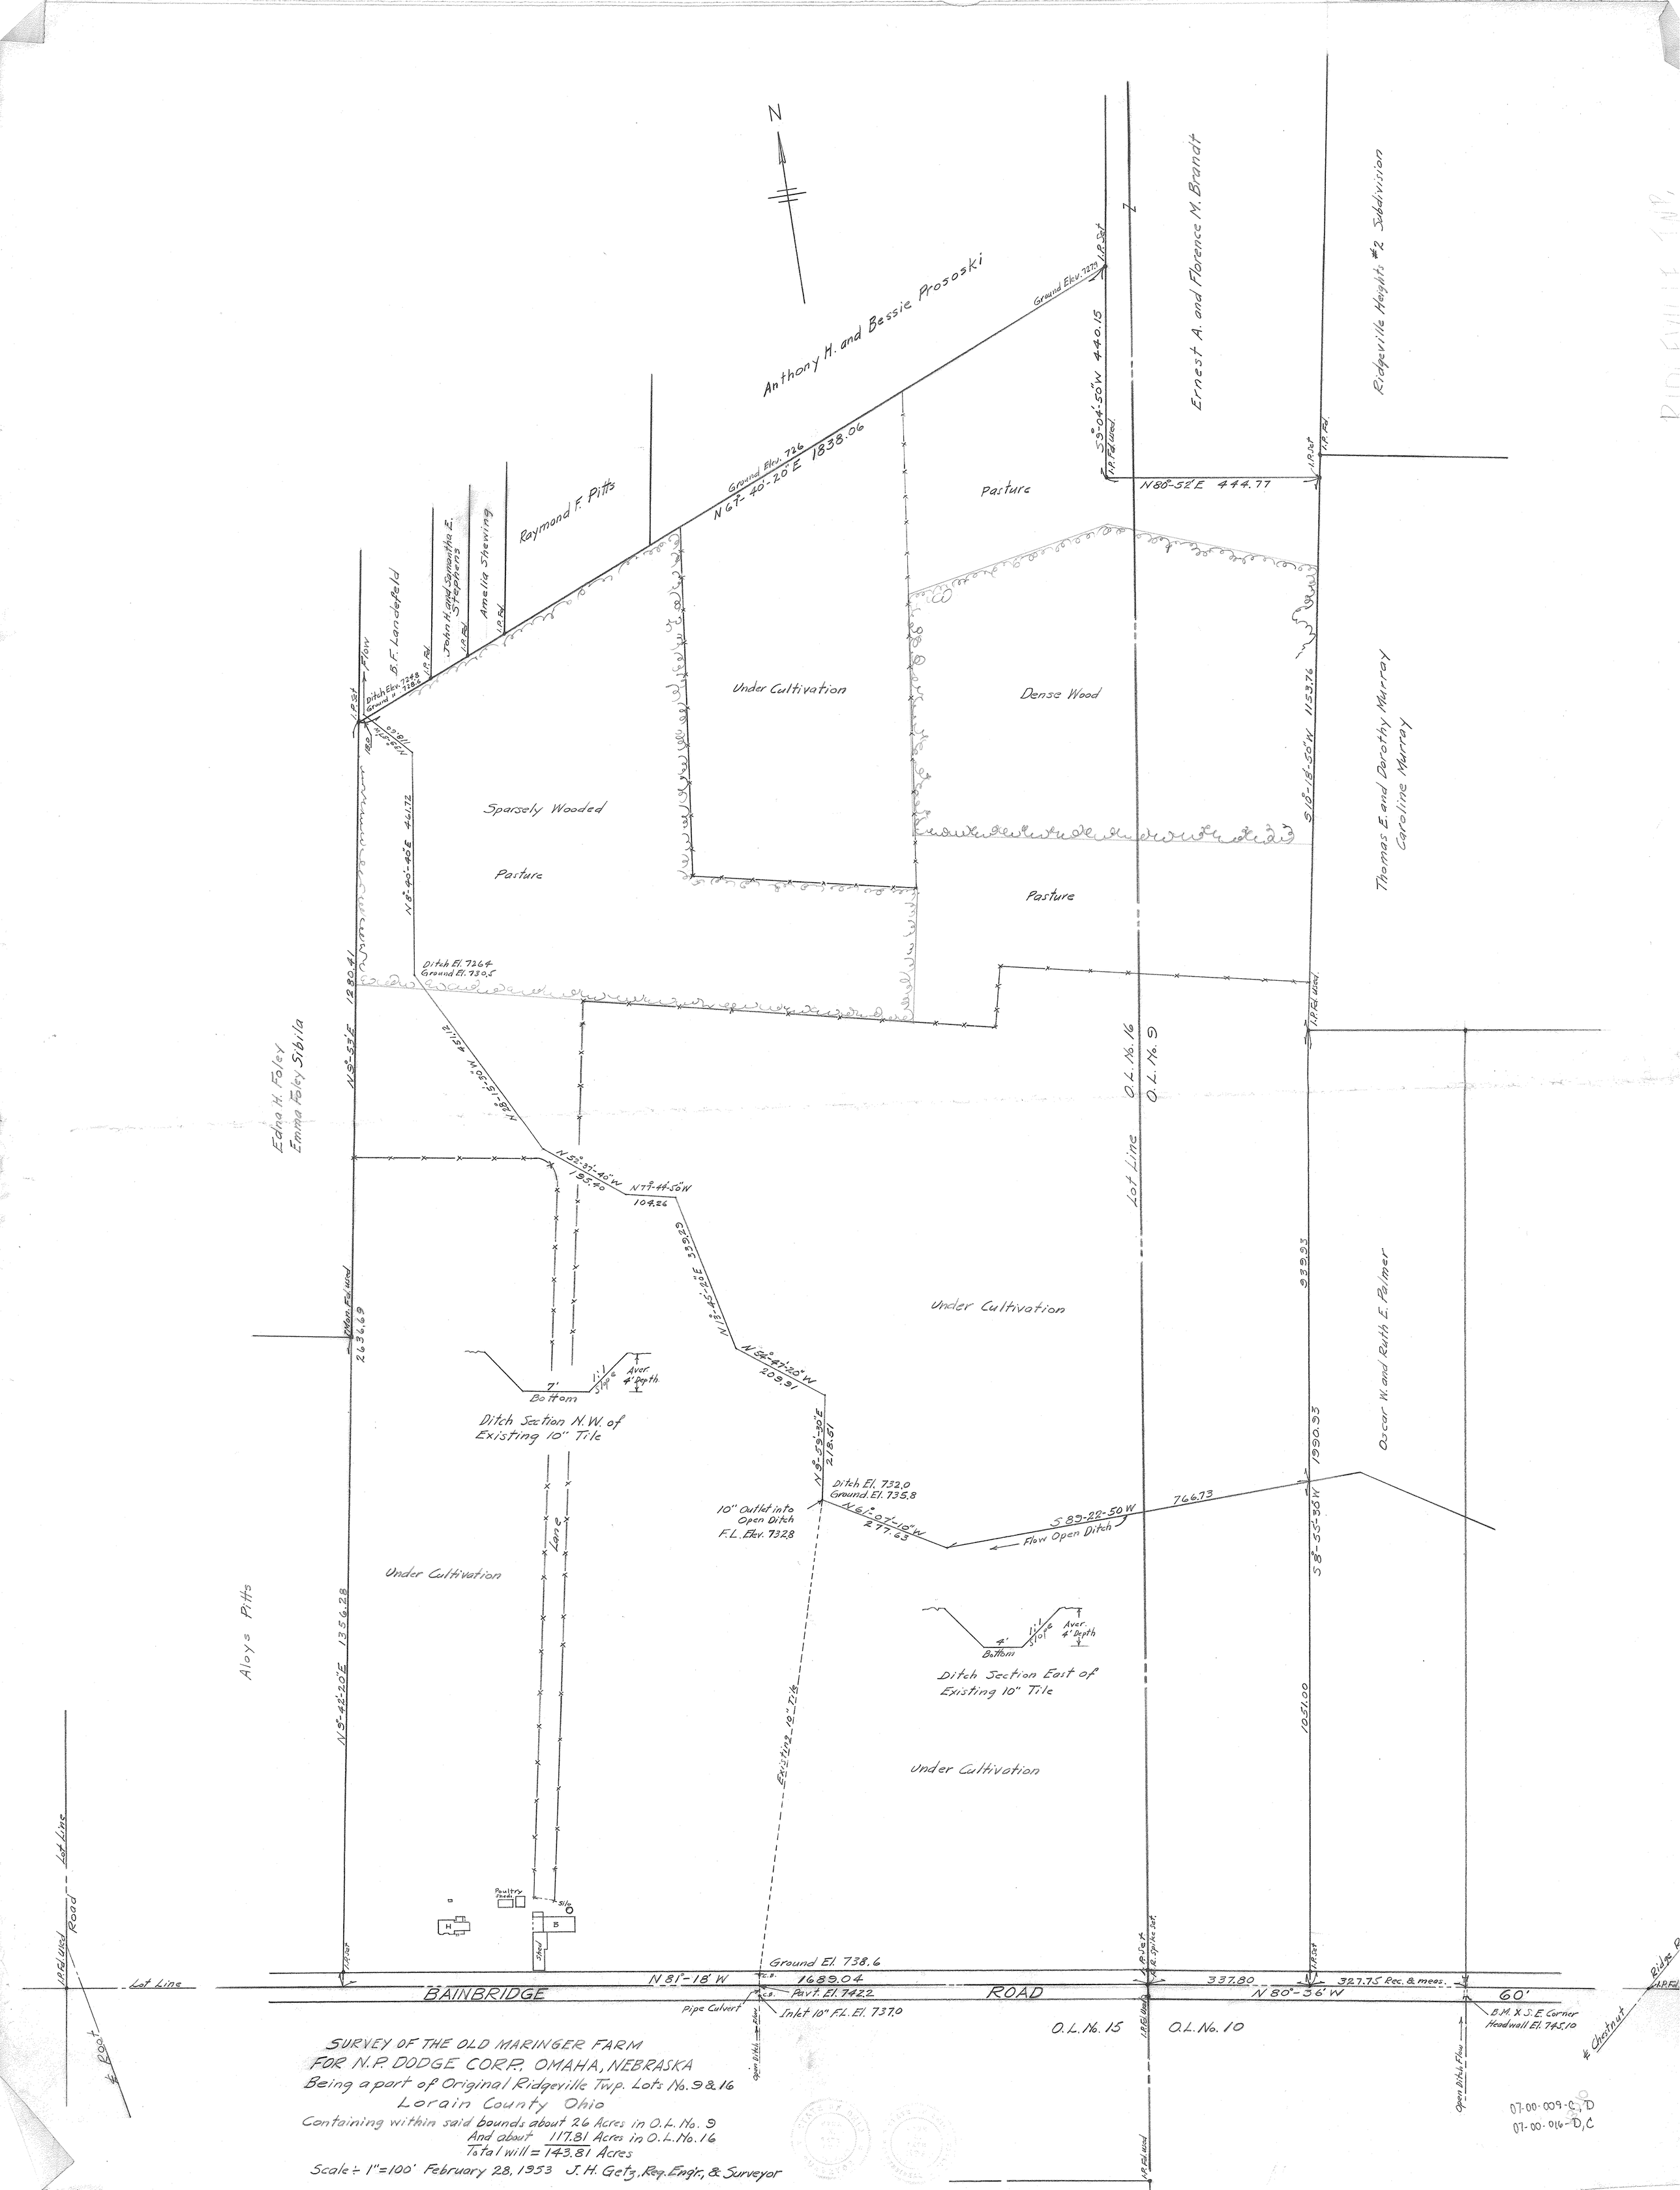

SURVEY OF THE OLD MARINGER FARM
FOR N.P. DODGE CORP., OMAHA, NEBRASKA
Being a part of Original Ridgeville Twp. Lots No. 9 & 16
Lorain County Ohio
Containing within said bounds about 26 Acres in O.L. No. 9
And about 117.81 Acres in O.L. No. 16
Total will = 143.81 Acres
Scale - 1" = 100' February 28, 1953 J. H. Getz, Reg. Engr. & Surveyor