


47084

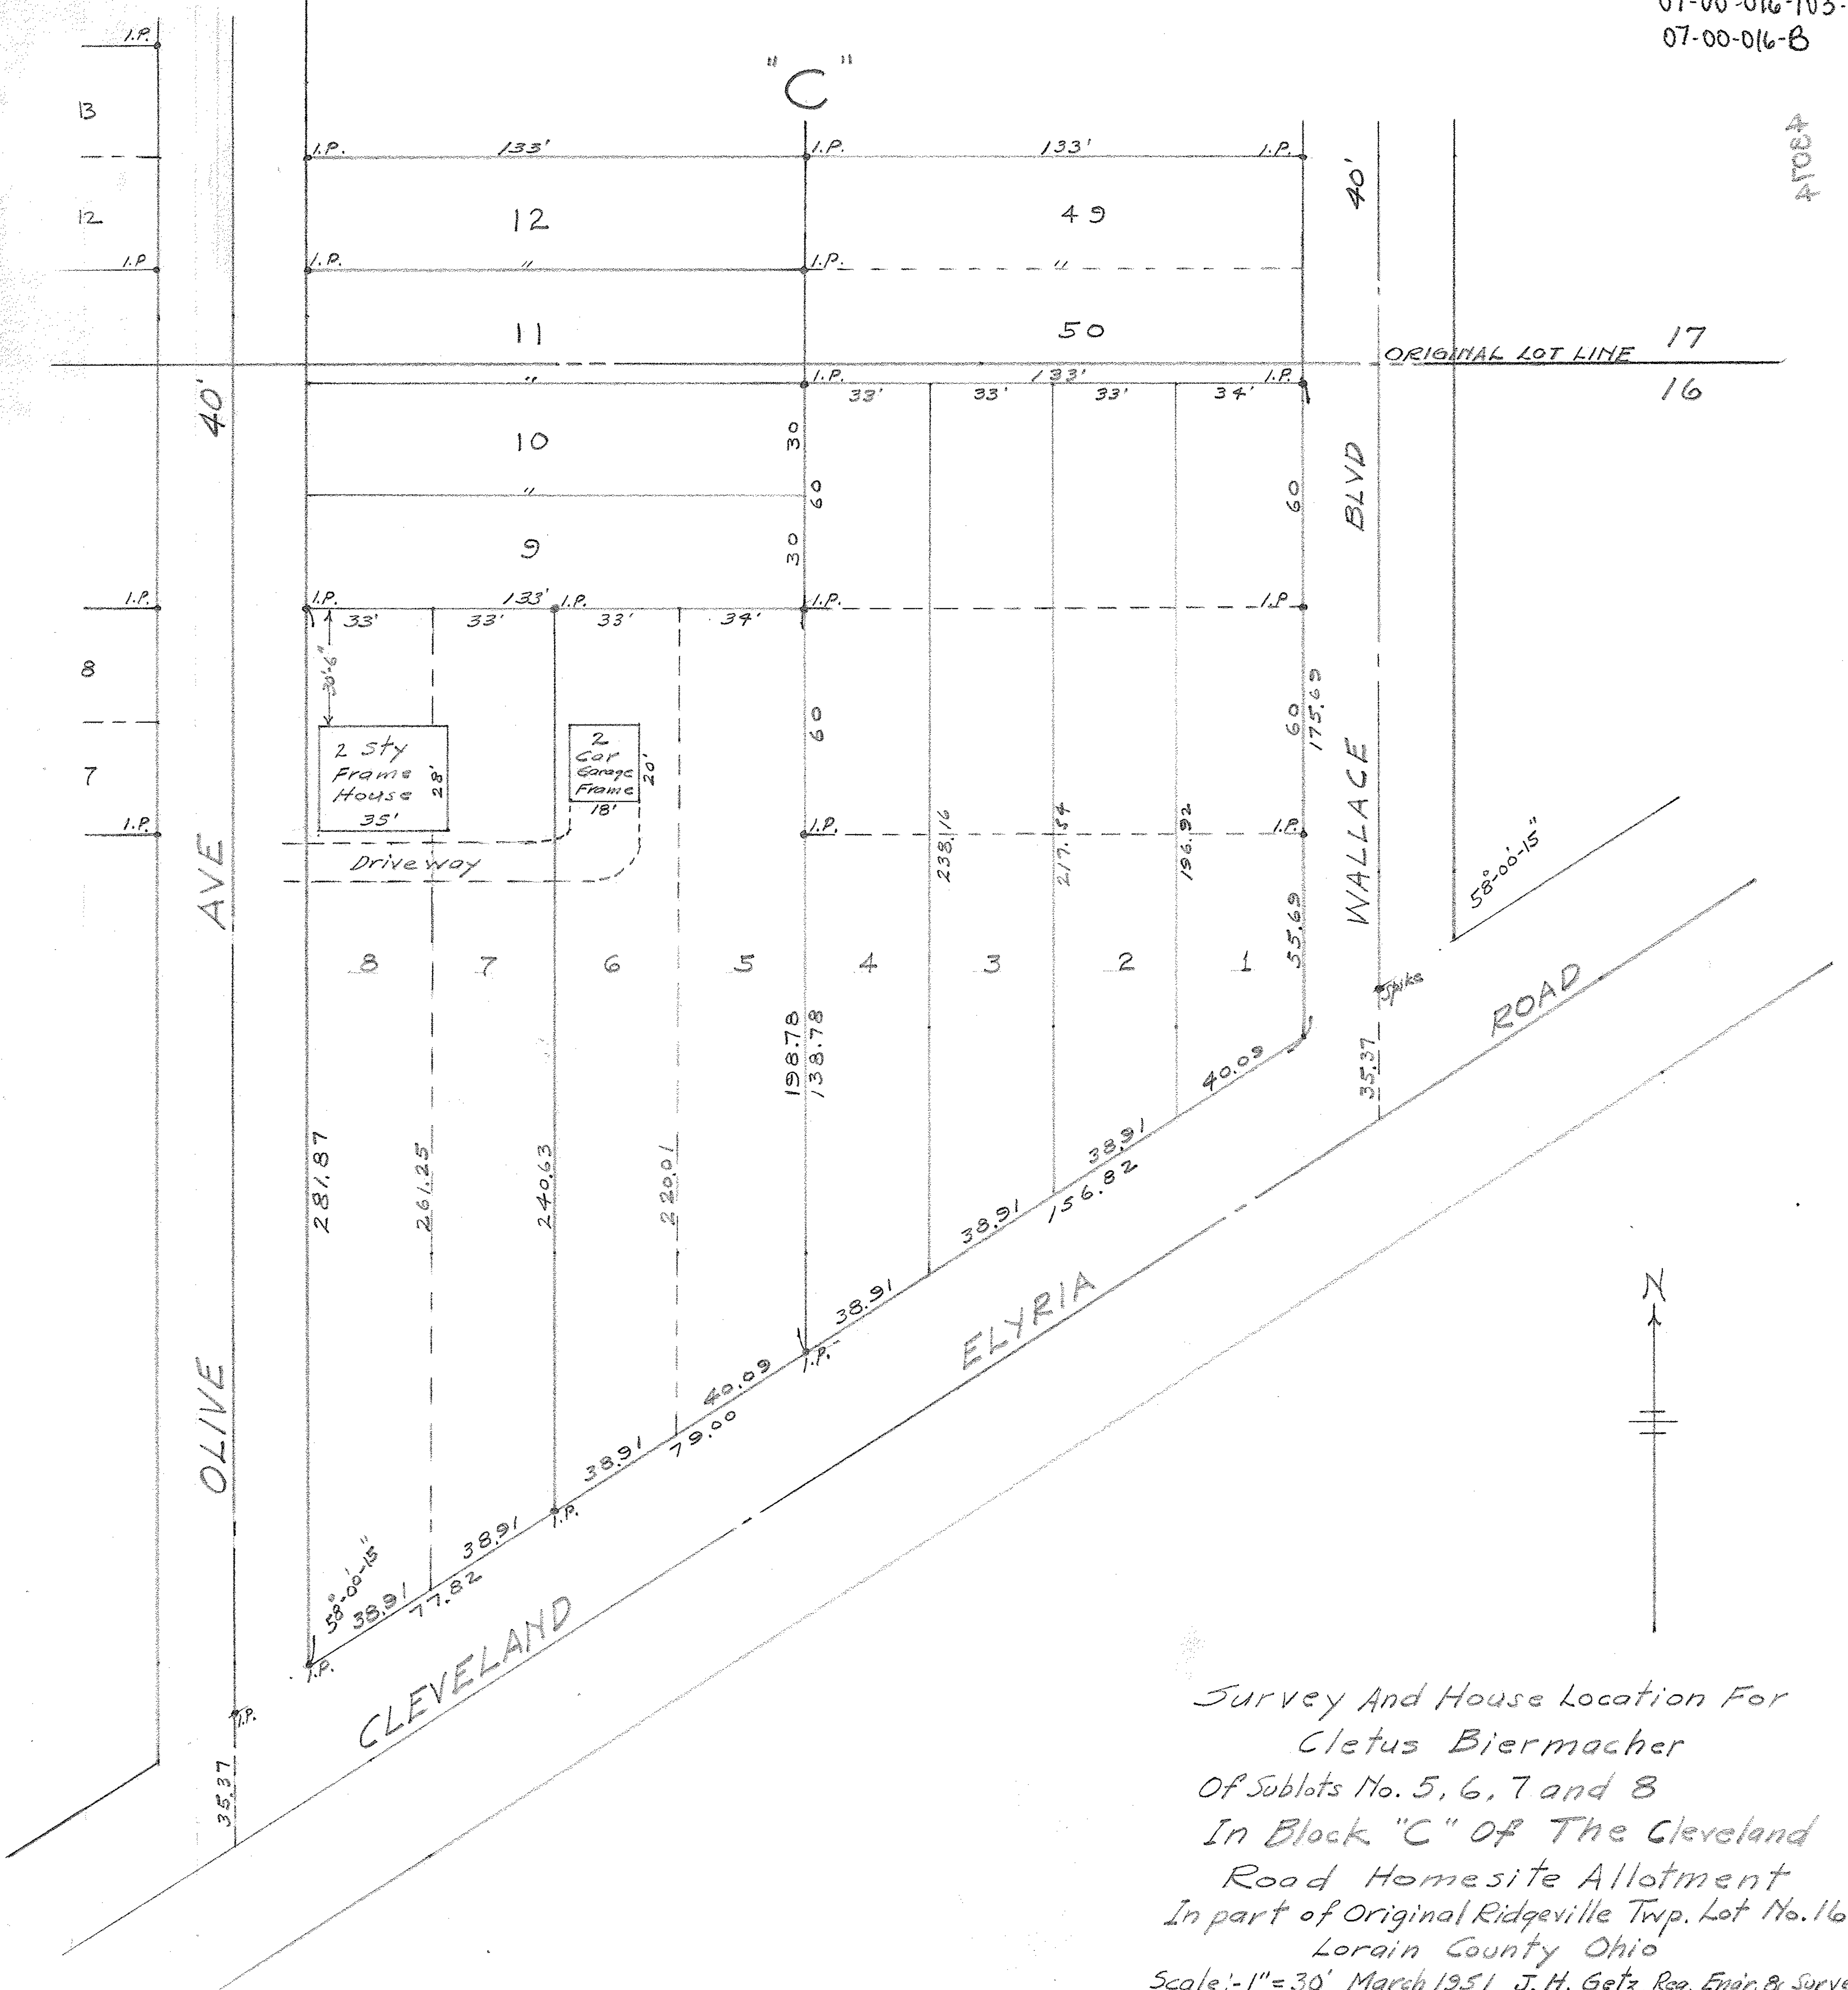

Survey And House Location For
Cletus Biermacher
Of Sublots No. 5, 6, 7 and 8
In Block "C" Of The Cleveland
Road Homesite Allotment
In part of Original Ridgville Twp. Lot No. 16
Lorain County Ohio
Scale: -1"=30' March 1951 J. H. Getz, Reg. Engr. & Surveyor
* I. P. Denotes Iron Pins Found or Set