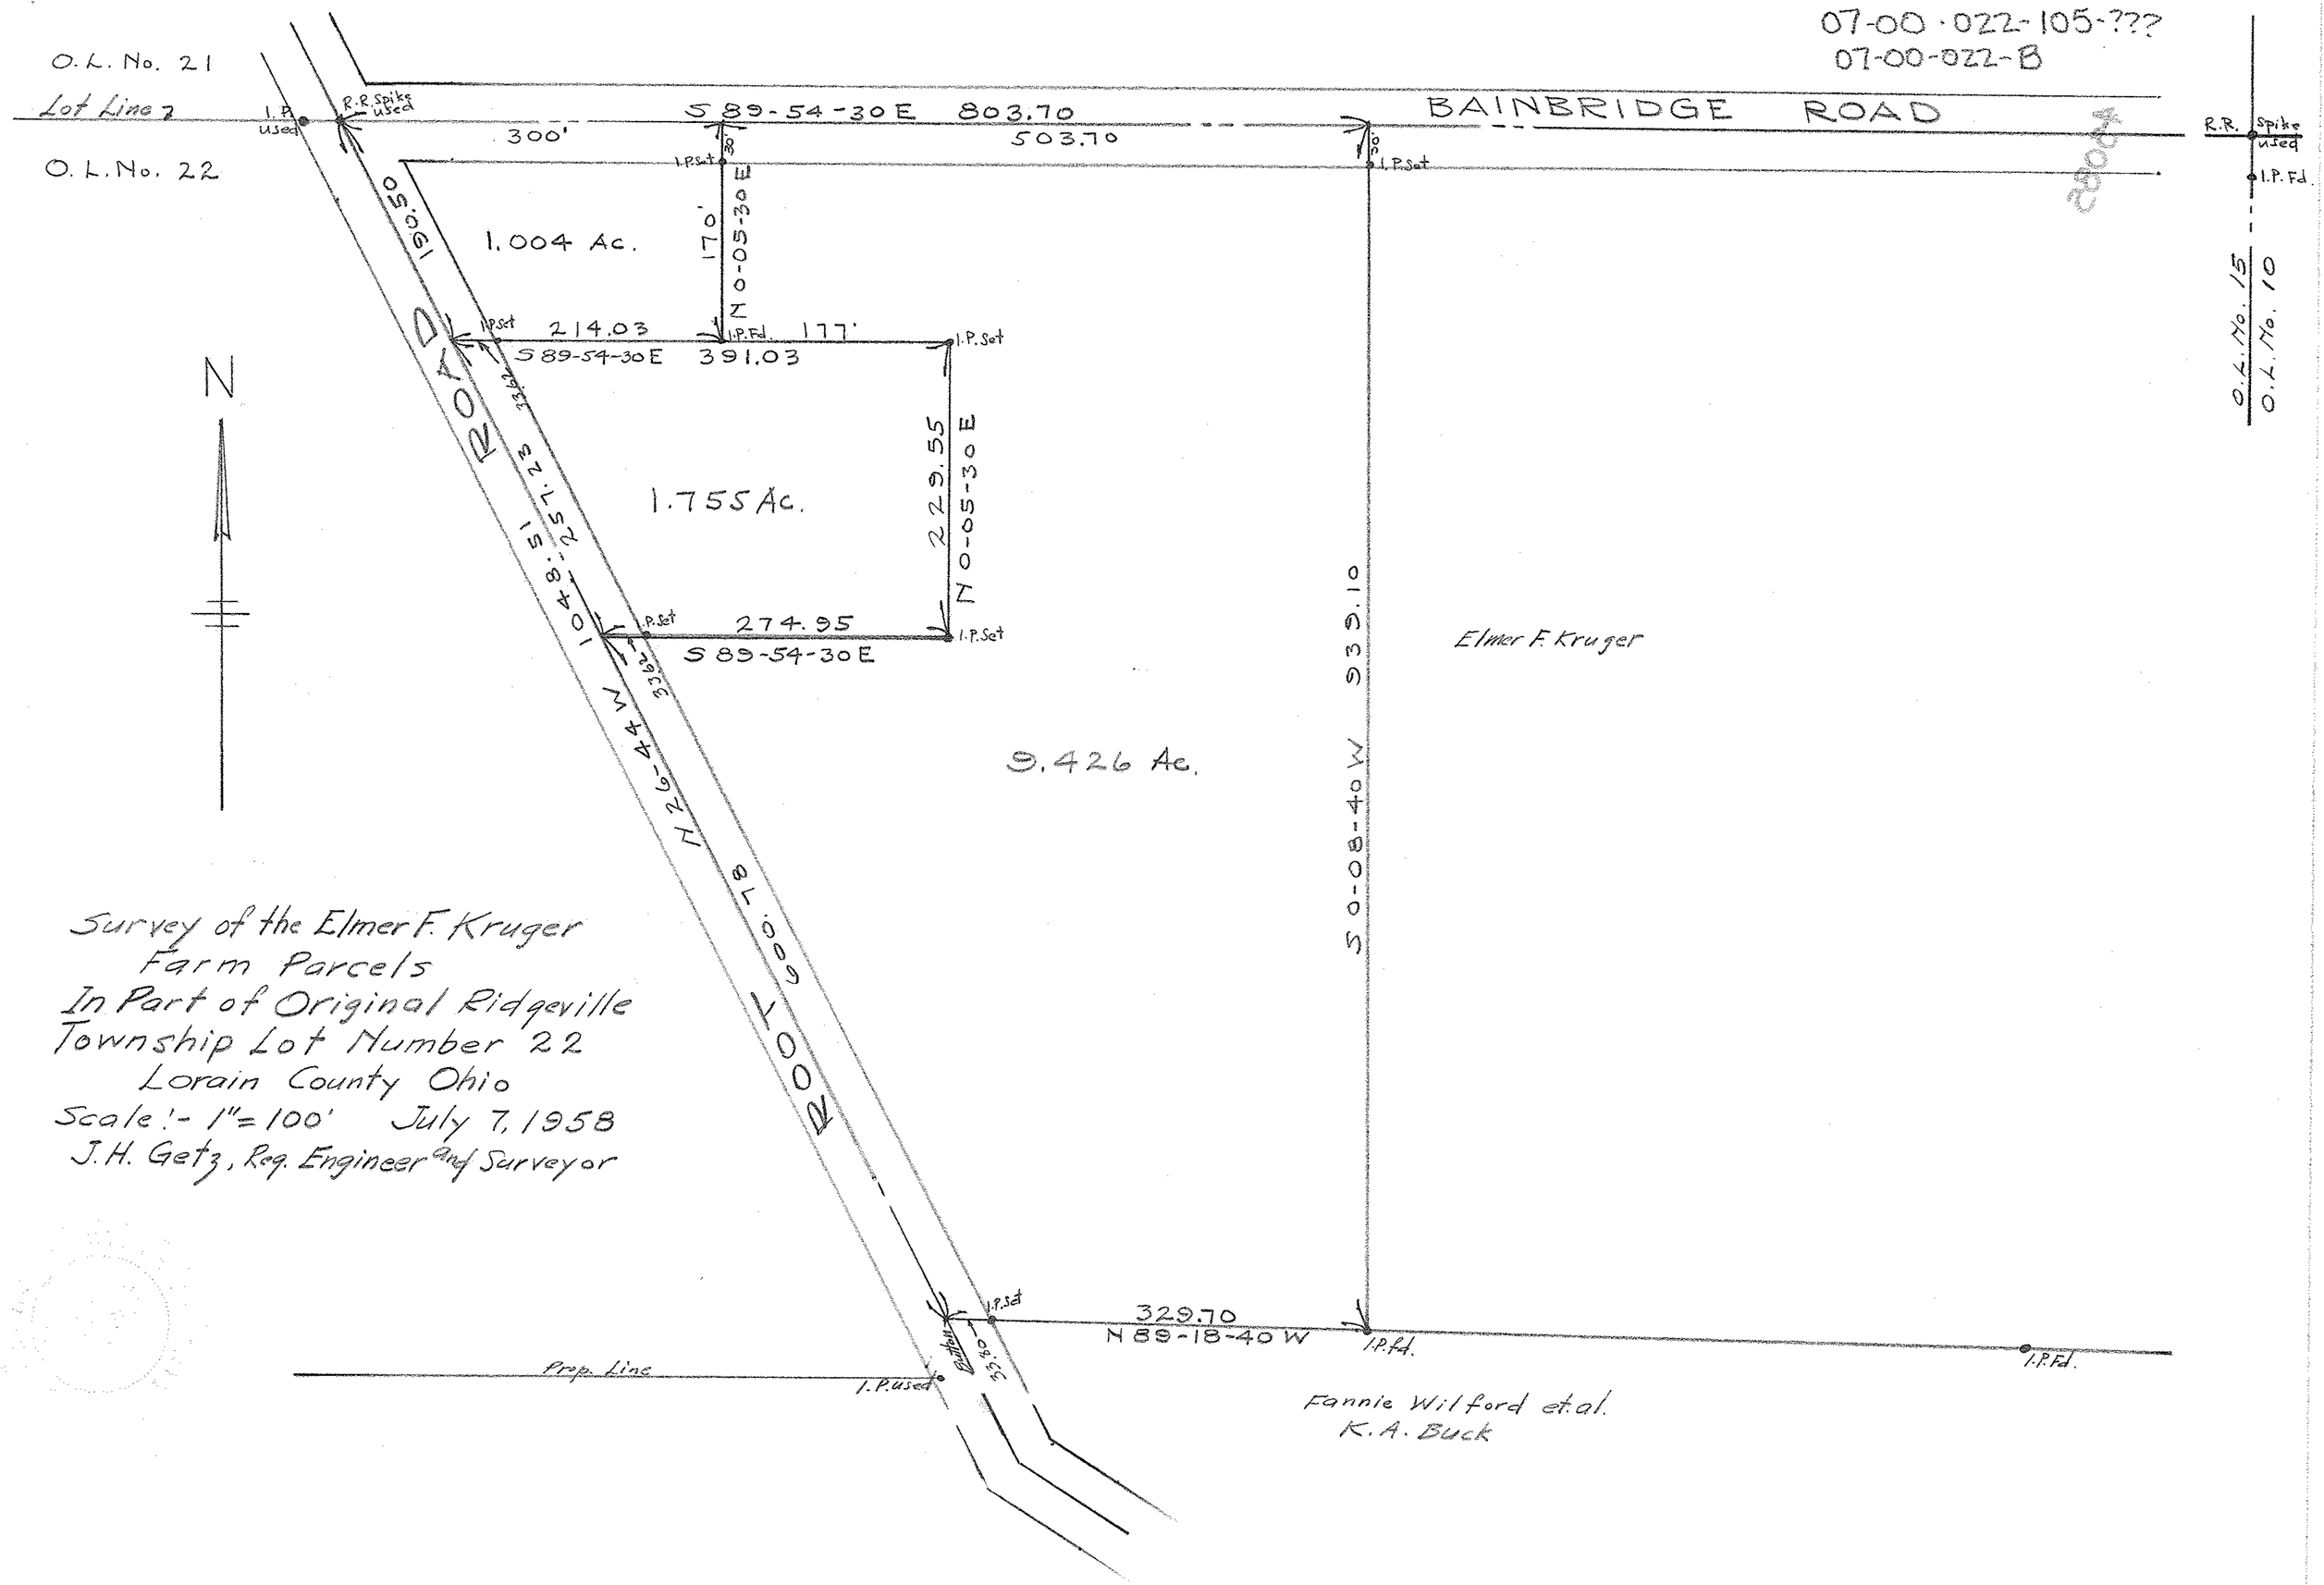
07-00-022-105-???
07-00-022-B
O.L. No. 21
Lot Line
O.L. No. 22
I.P. used
R.R. Spike used
S 89-54-30 E 803.70
BAINBRIDGE ROAD
300'
503.70
I.P. Set
R.R. Spike used
I.P. Fd.
O.L. No. 15
O.L. No. 10
190.50
1.004 Ac.
170'
N 0-05-30 E
214.03
177'
S 89-54-30 E 391.03
I.P. Fd.
I.P. Set
N
ROAD
1048.51
257.23
33.62
1.755 Ac.
229.55
N 0-05-30 E
274.95
S 89-54-30 E
I.P. Set
N 26-44 W
600.78
9.426 Ac.
S 0-08-40 W 939.10
Elmer F. Kruger
Survey of the Elmer F. Kruger
Farm Parcels
In Part of Original Ridgeville
Township Lot Number 22
Lorain County Ohio
Scale:- 1"=100' July 7, 1958
J.H. Getz, Reg. Engineer and Surveyor
I.P. Set
329.70
N 89-18-40 W
I.P. Fd.
I.P. Fd.
Prop. Line
I.P. used
Button
33.80
Fannie Wilford et.al.
K.A. Buck