07-00-021-118-033
034
07-00-021-D

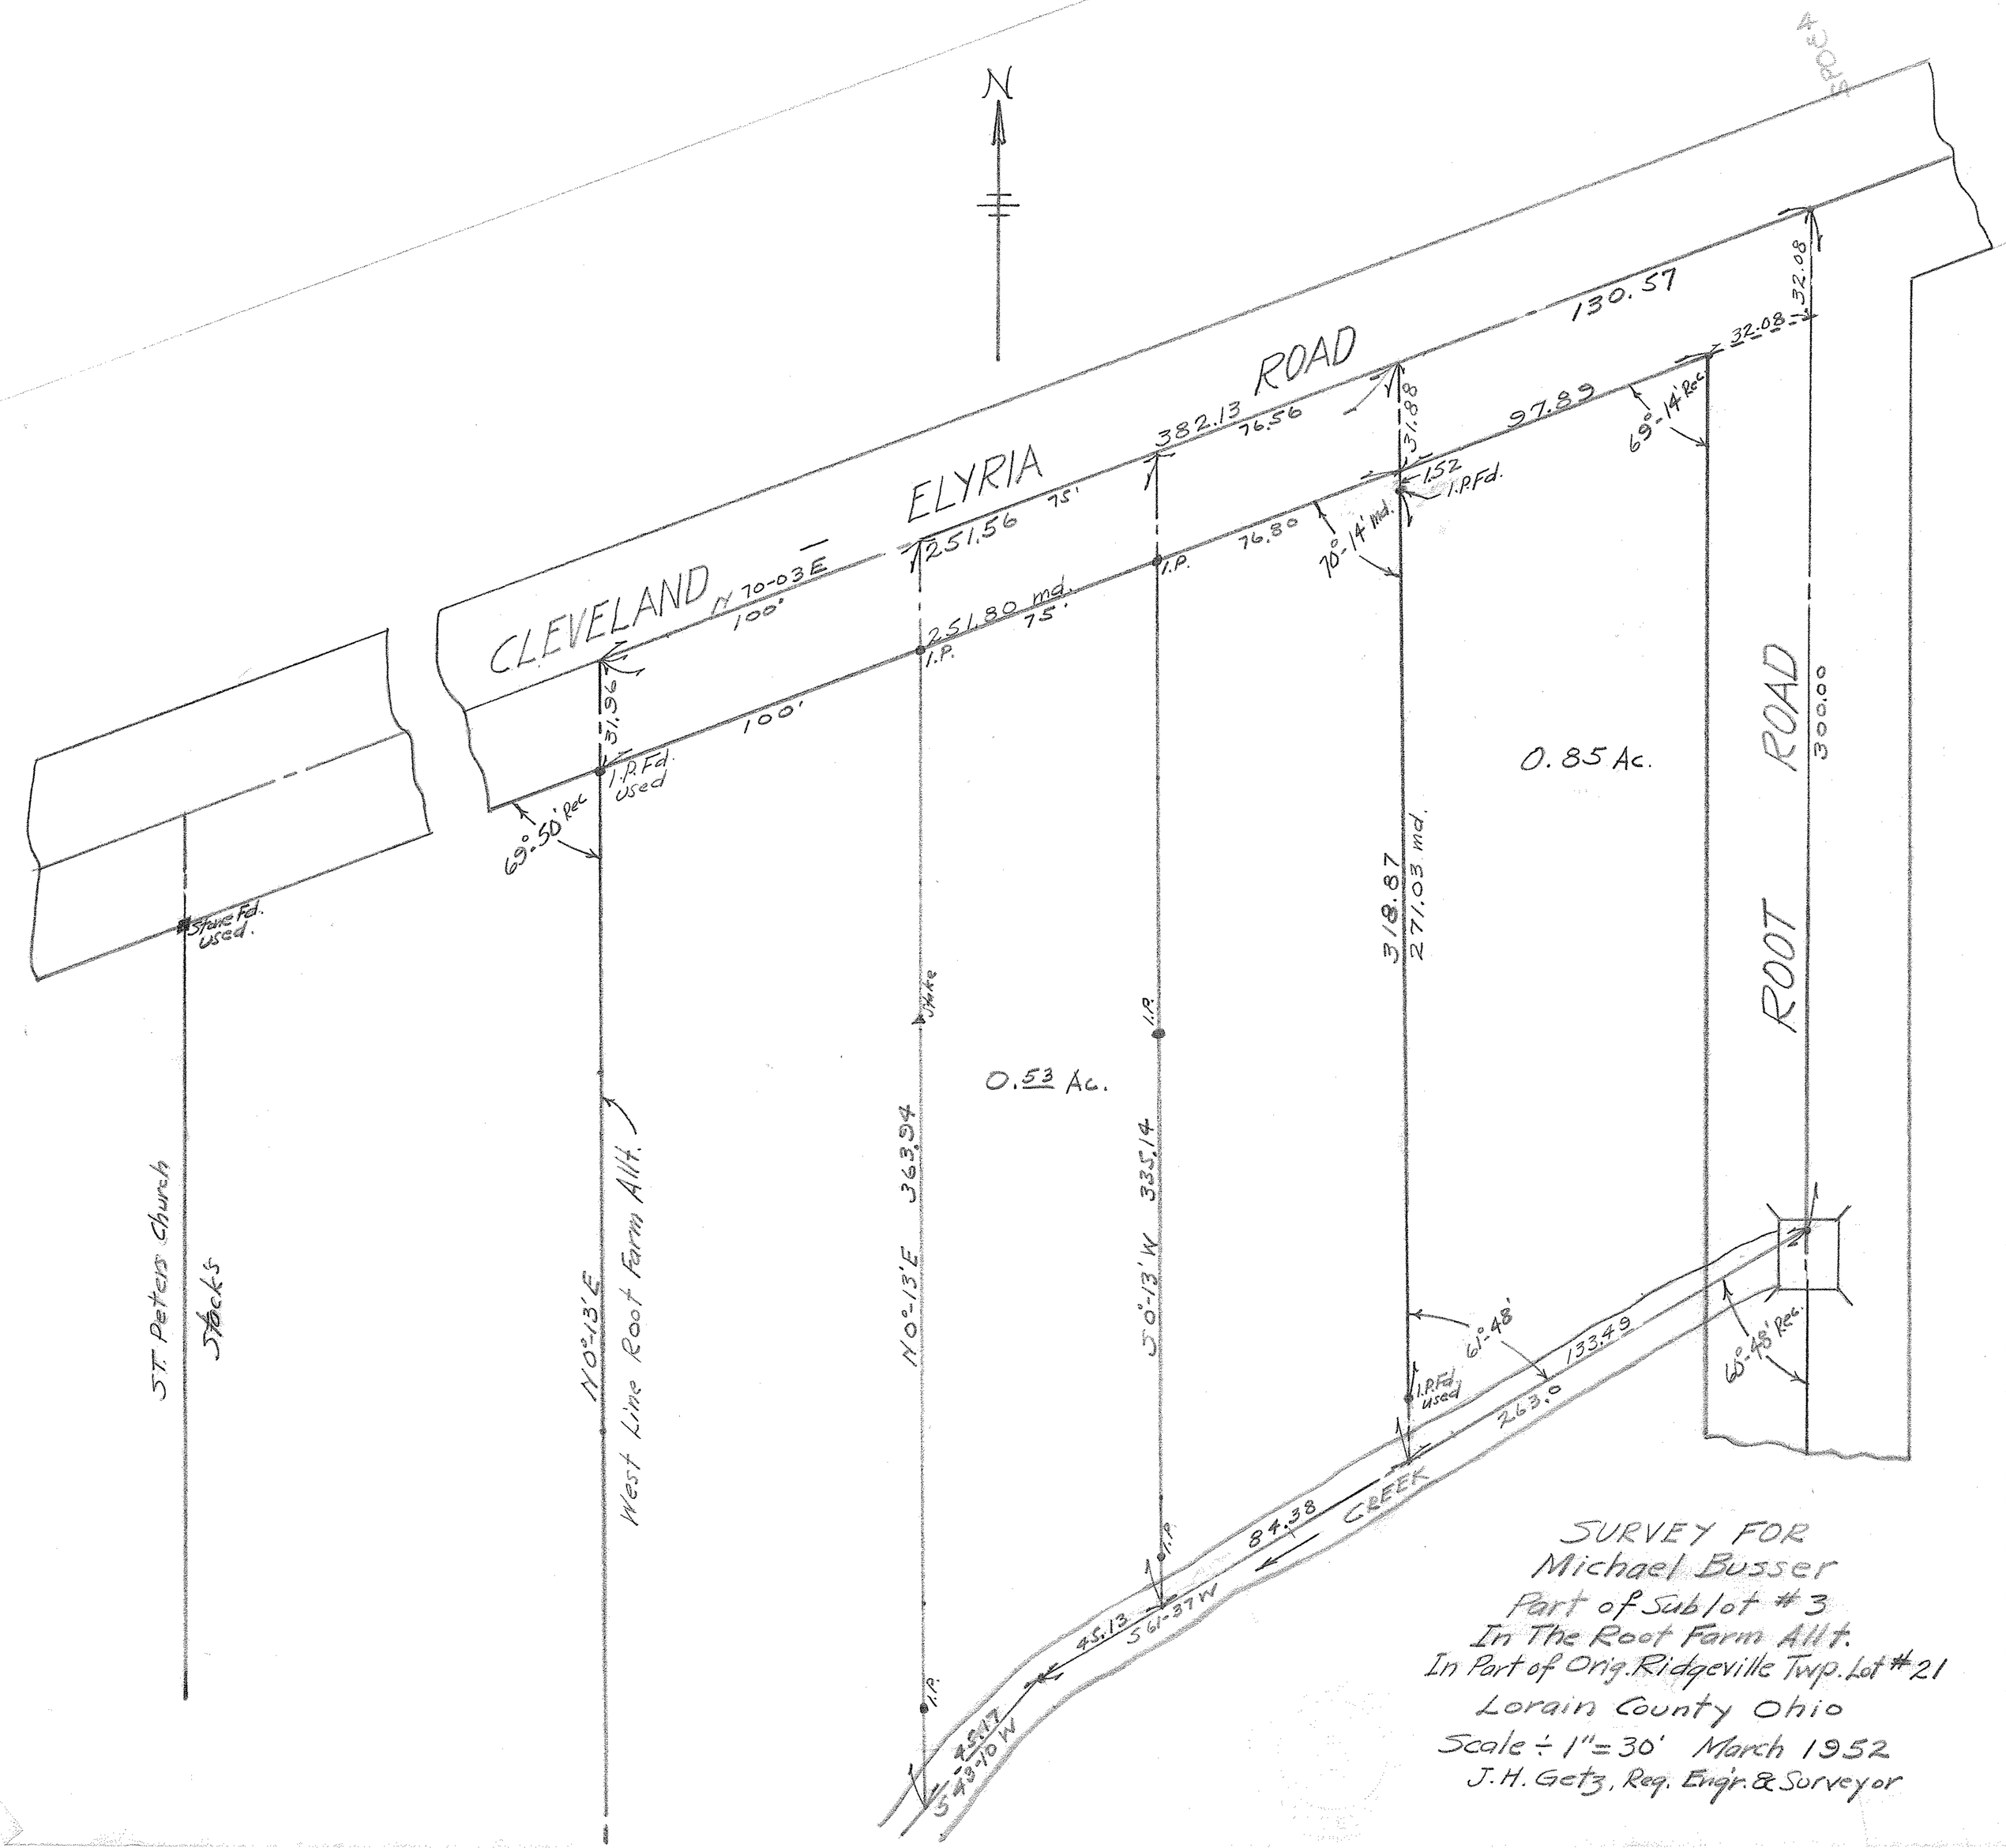

SURVEY FOR
Michael Busser
Part of Sublot #3
In The Root Farm Allt.
In Part of Orig. Ridgeville Twp. Lot #21
Lorain County Ohio
Scale ÷ 1" = 30' March 1952
J. H. Getz, Reg. Engr. & Surveyor