07-00-034-000-???
07-00-034-B

43105

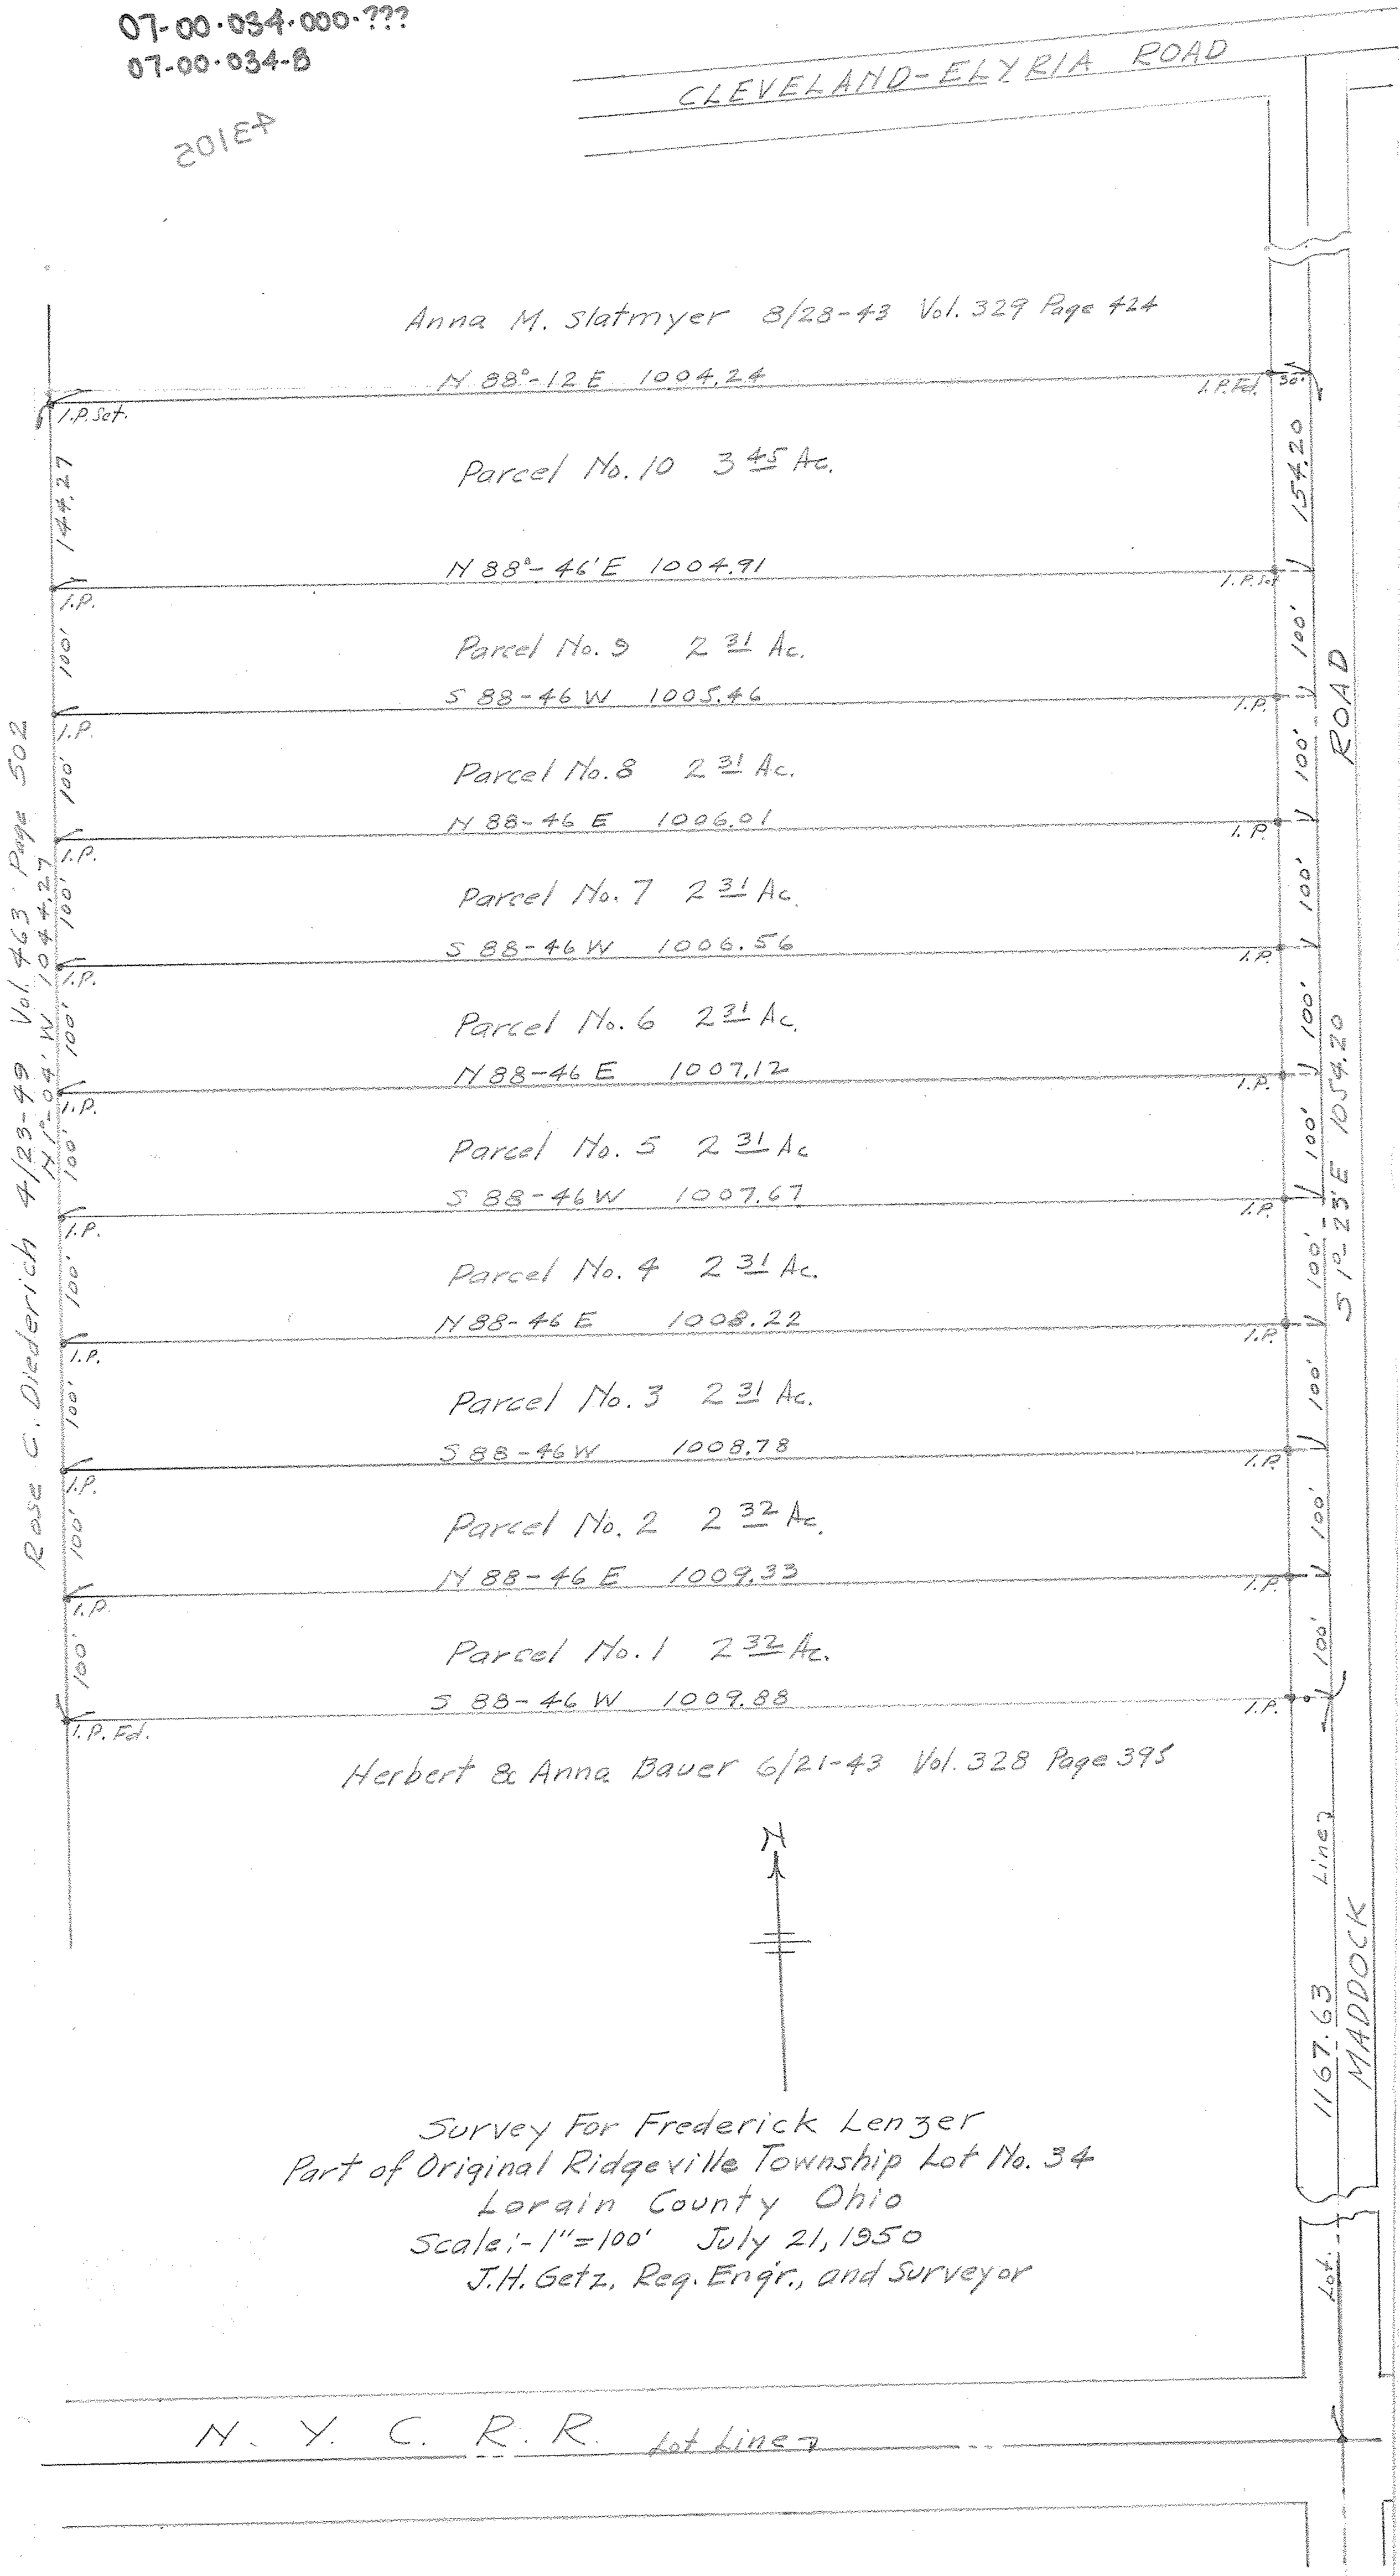

Survey For Frederick Lenzer
Part of Original Ridgeville Township Lot No. 34
Lorain County Ohio
Scale:- 1" = 100' July 21, 1950
J.H. Getz, Reg. Engr., and Surveyor