02-02-016-102-???
V 698 P149.
Vol. 698 P525
02-02-016-A

4311

2-2-16

PART OF OBERLIN AVE. REALTY CO
ADDITION NO. 2. LORAIN OHIO.
RECORDED VOL. 18 PAGE 18.A.
LORAIN CO. RECORD OF PLATS.
COUNTY AUDITOR PLAT.

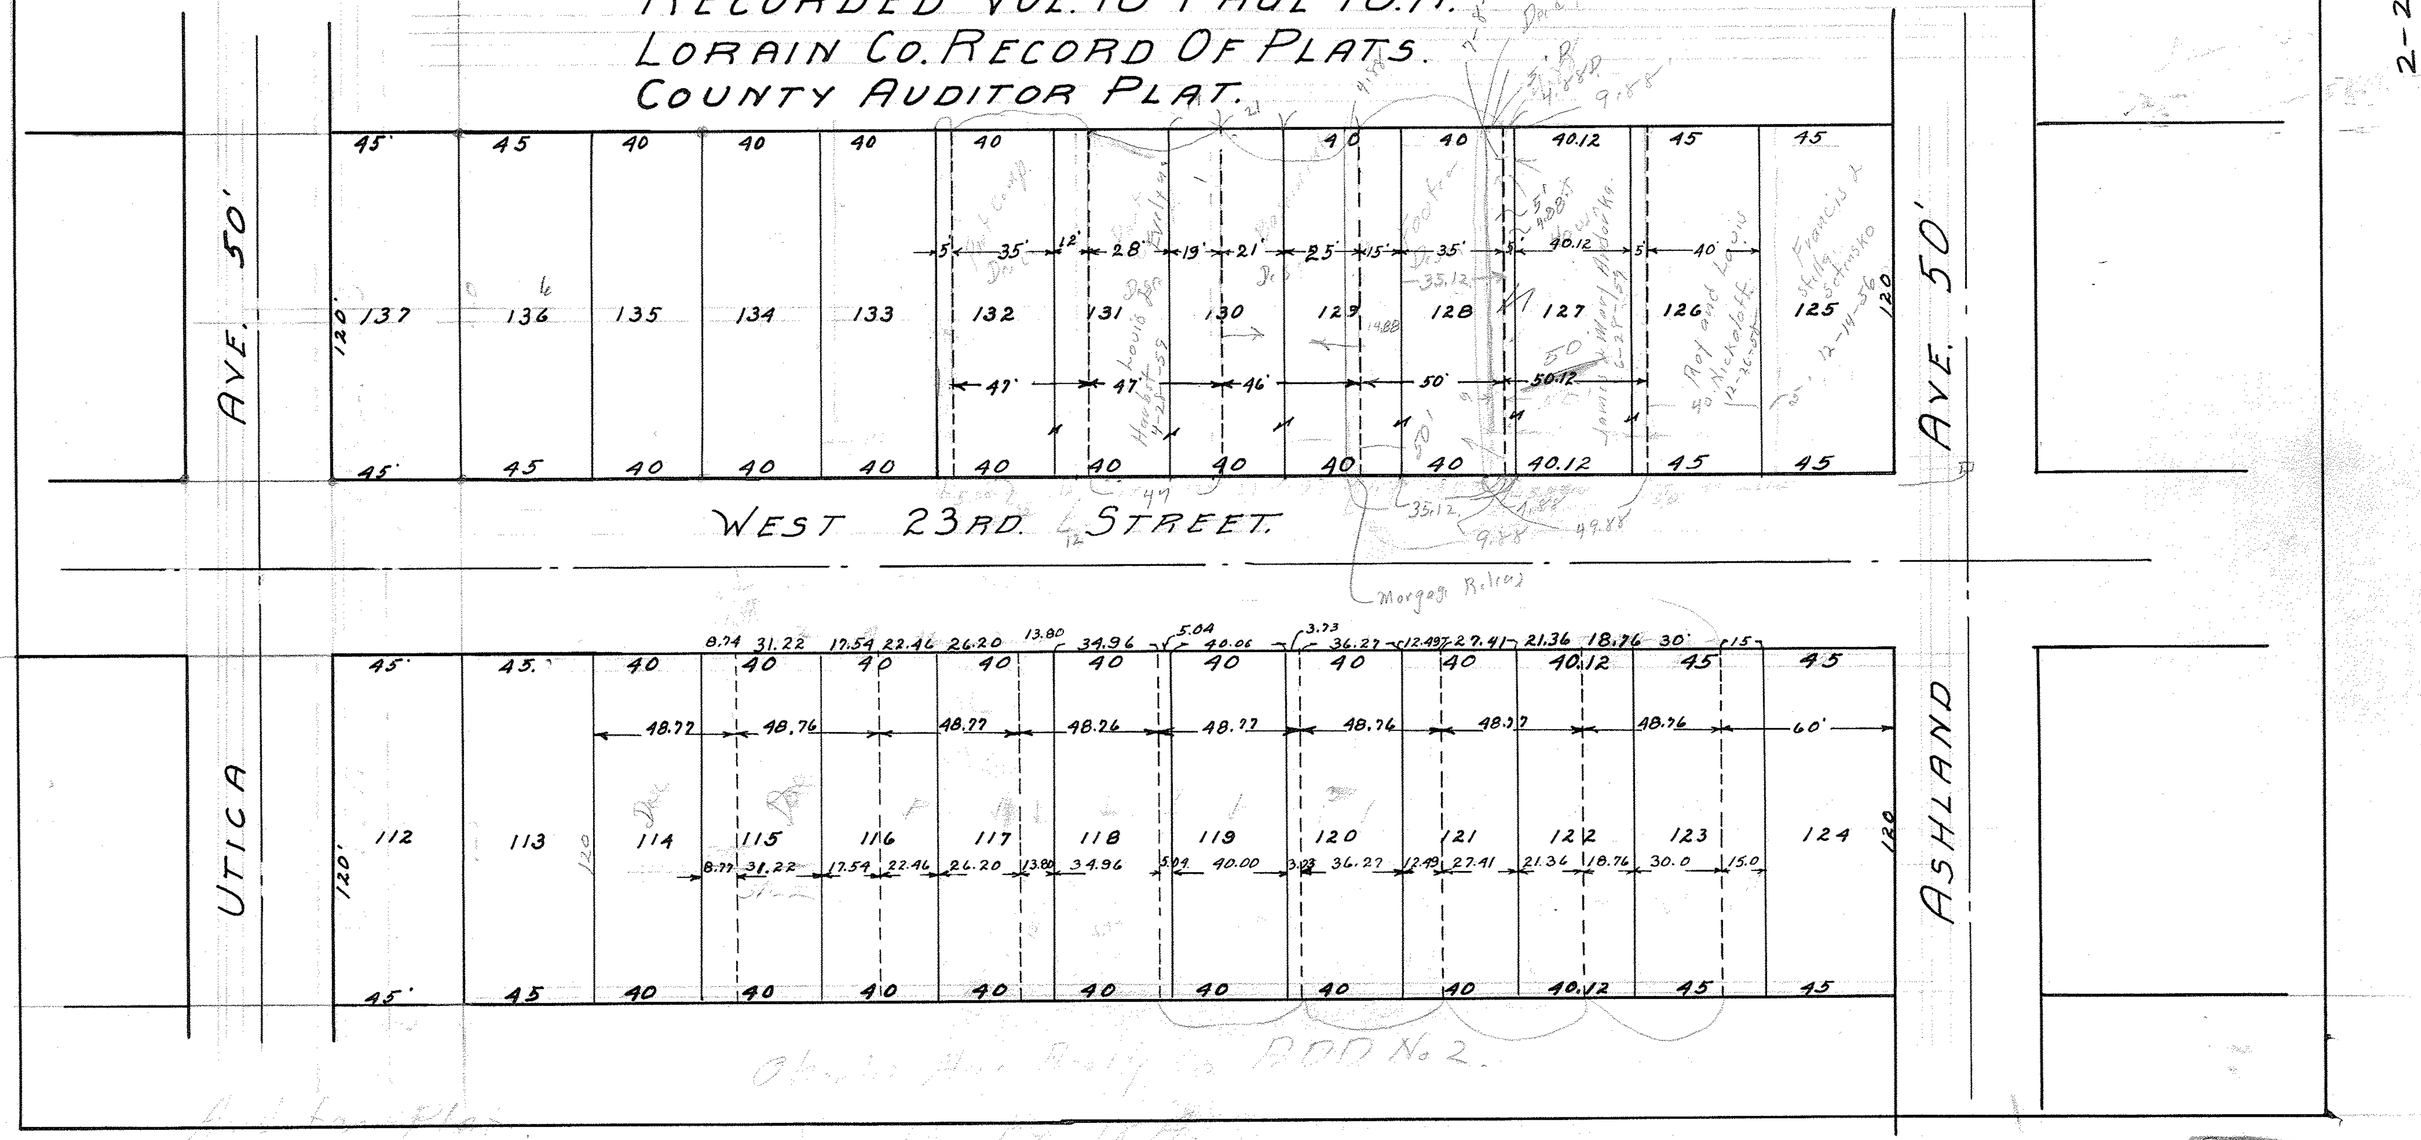

B 2-2-16 (7)

DD P242