02-01-004-105-003 thru -010

02-01-004-A

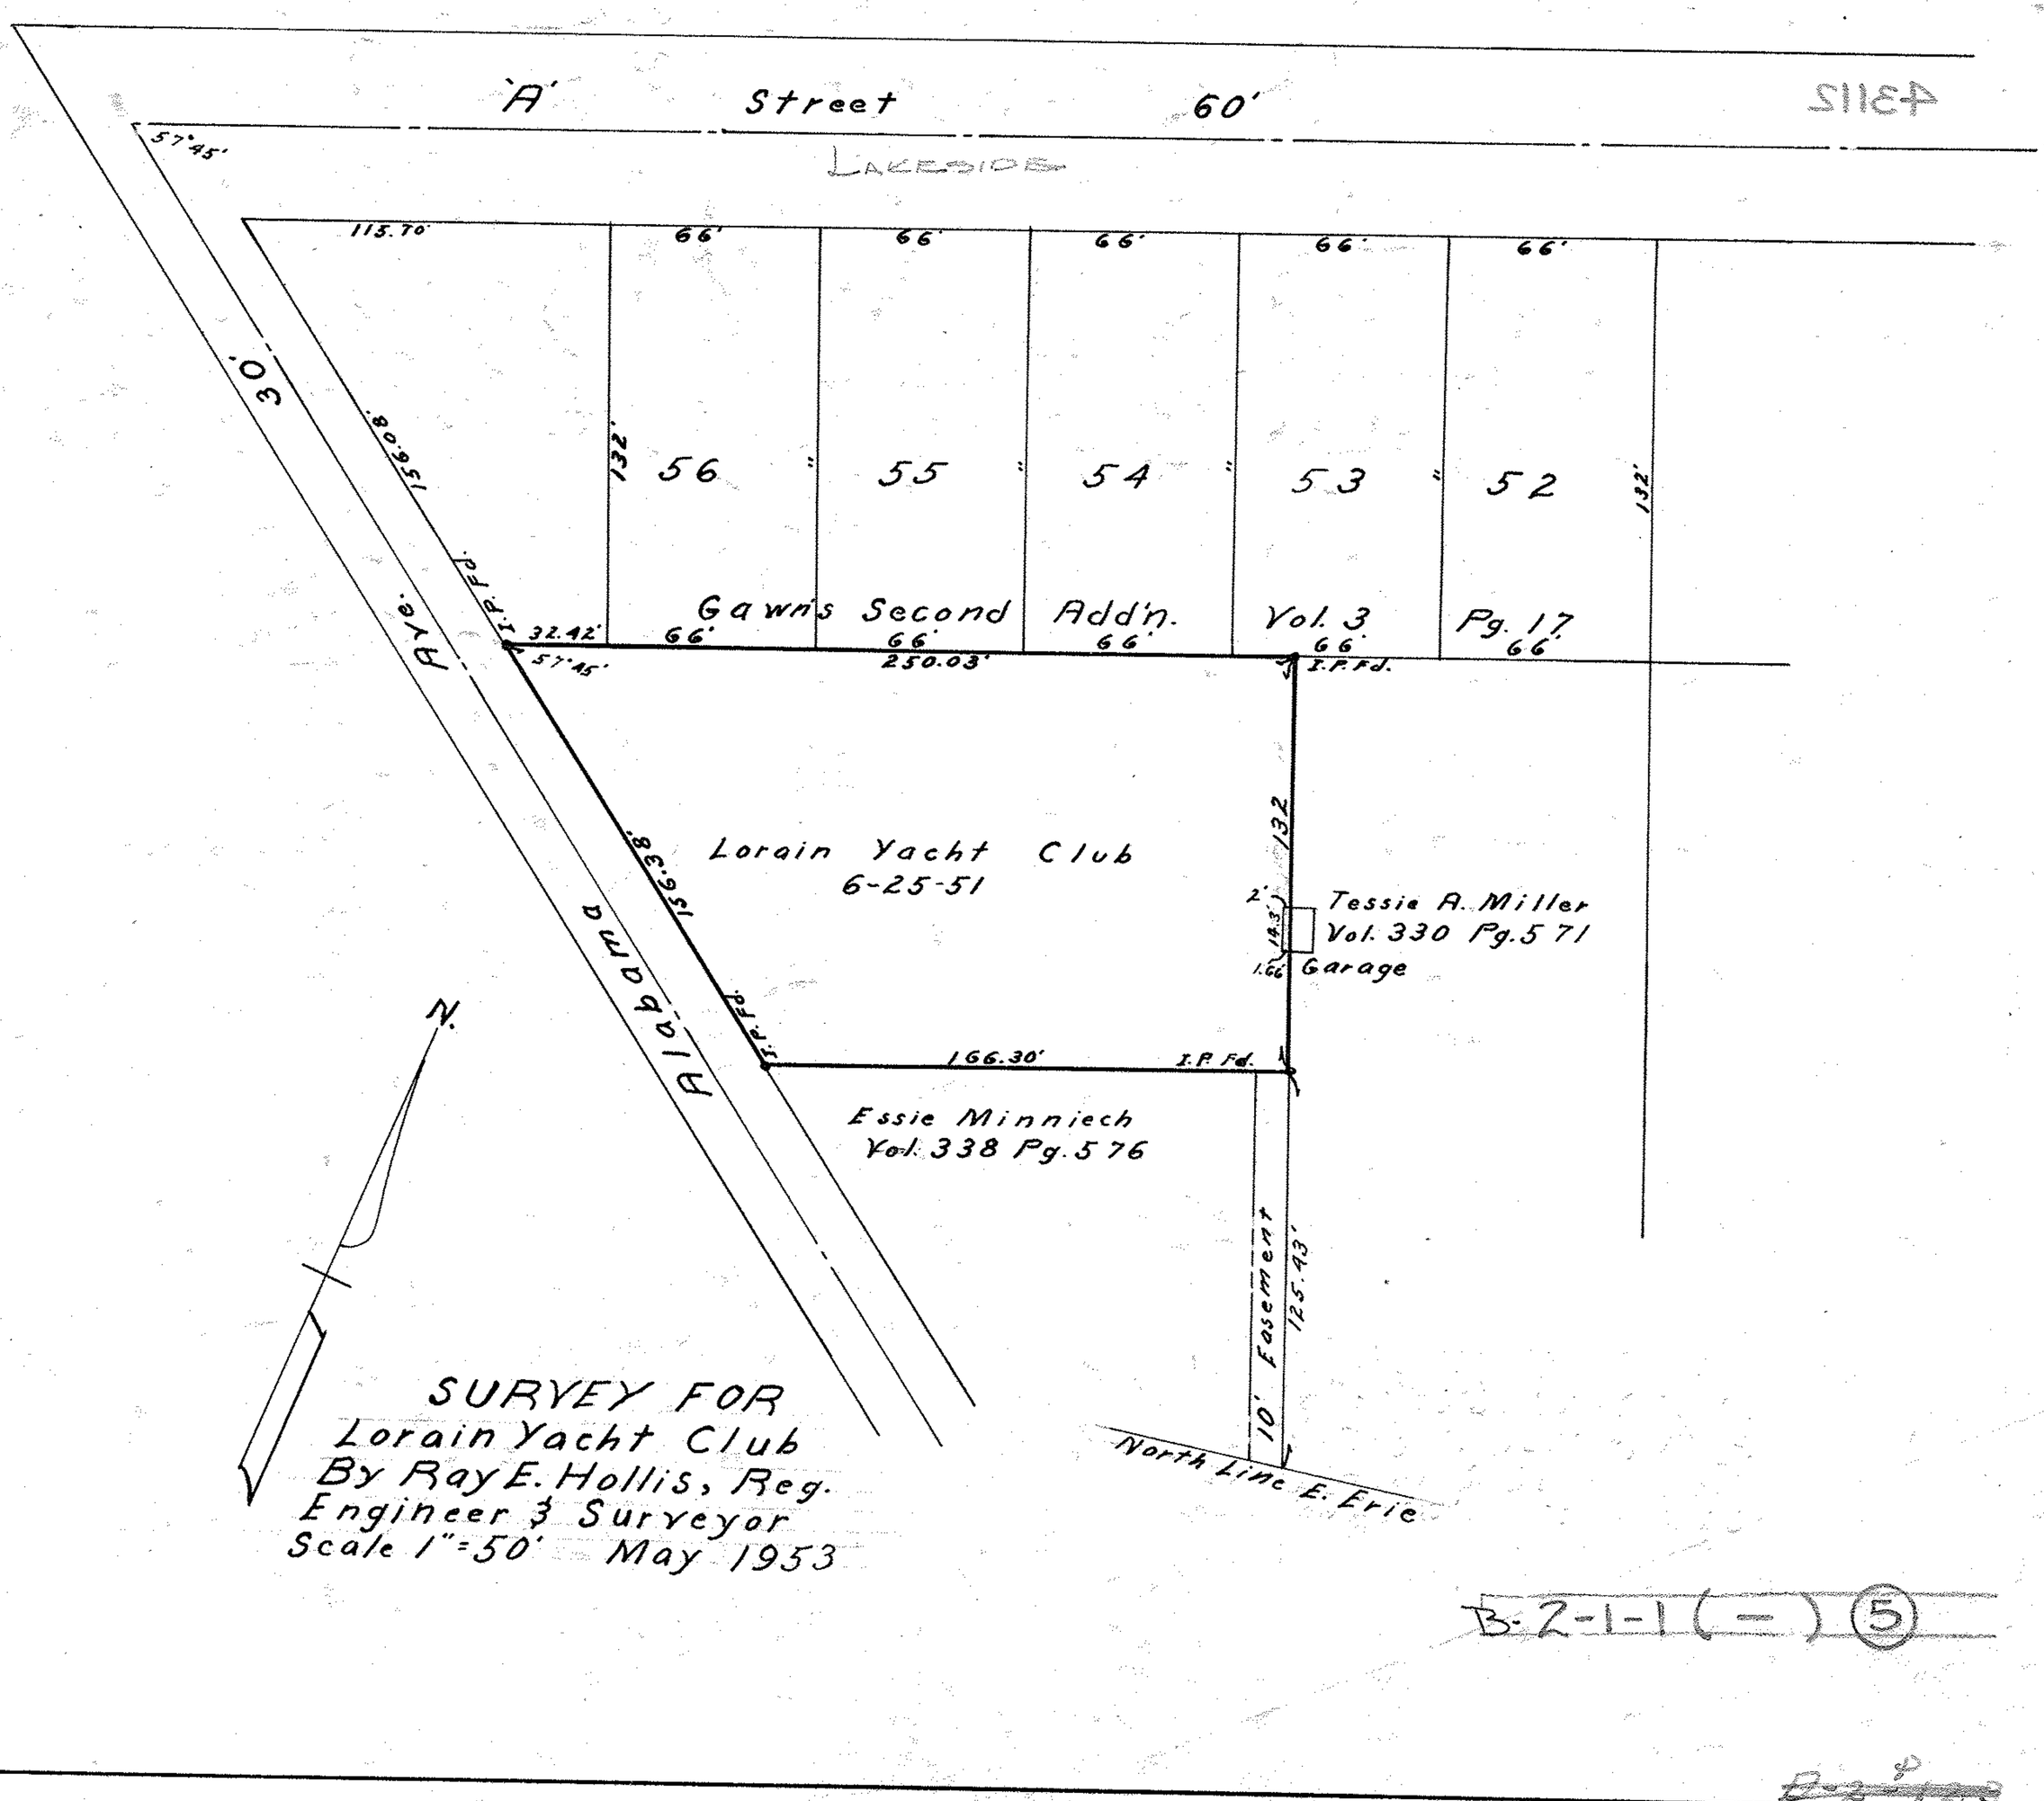

SURVEY FOR
Lorain Yacht Club
By Ray E. Hollis, Reg.
Engineer & Surveyor
Scale 1"=50' May 1953

B. 2-1-1 (-) (5)