03-00-100-108-001
034
035
03-00-100-A

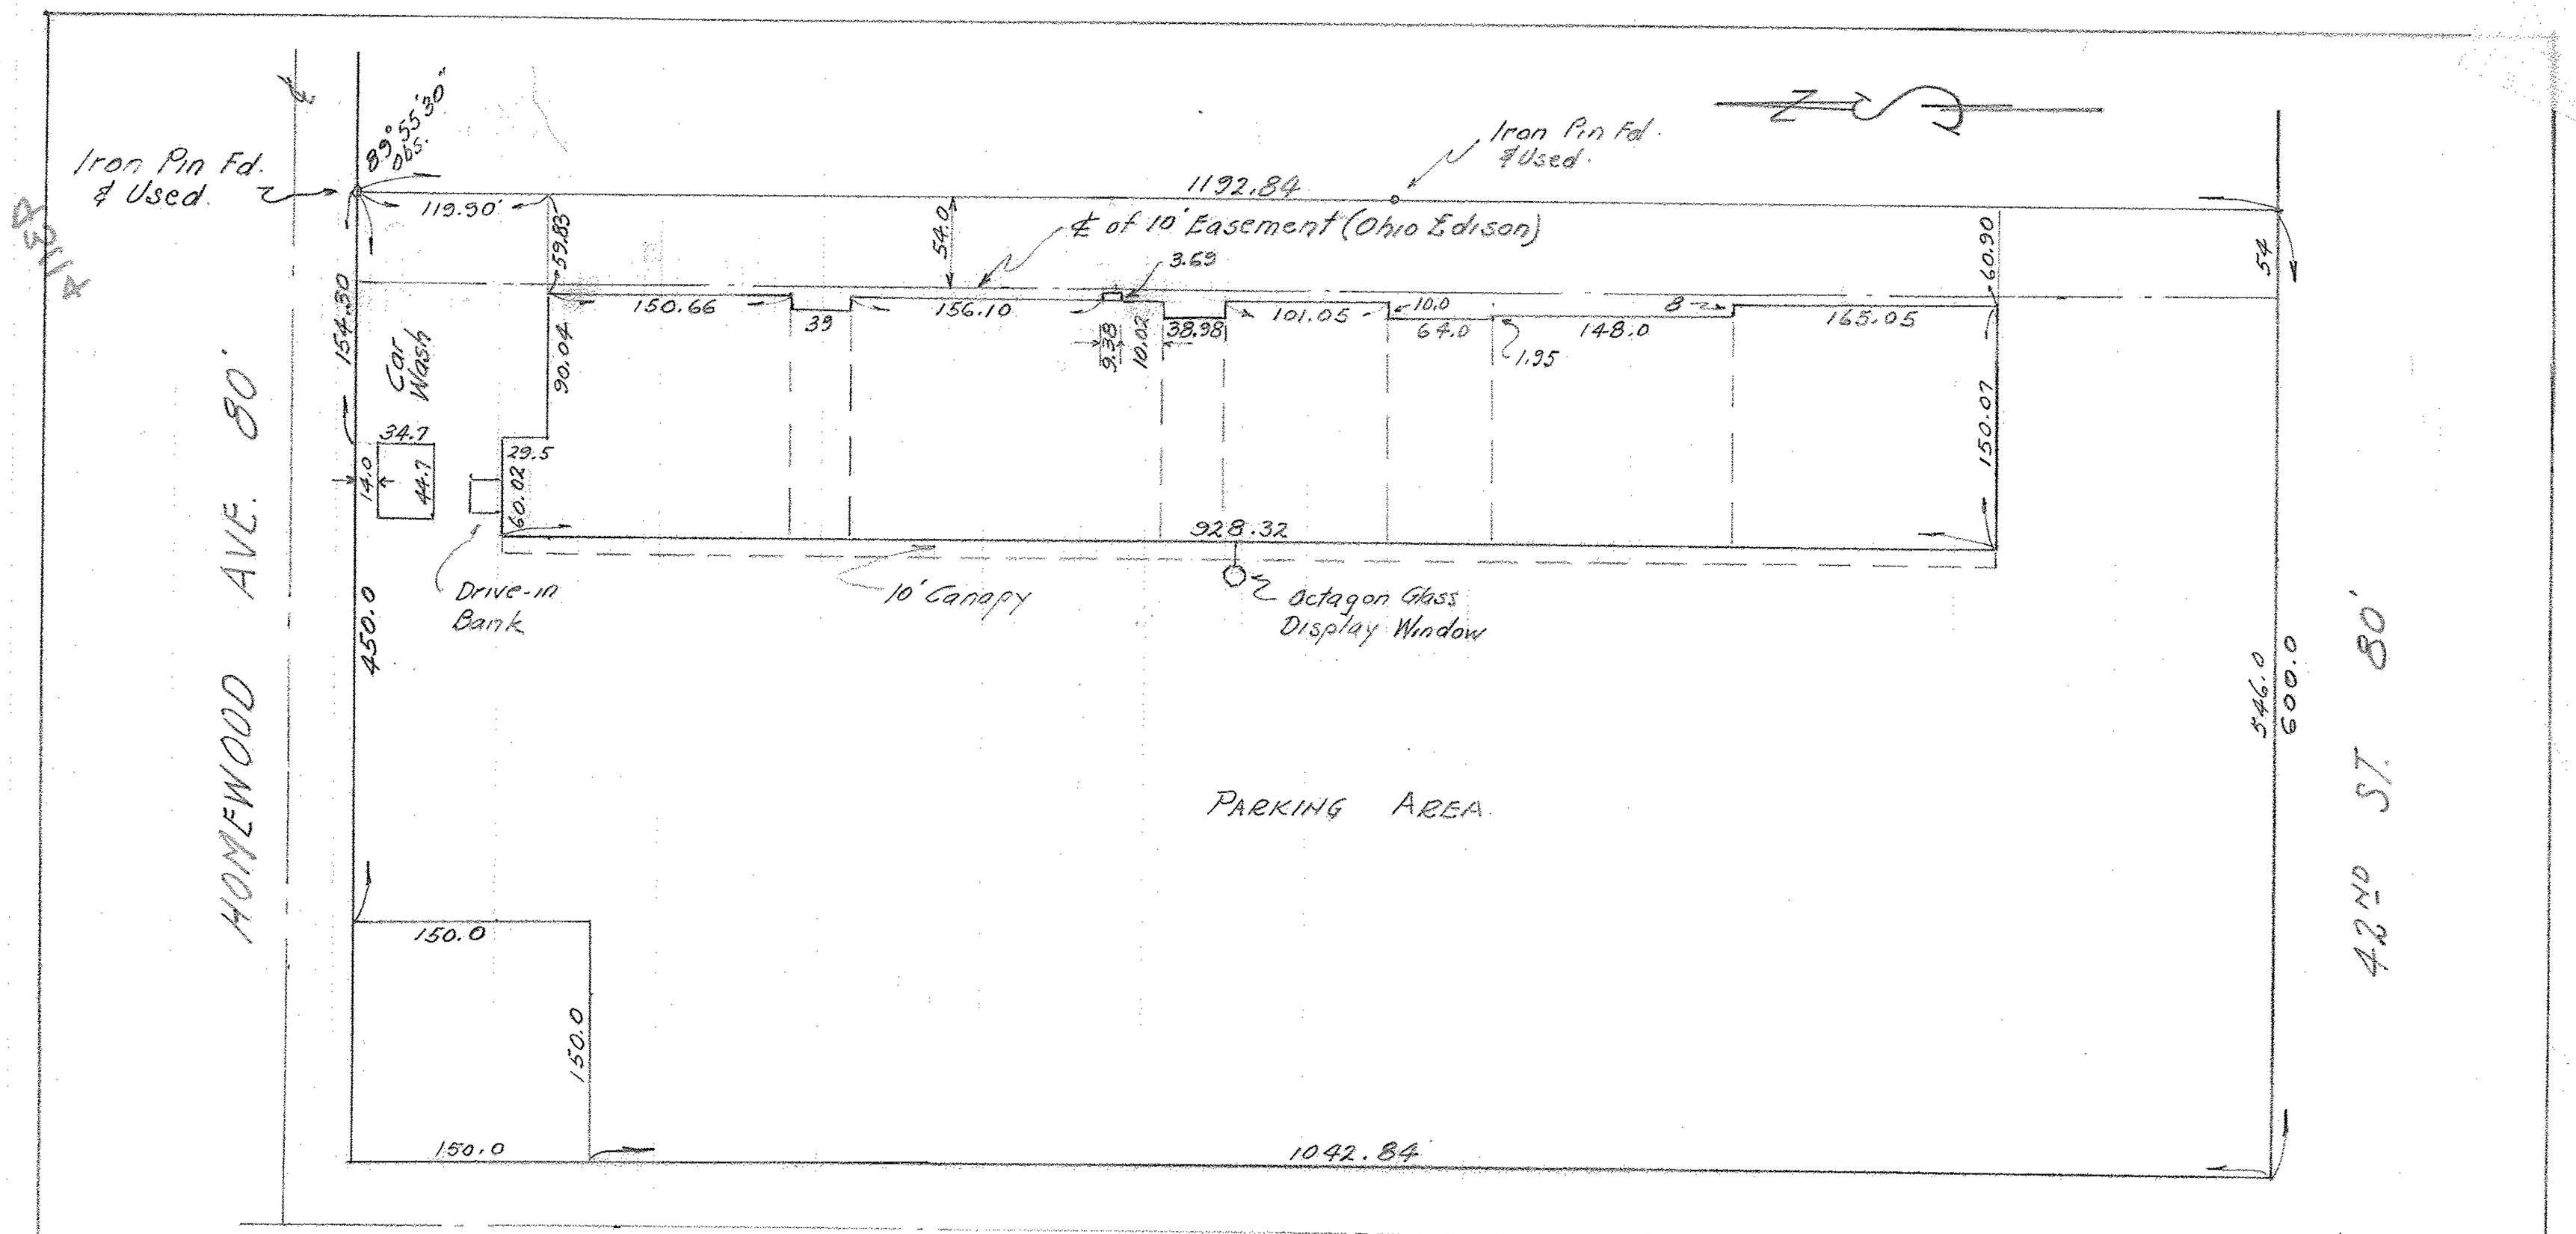

NOT A PLAT OF SURVEY
FOR MORTGAGE PURPOSES ONLY

OAKWOOD SHOPPING CENTER HI-VIEW BUILDERS 4751 OBERLIN AVE. LORAIN, OHIO	SCHAFER, HURA & ASSOCIATES, INC. ENGINEERS AND SURVEYORS 4370 OBERLIN AVE. LORAIN, OHIO	ORIGINAL NO. 100 — DATE 11-1-72 SUBMITTED SHEFFIELD — SCALE 1"=100' CITY OF LORAIN — FIELD BOOK 219-PG. 59 COUNTY OF LORAIN — DRAWN BY J.L.M. STATE OF OHIO — CHECKED BY P.O. 1878 — FILE B 3-00-100(1878)-37

3- -100