


CLEVELAND ELYRIA ROAD

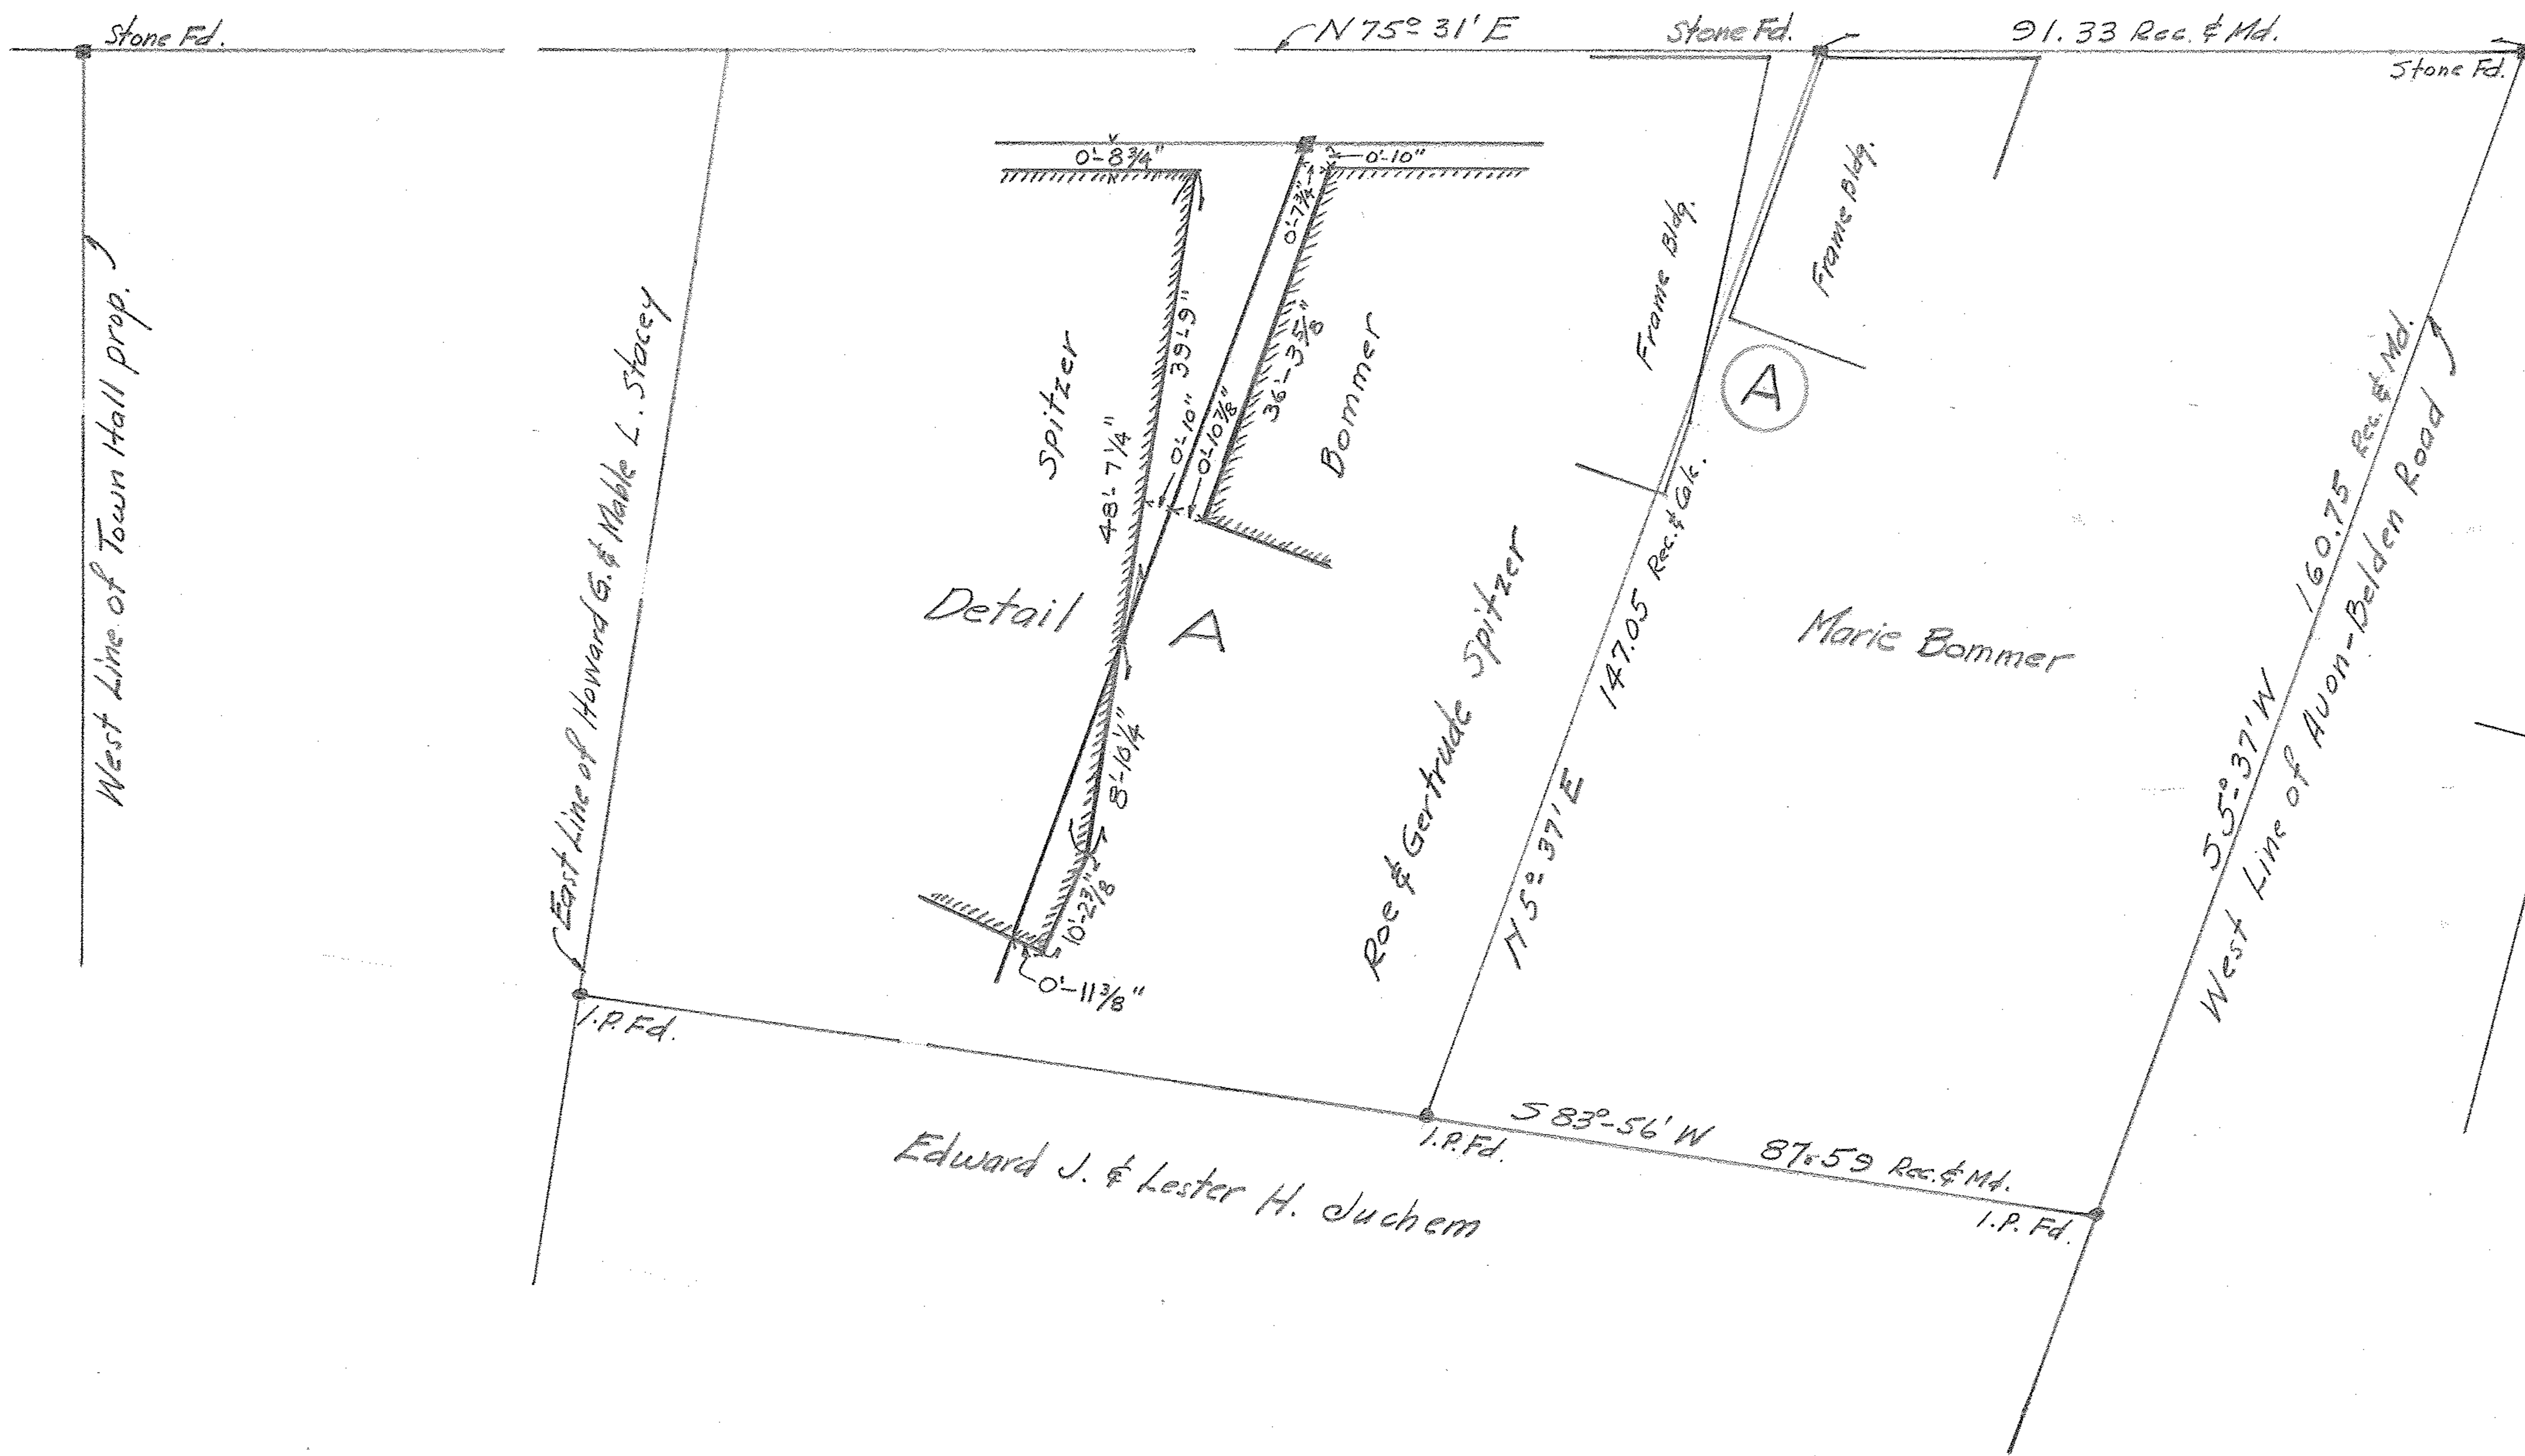

SURVEY FOR  
 MARIE BOMMER  
 Part of Original Lot No. 28  
 Ridgville Twp.  
 Lorain County Ohio  
 Scale: 1" = 20' Aug. 1947  
 J. H. Getz, Reg. Surveyor.