


± CLEVELAND ELYRIA ROAD

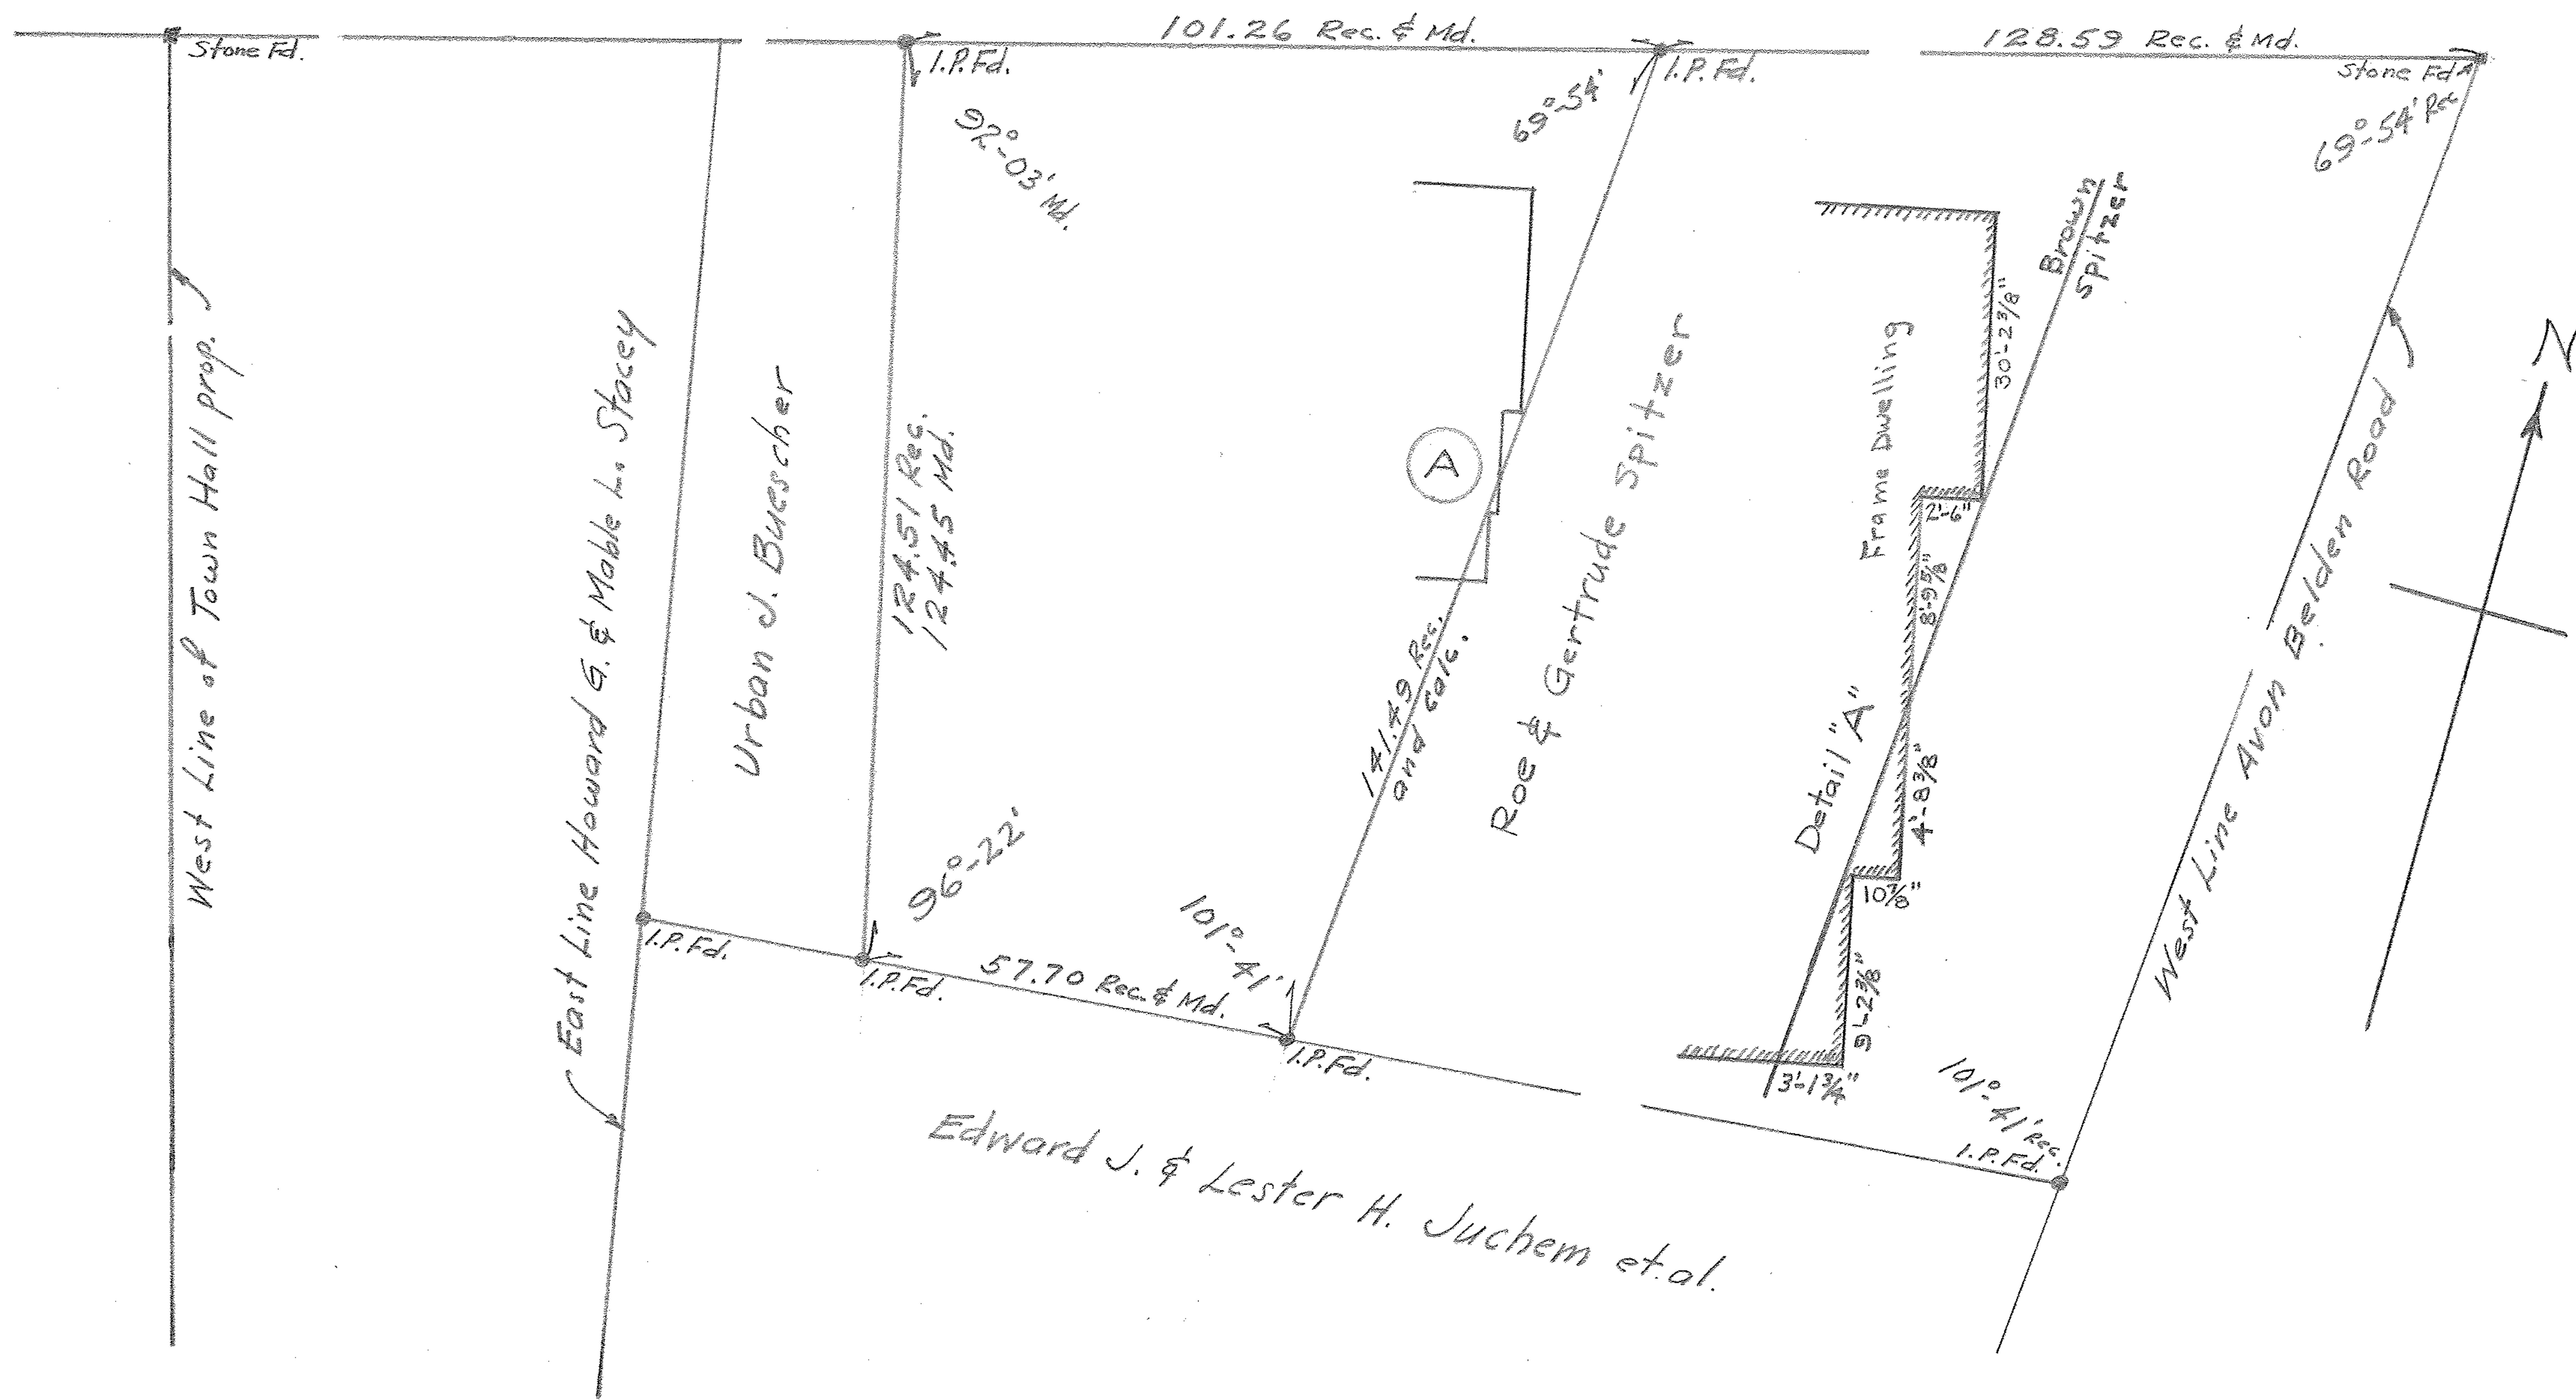

SURVEY FOR
 Chas. C. and Agnes M. Brown
 Part of Original Lot No. 28
 RIDGEVILLE TWP.
 Lorain County Ohio
 Scale 1" = 20' Aug. 1947
 J.H. Getz Reg. Surveyor