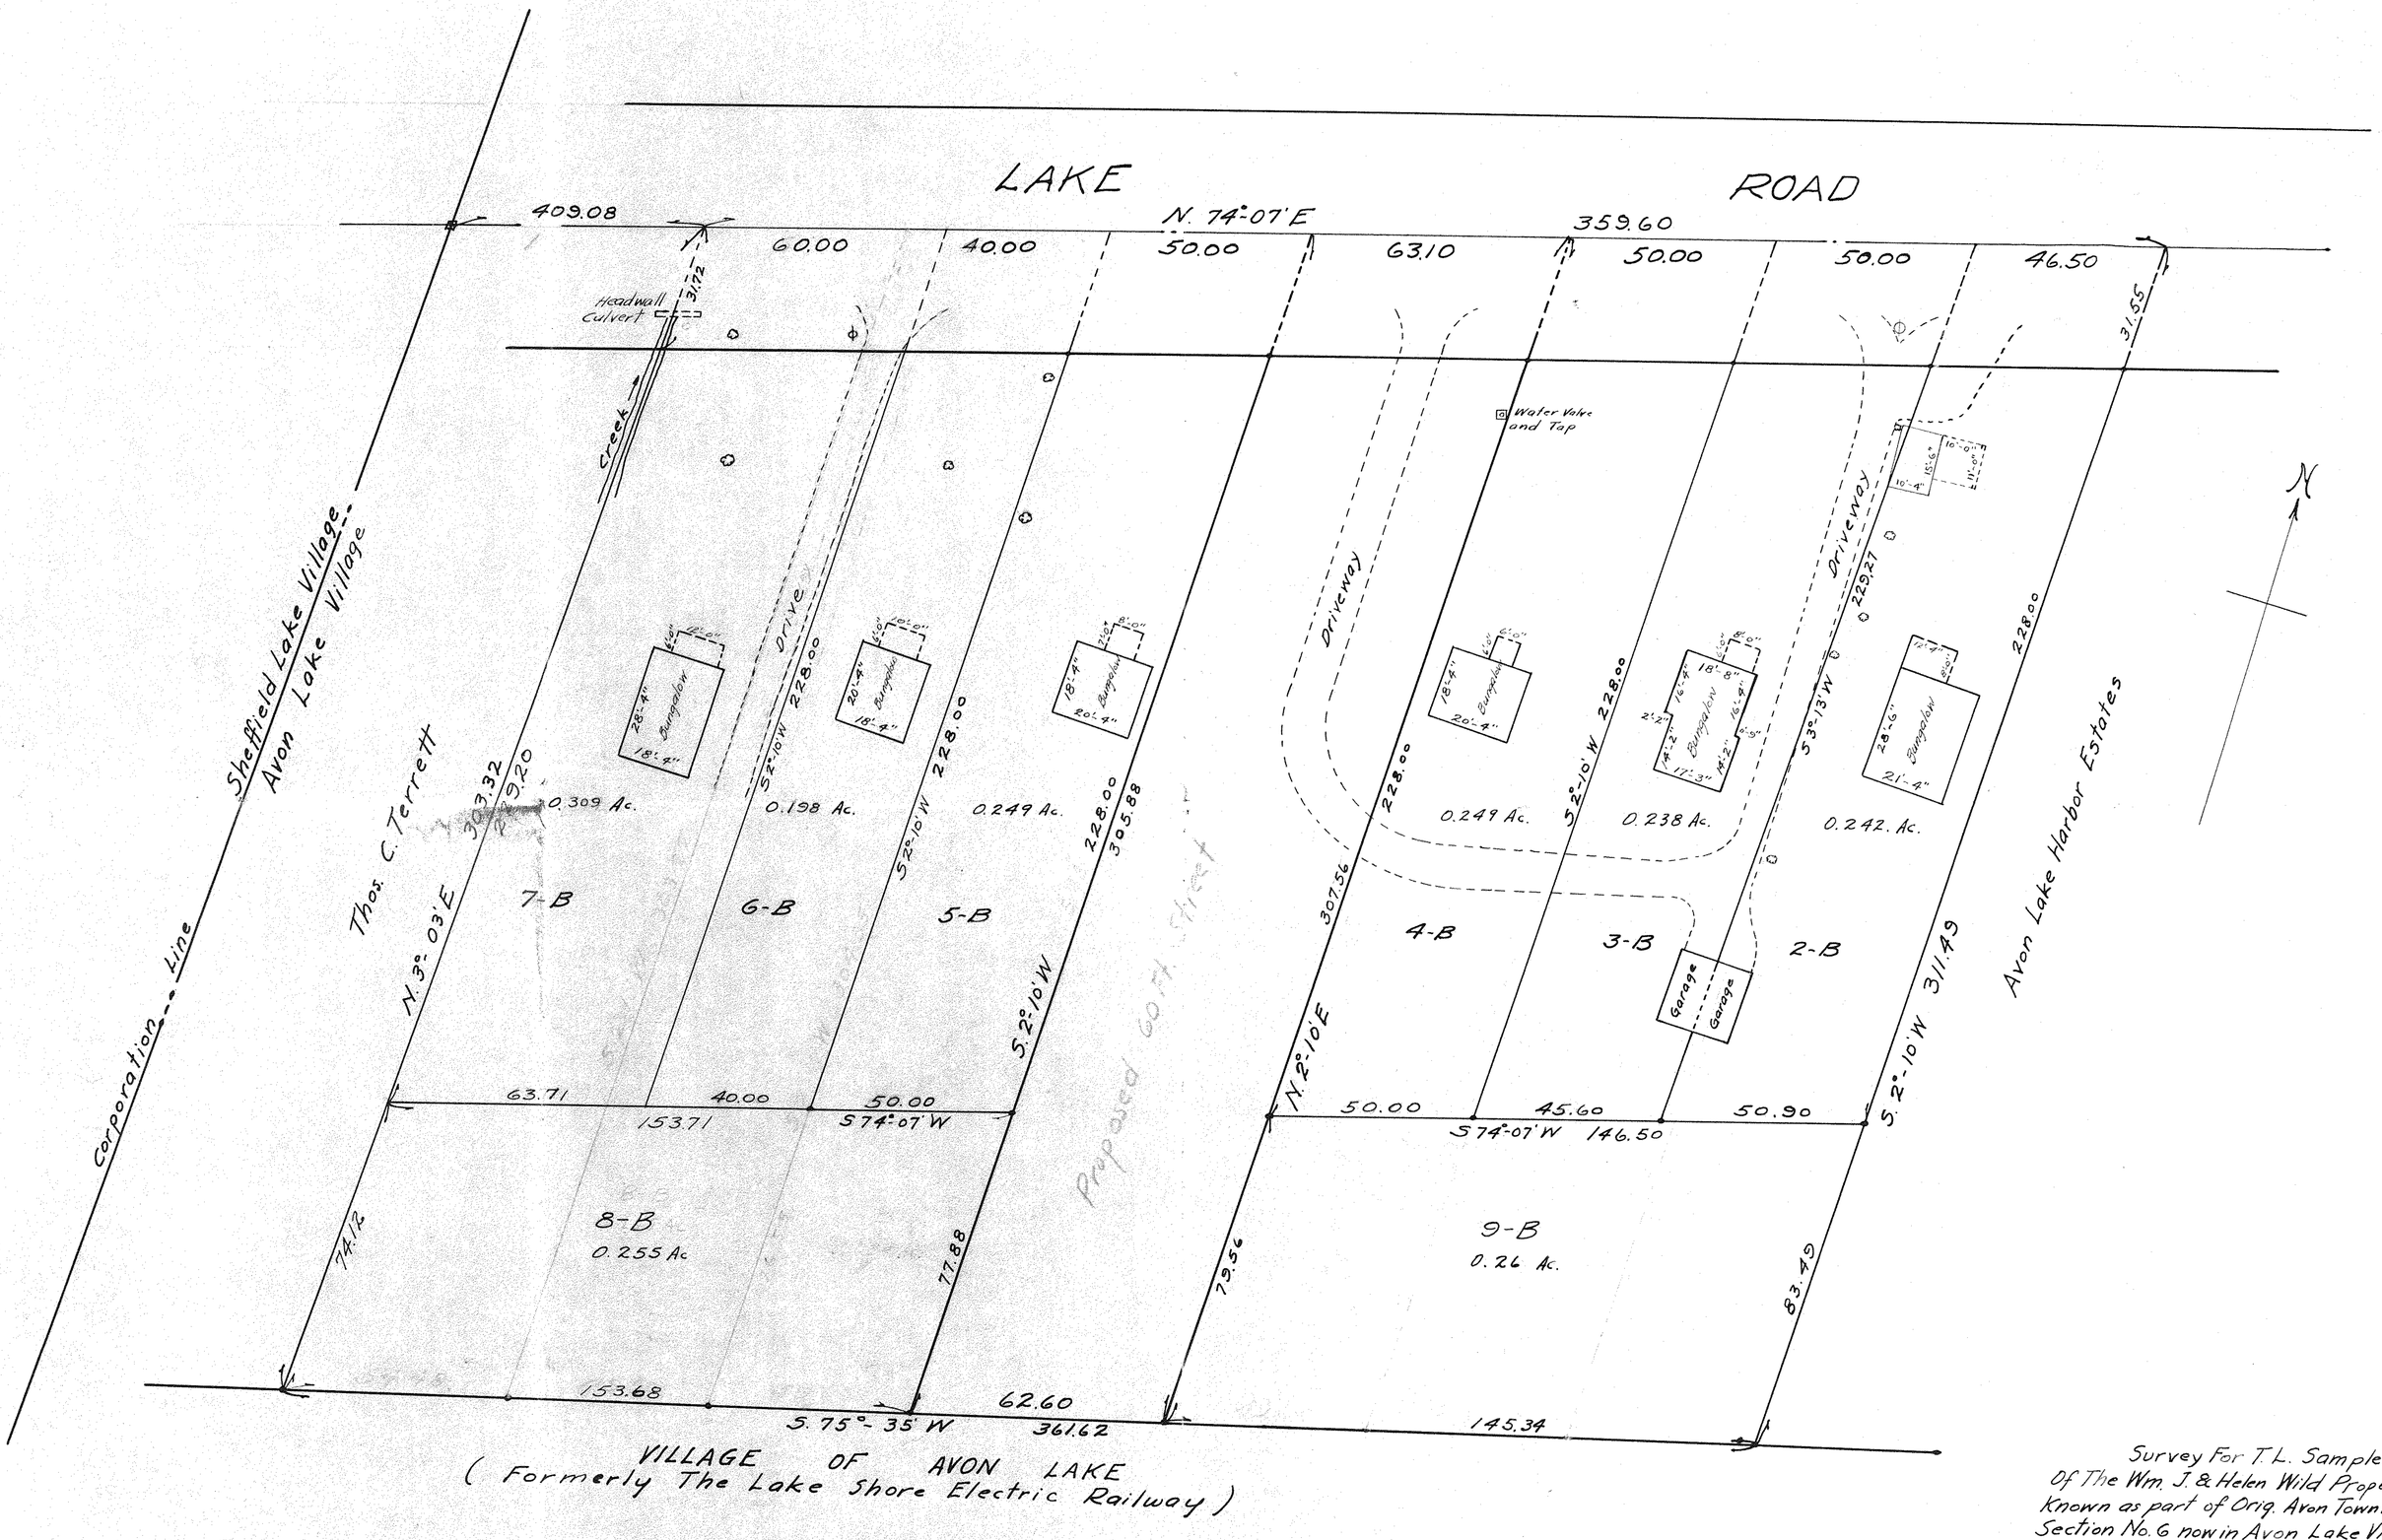

Survey For T.L. Sample
Of The Wm. J. & Helen Wild Property
Known as part of Orig. Avon Township
Section No. 6 now in Avon Lake Village
Lorain County Ohio
Scale:-1" = 20' June 17, 1948
J.H. Getz Reg. Surveyor

● Denotes Iron Pins