


09-00-066-000-7??

09-00-066-A

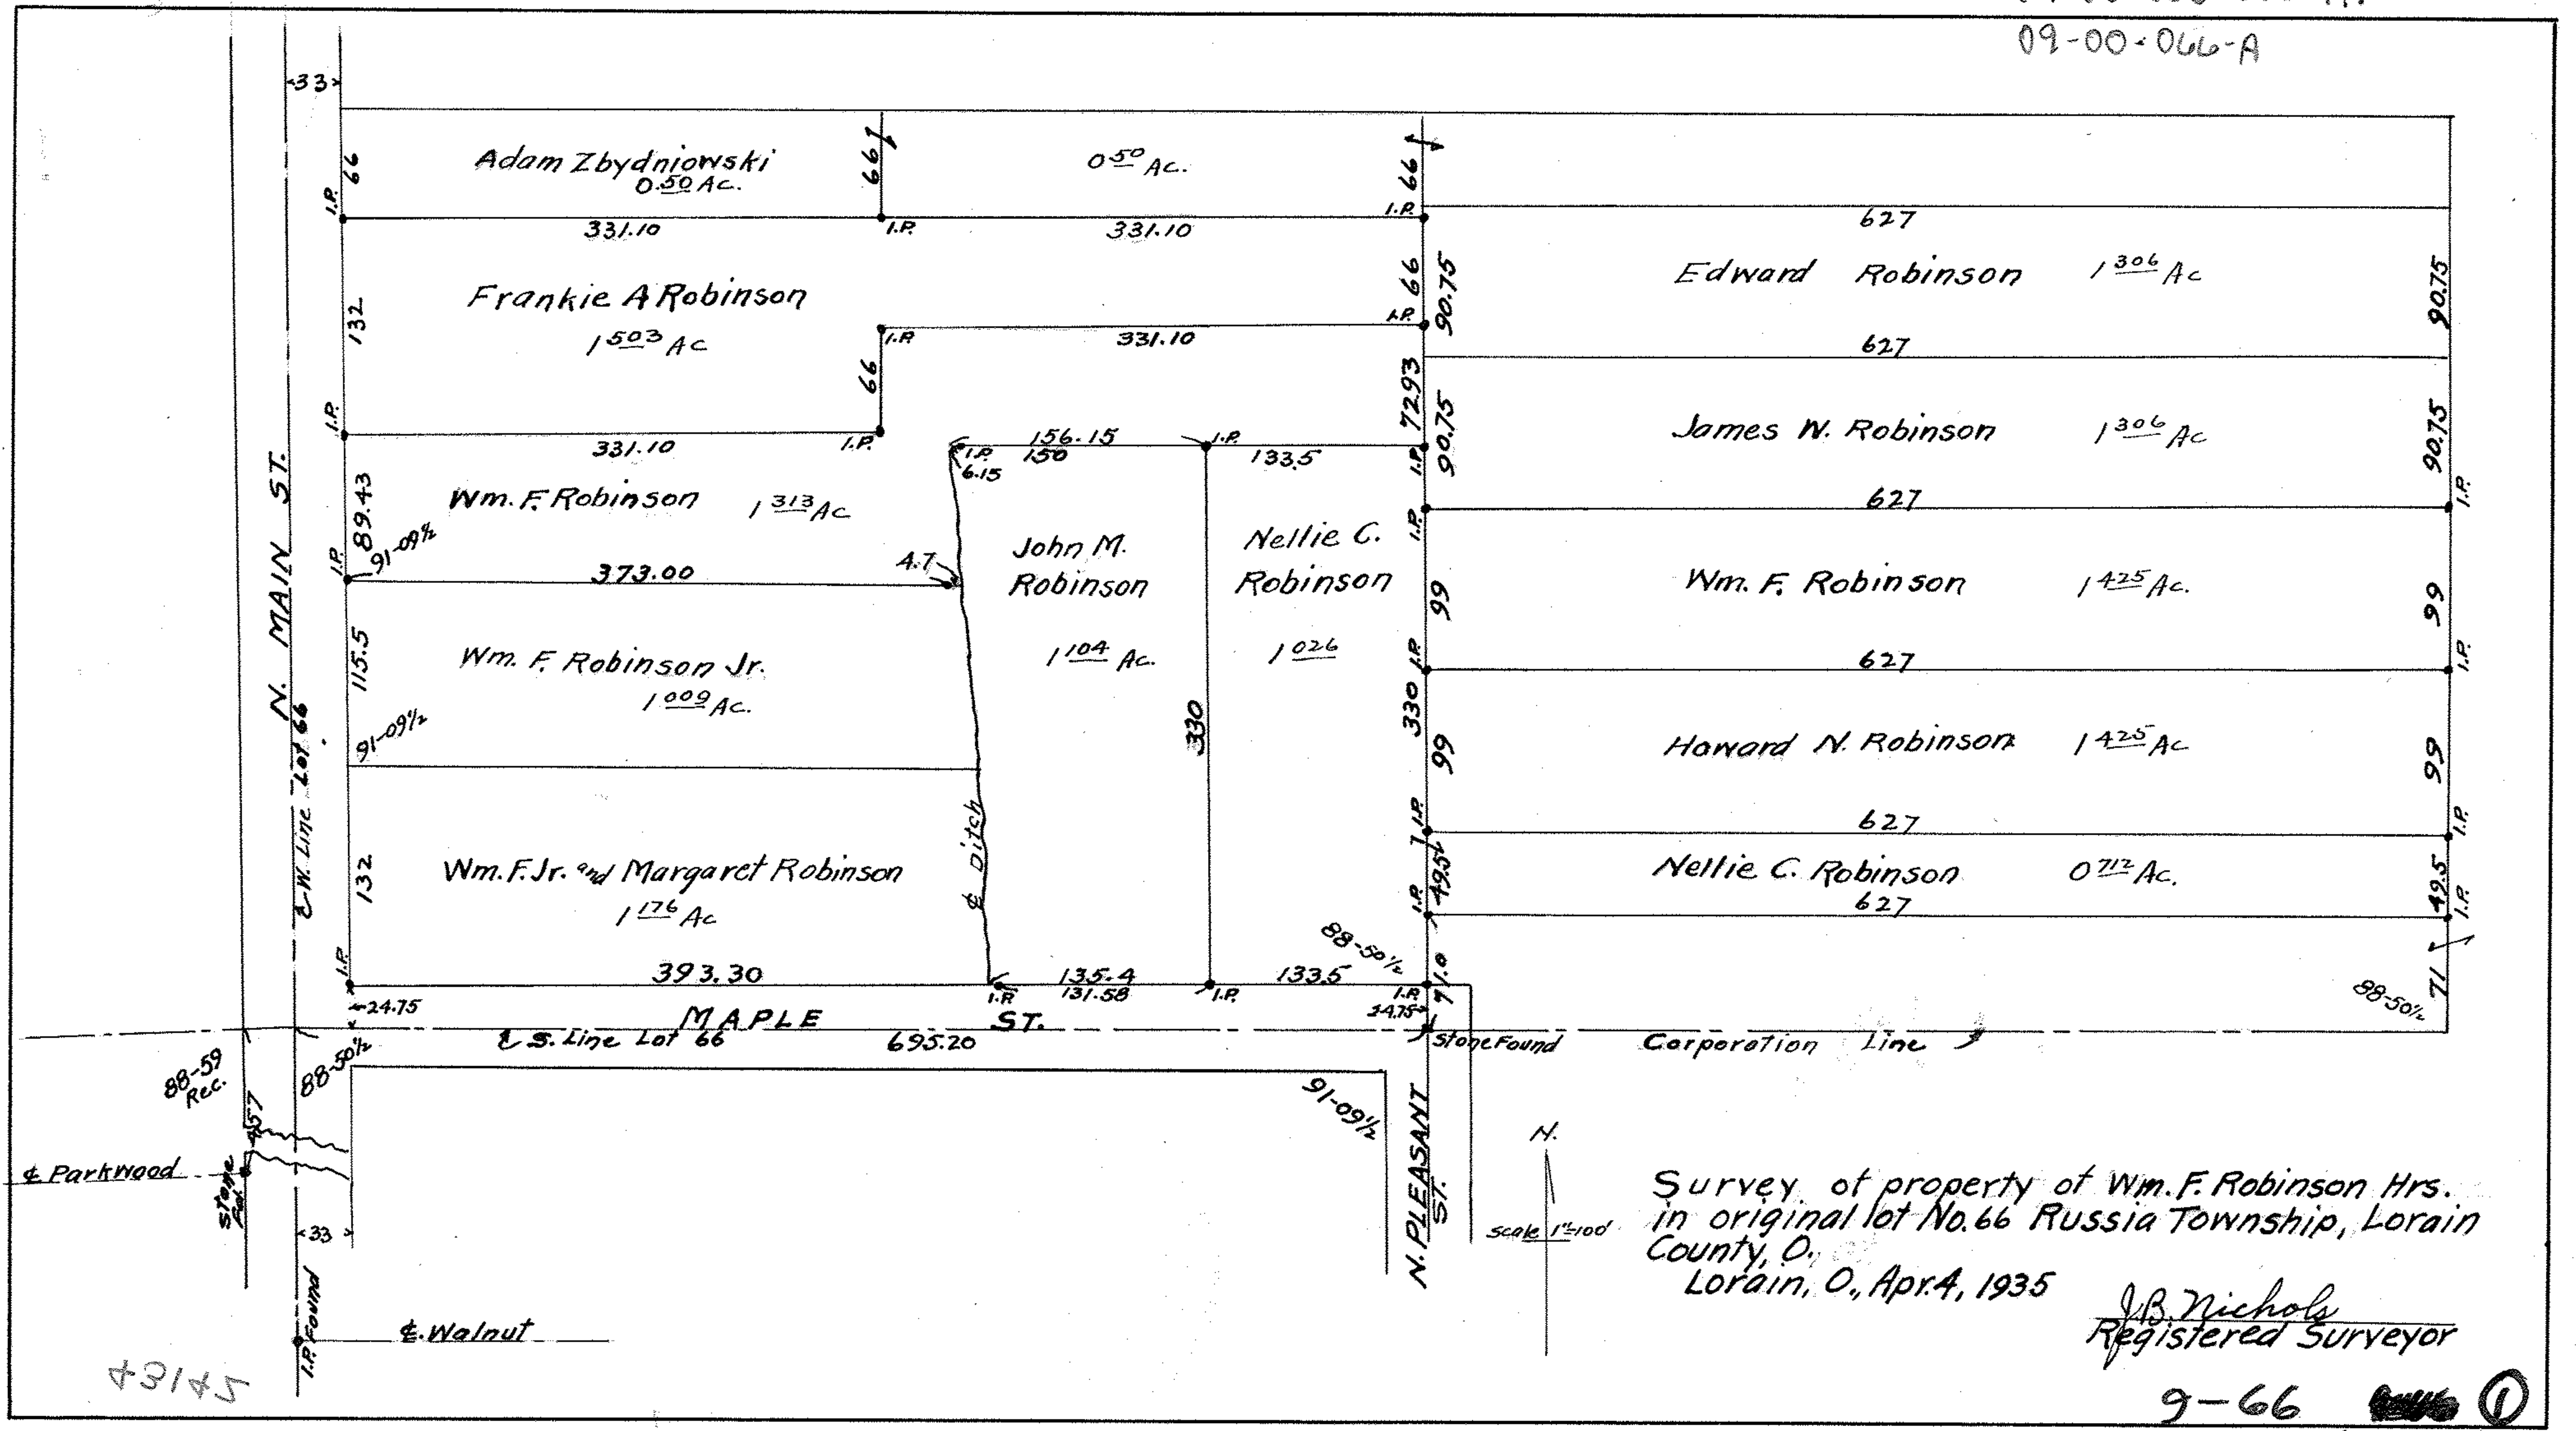

Survey of property of Wm. F. Robinson Hrs.
 in original lot No. 66 Russia Township, Lorain
 County, O.,
 Lorain, O., Apr. 4, 1935

J.B. Nichols
 Registered Surveyor

9-66 ~~66~~ ①

43145