S-A-72

05-00-023-110-???

5-00-023-A

5-23

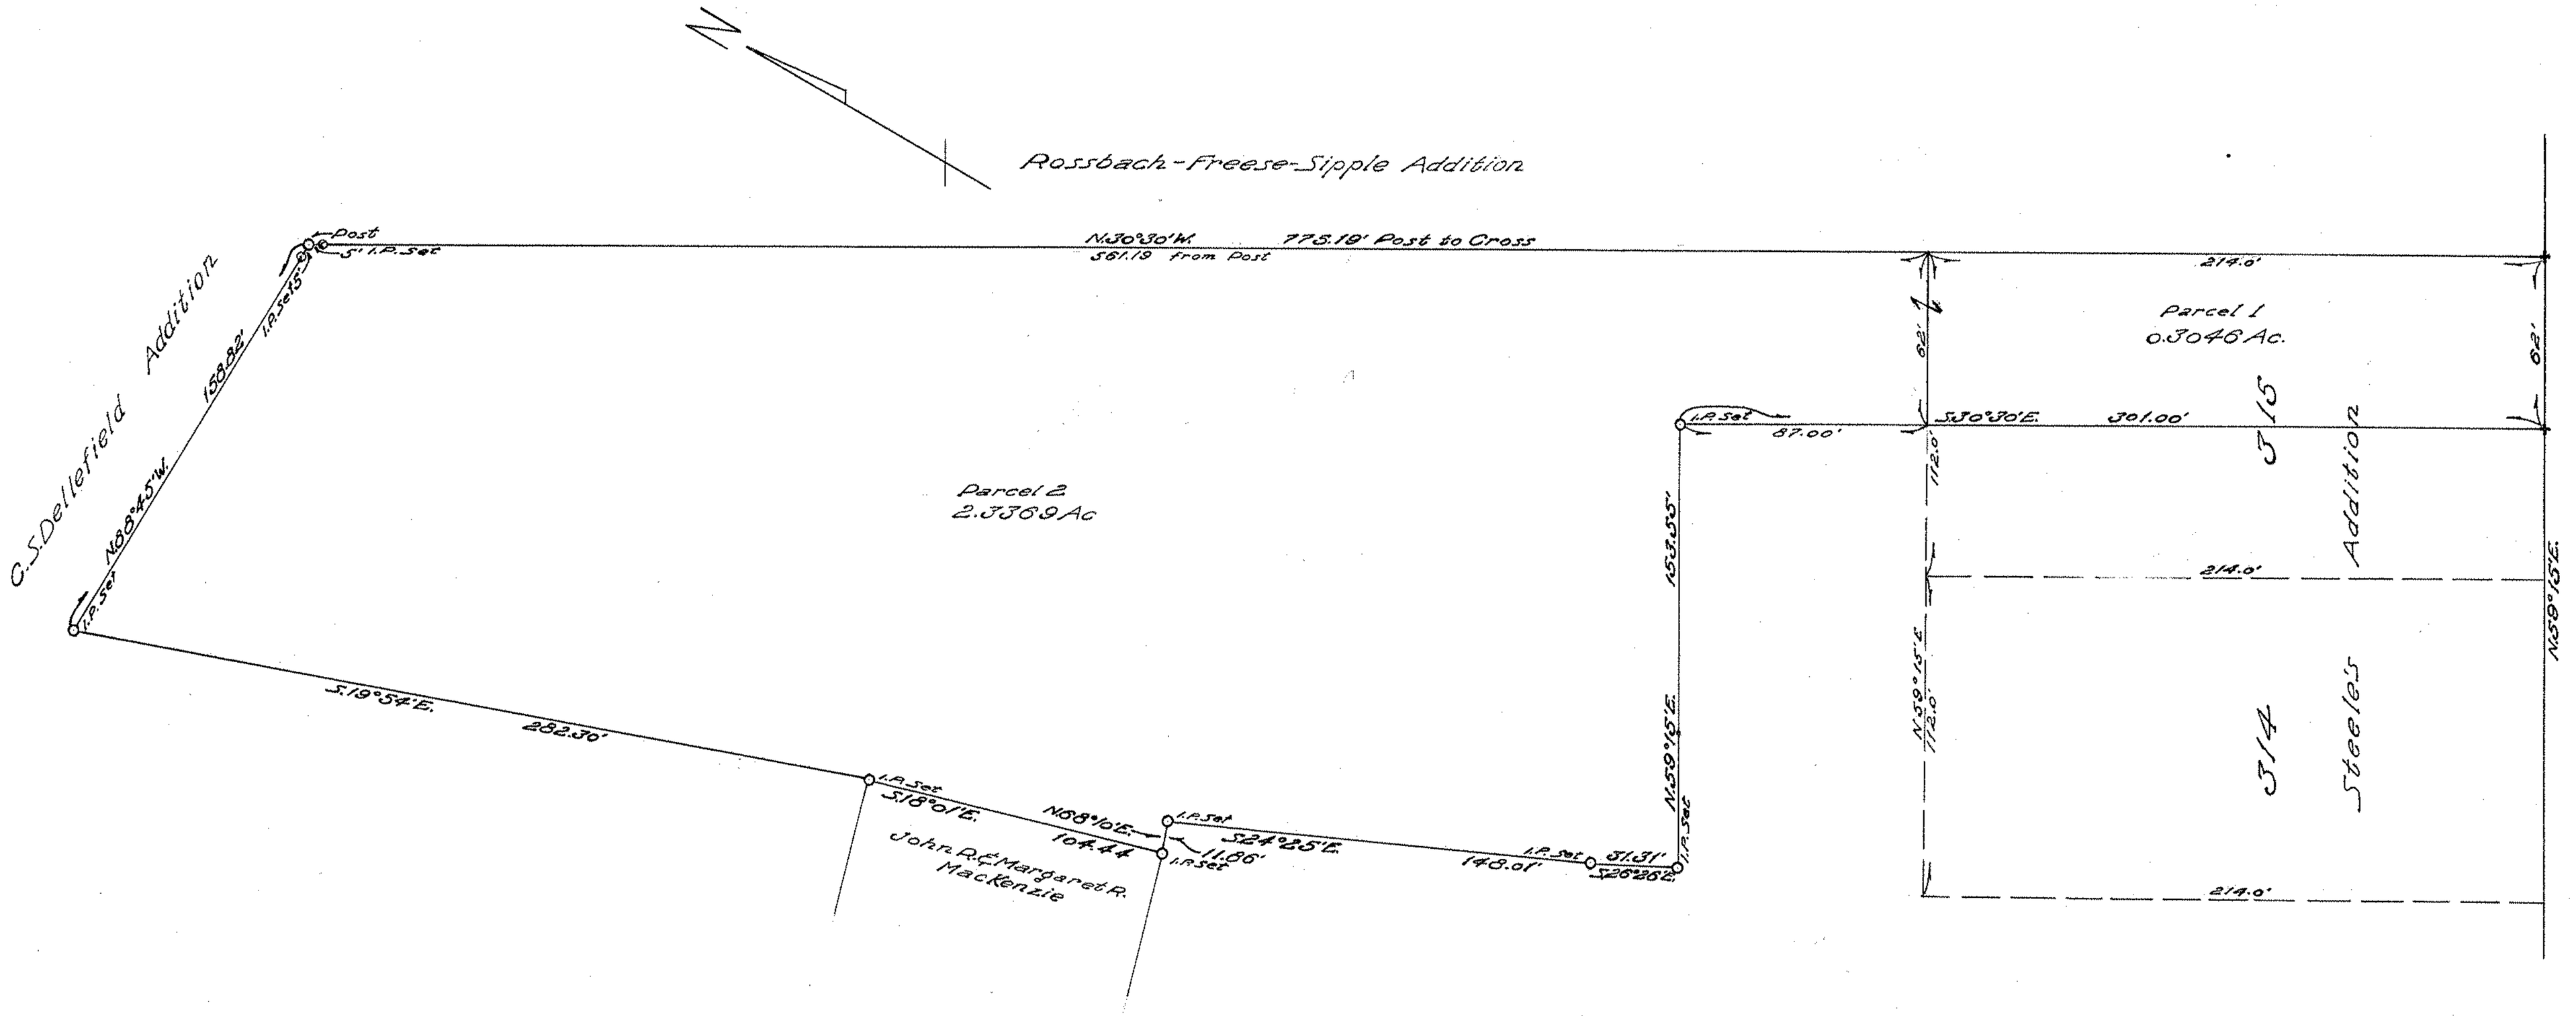

Survey of part of Lot 315 in Steel's Addition to the Village of Amherst, and part of Original Amherst Township Lot 23 in said Amherst Village and Township, Lorain County, Ohio. Survey made at the request of Mrs. Elizabeth Baus.

Lorain, Ohio — Scale 1" = 50' — July 22, 1947

J. B. Nichols — Registered Surveyor

See CC-1a

Sur. Vol. 112:115

5-23 (33)

S-A-72