Vol 18 Pg 23 A
Vol 17 Pg 14 A.
02-02-001-A
Ont.

2-2-1

PROPOSED
COBANT SUBDIVISION

BLACK RIVER TOWNSHIP
Scale: 1" = 60'

TRACK Nº 2, ORIG. LOT Nº 1
Date: Mar. 30, 1954

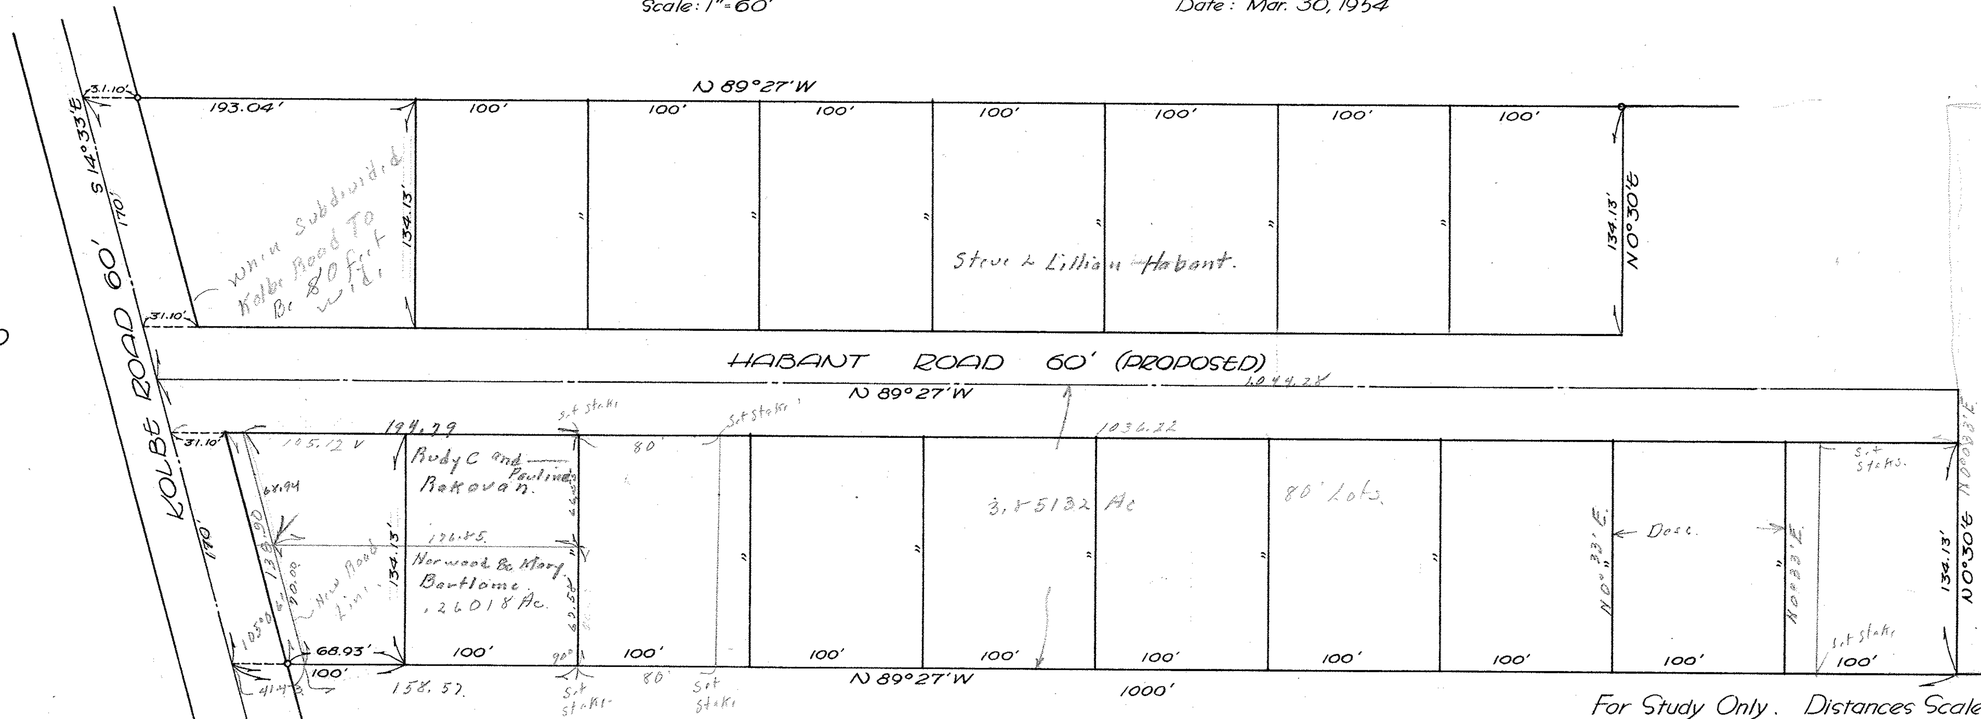

For Study Only. Distances Scaled.
By RAY E. HOLLIS,
CIVIL ENGINEER & SURVEYOR

Approved by Planning Commission 5-2-54

B-2-2-1 (7)

~~D-6 P.3.~~