


05-00-036-101-???

05-00-037-112-???

05-00-036-A  
05-00-037-A

FRANKLIN ST.

50'

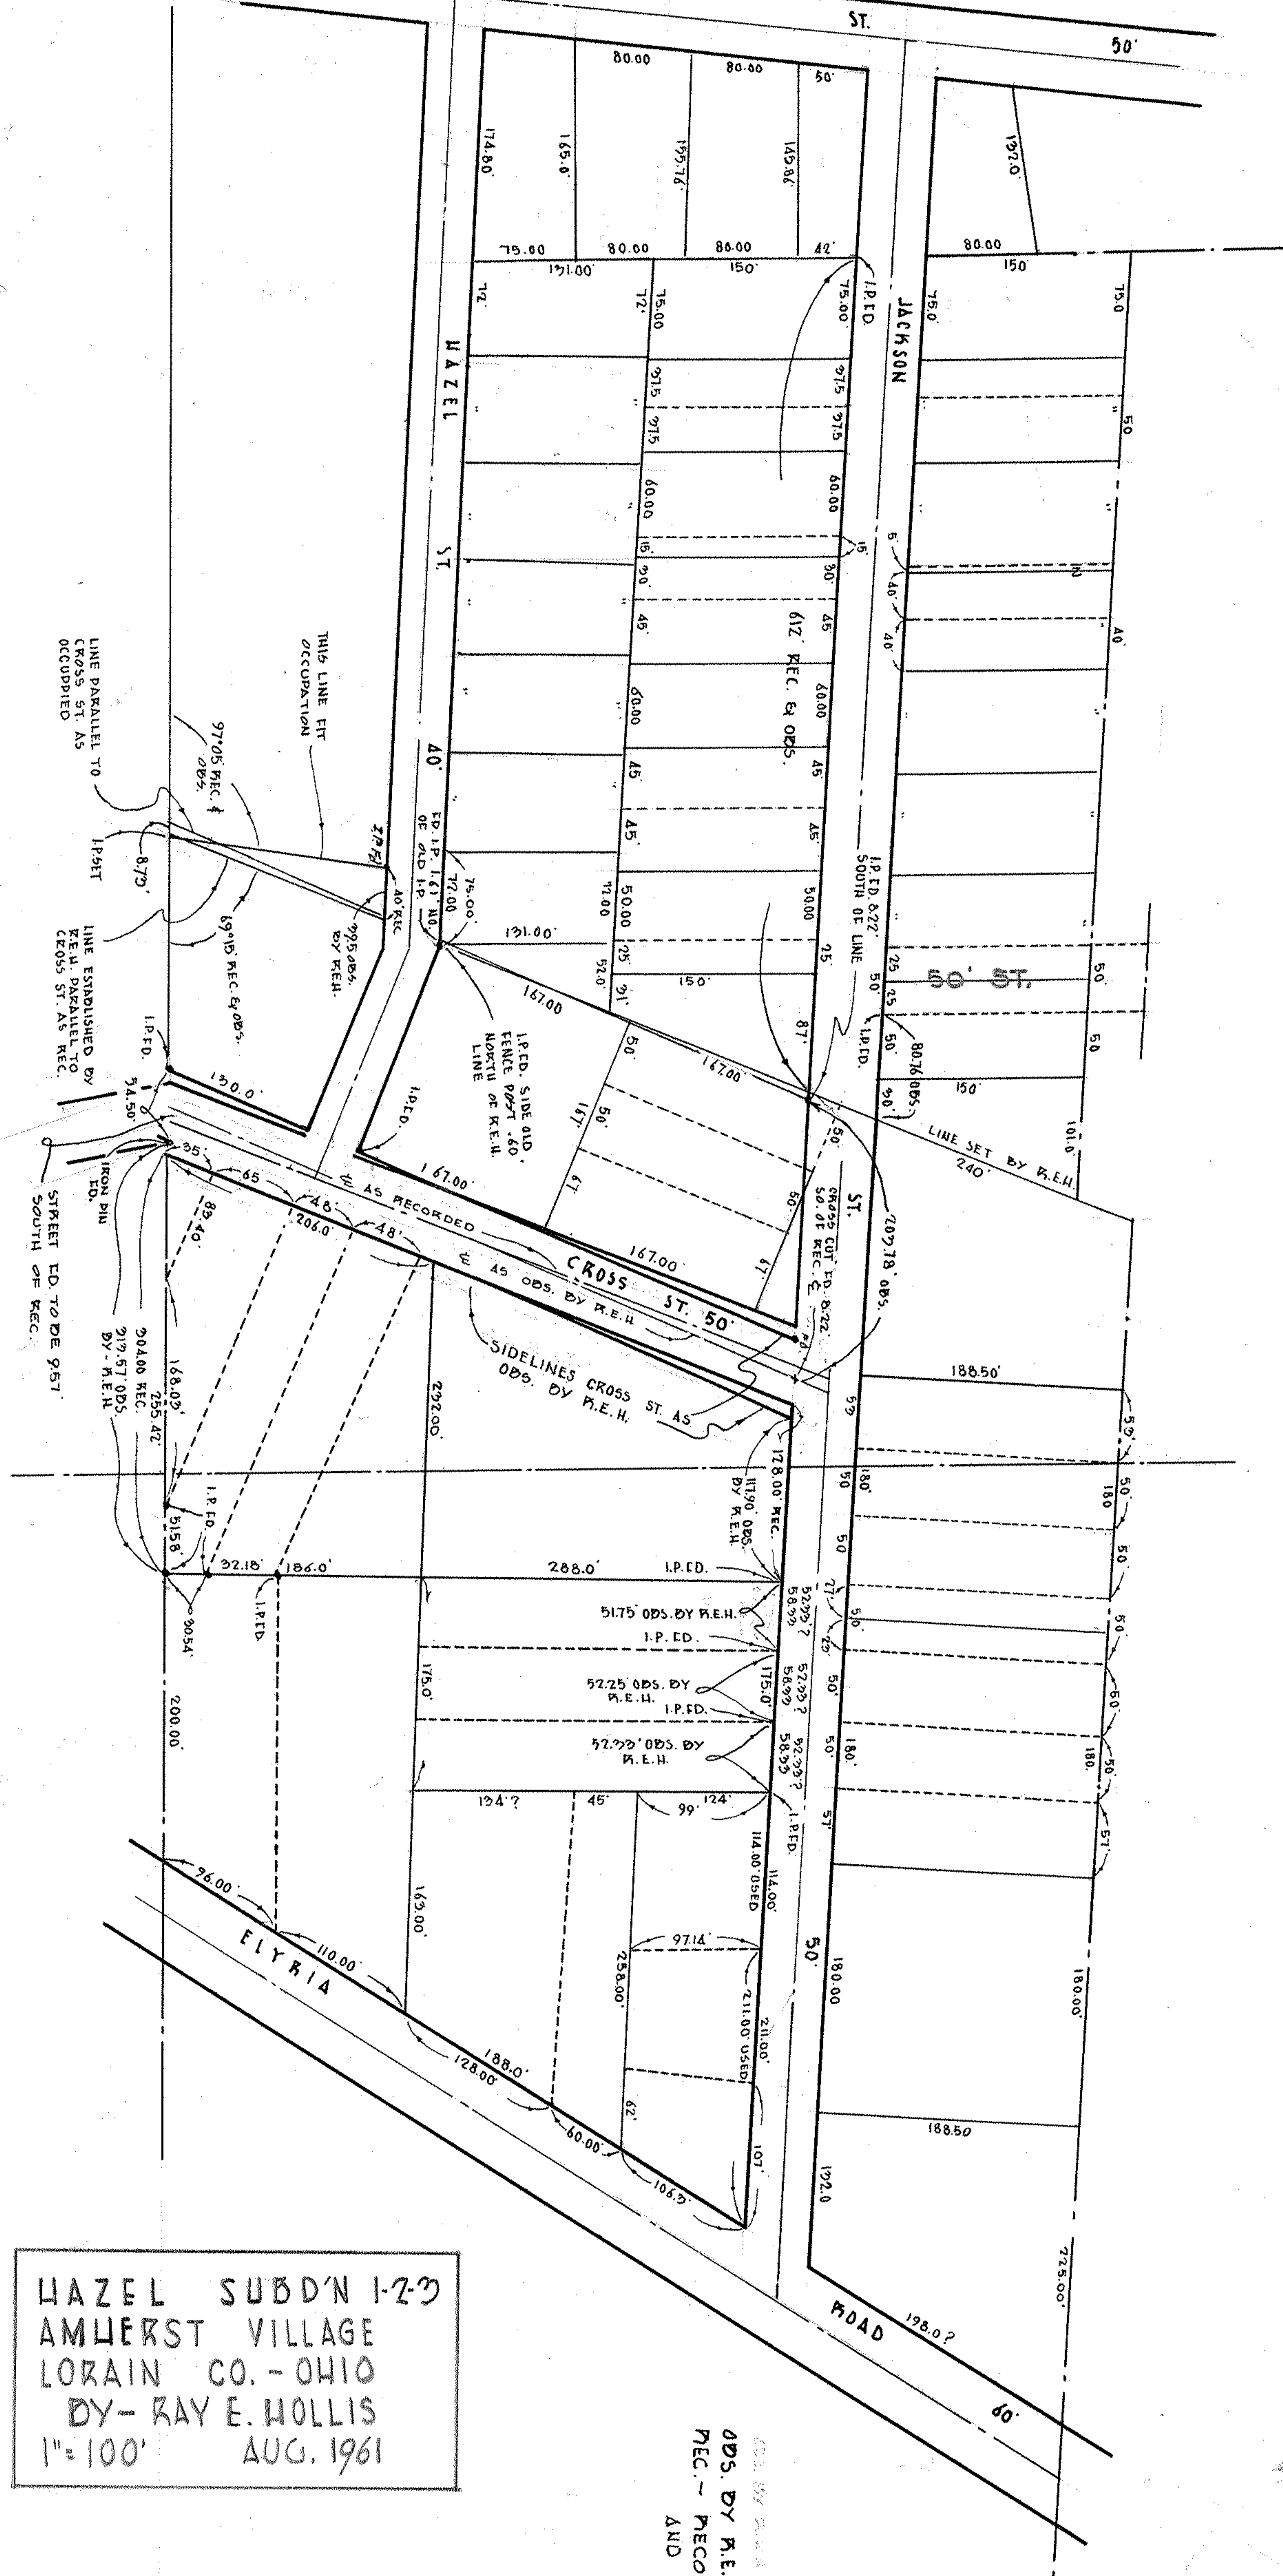

HAZEL SUBD'N 1-2-3  
 AMHERST VILLAGE  
 LORAIN CO. - OHIO  
 BY - RAY E. HOLLIS  
 1"=100' AUG. 1961

OBS. BY R.E.H. - MEAS. DISTANCE BY HOLLIS  
 REC. - RECORDED DIST. ON PLATS  
 AND PREVIOUS DEEDS.

B-5-00-073

5-73

1

5-73