4313 05-00-059-104-017
013
05-00-059-A

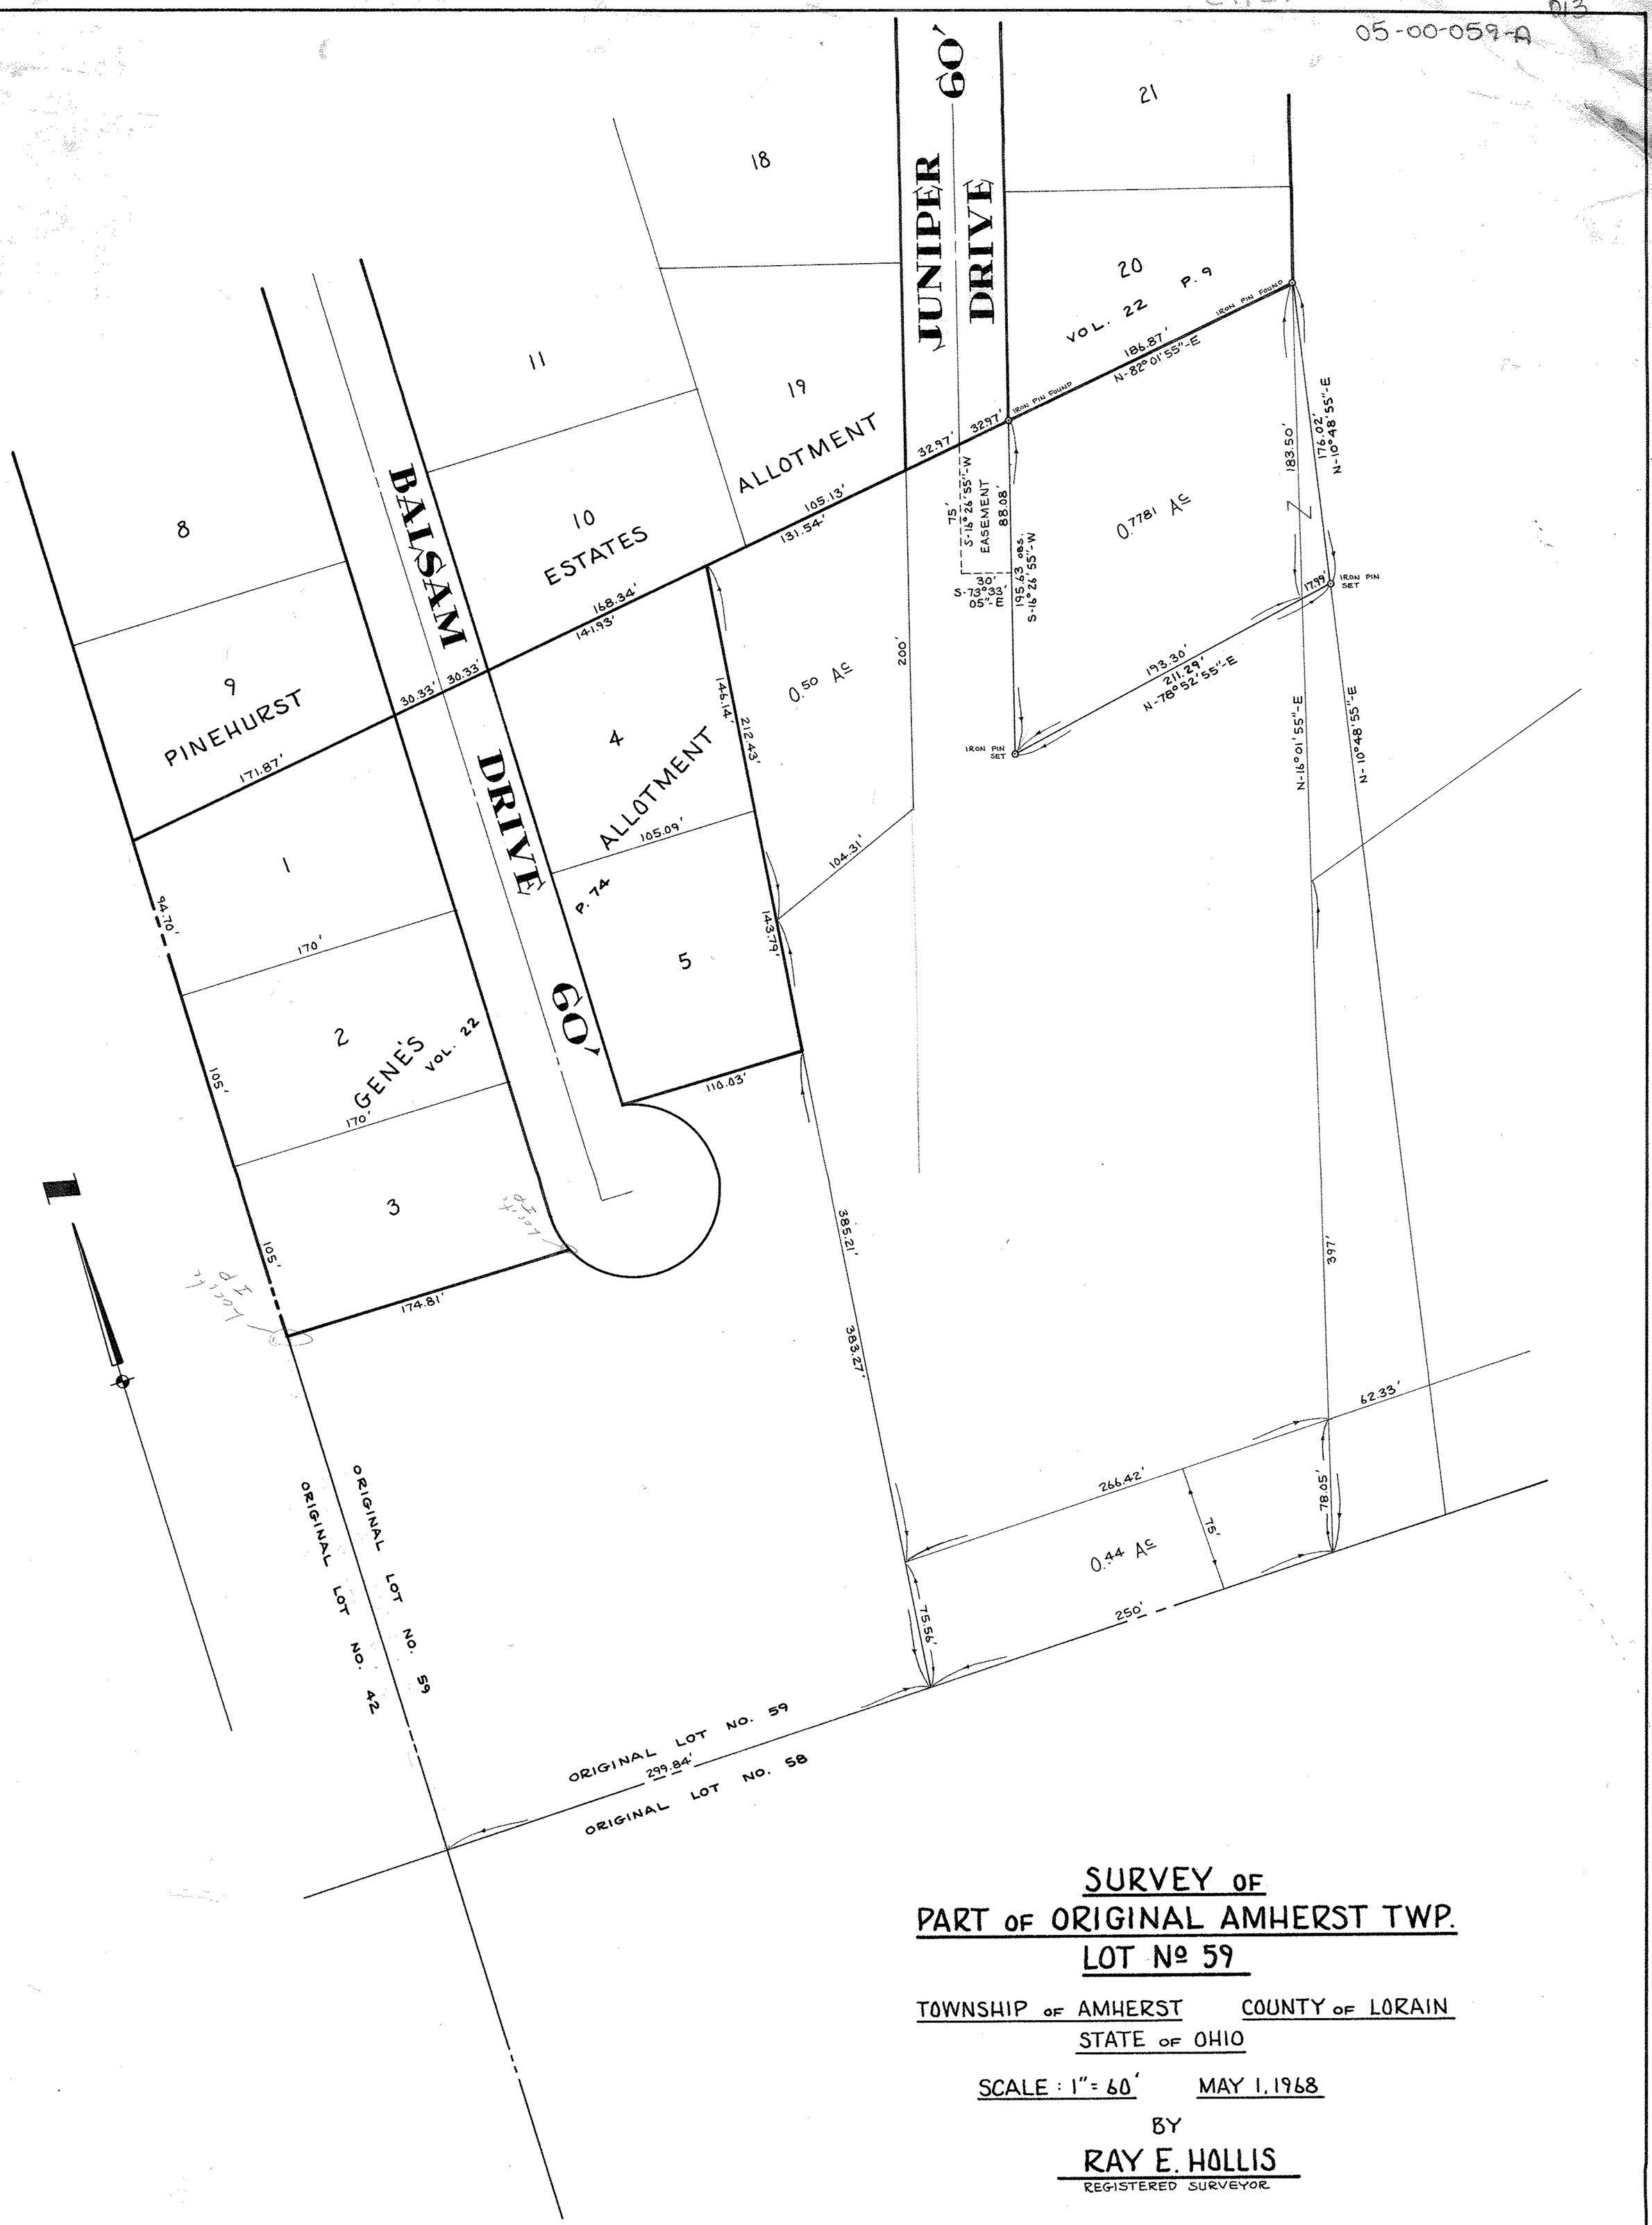

SURVEY OF
PART OF ORIGINAL AMHERST TWP.
LOT Nº 59

TOWNSHIP OF AMHERST COUNTY OF LORAIN
STATE OF OHIO

SCALE : 1" = 60' MAY 1, 1968

BY

RAY E. HOLLIS
REGISTERED SURVEYOR

143-20

05-00-059 (7)
5-59
D-29 P-55