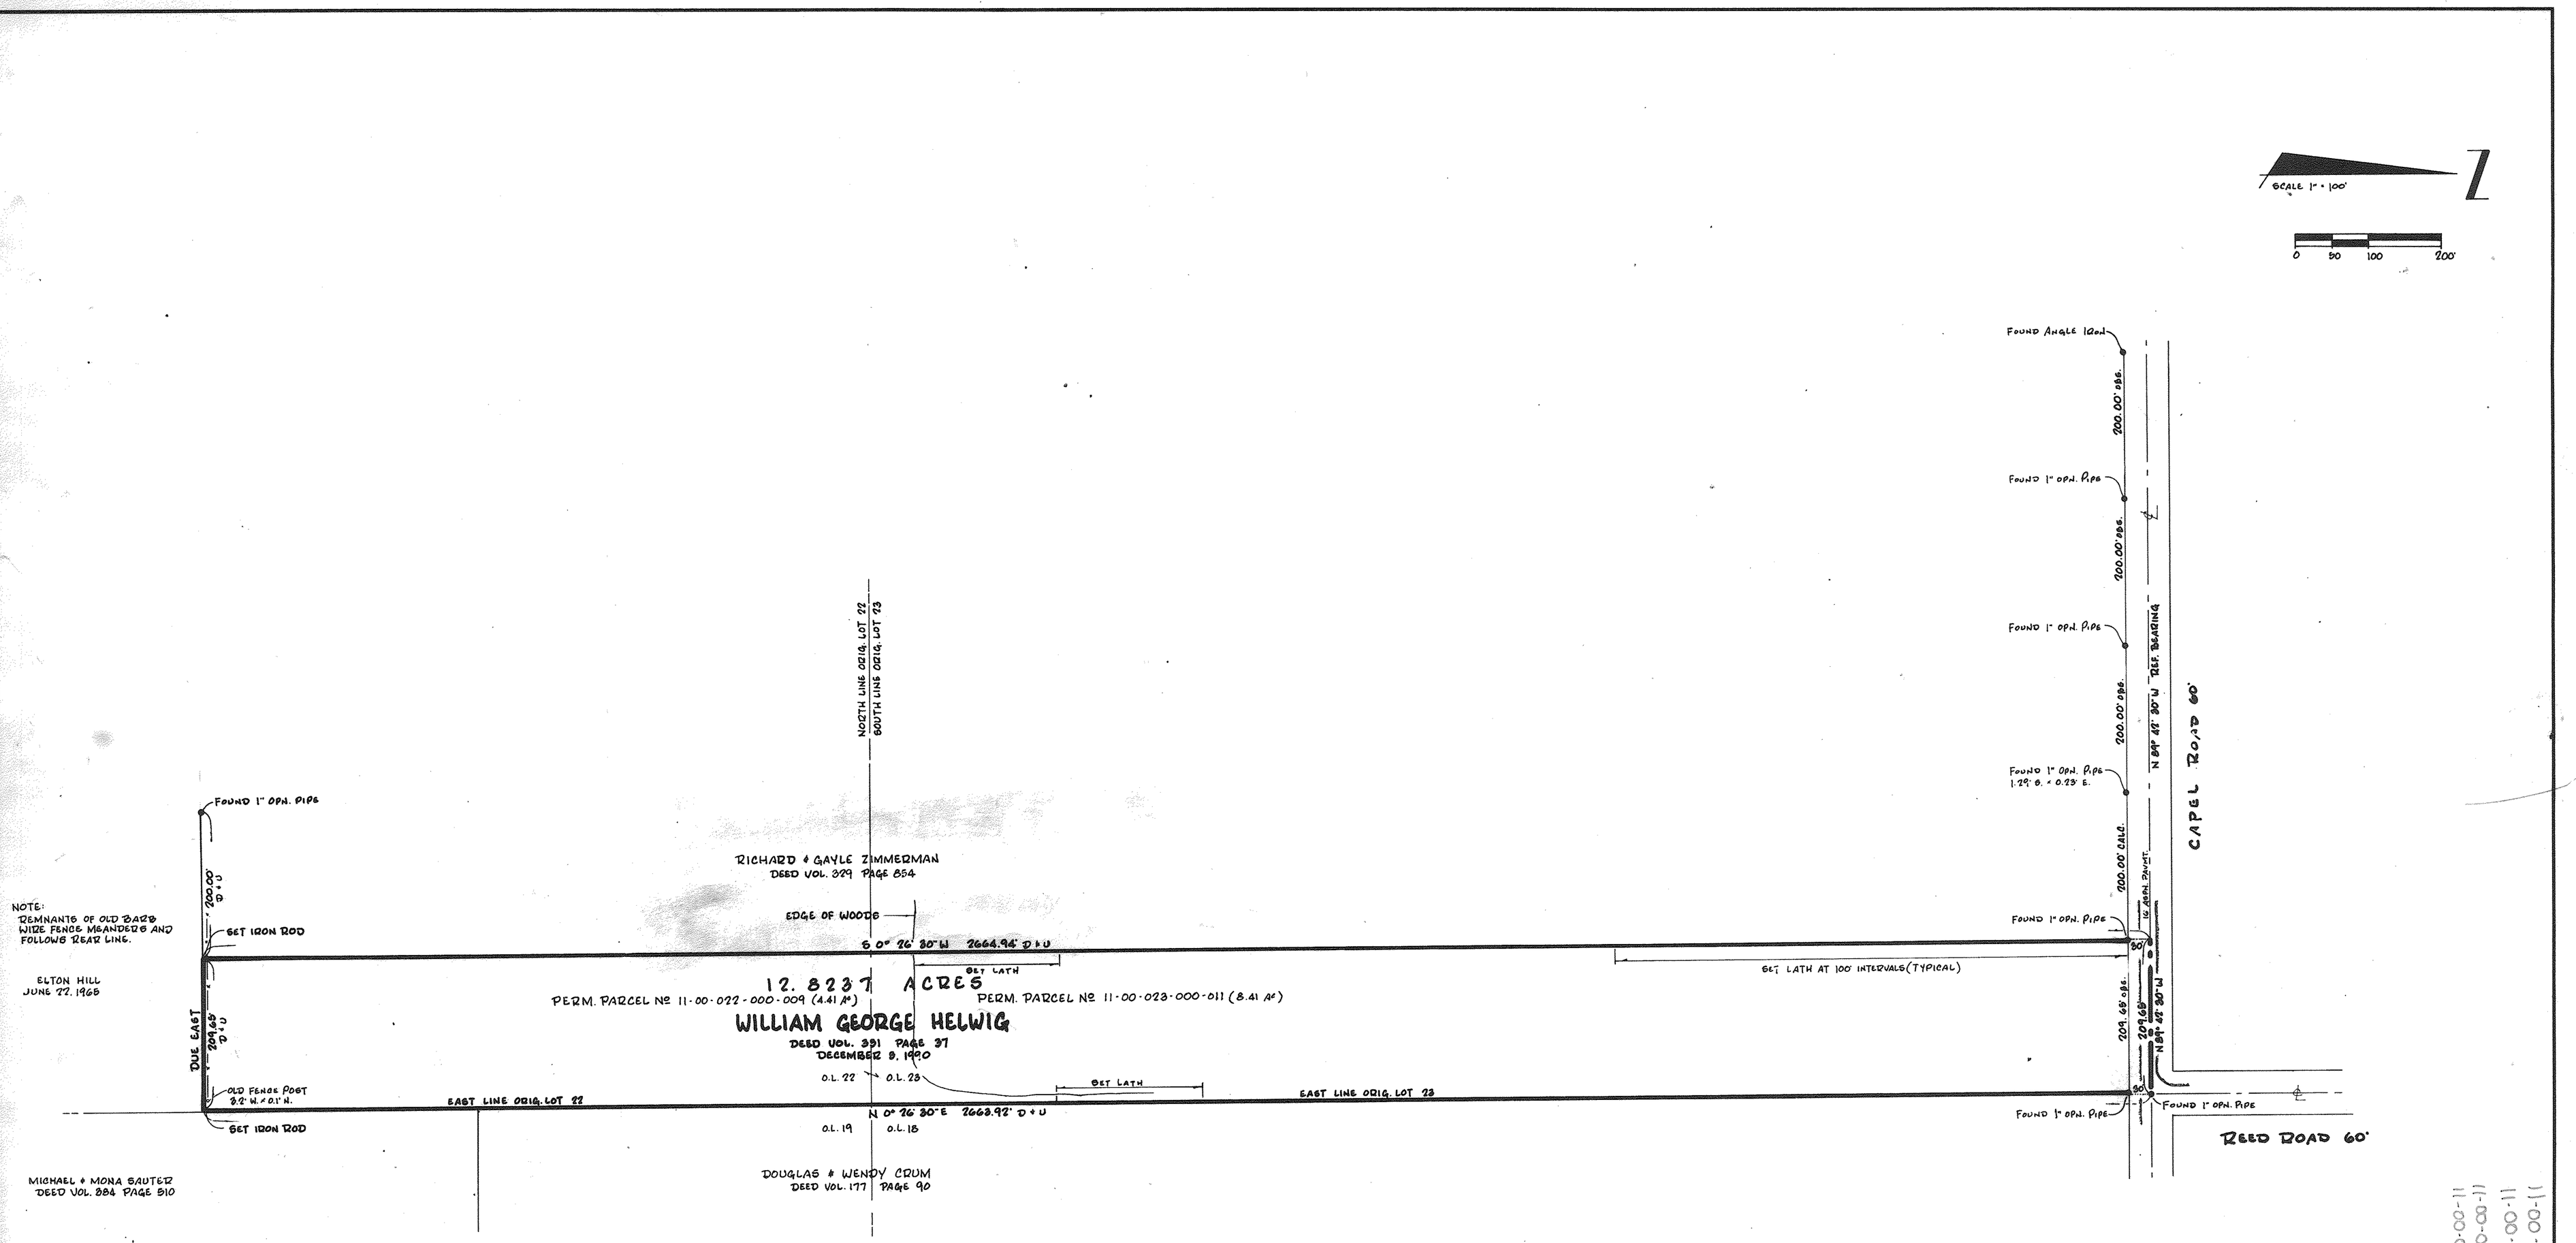

11-00-023-000-011
11-00-022-000-009
11-00-023-B

Peter C. Zwick

STATE OF OHIO
PETER C. ZWICK
6929
REGISTERED
SURVEYOR

REFERENCE SURVEY
JAMES H. SCHMIDT OCTOBER 7, 1967

BEARINGS SHOWN HEREON ARE TO A ASSUMED MERIDIAN AND ARE USED TO DENOTE ANGLES ONLY.

D. = DEED
U. = USED
OBS. = OBSERVED

ZWICK ASSOCIATES, INC.
engineers • surveyors
1944 W. BAGLEY ROAD, BEREA, OHIO 44017-2912 (216) 891-1492

BOUNDARY SURVEY FOR WILLIAM G. HELWIG

A PART OF ORIGINAL EATON TOWNSHIP LOTS 22 & 23

DESIGNED —	DRAWN D.	CHECKED P.D.Z.
DATE MAY, 1991	REVISED	SCALE 1" = 100'