09-00-073-000-015
010
022
009
023

7-00-016-A

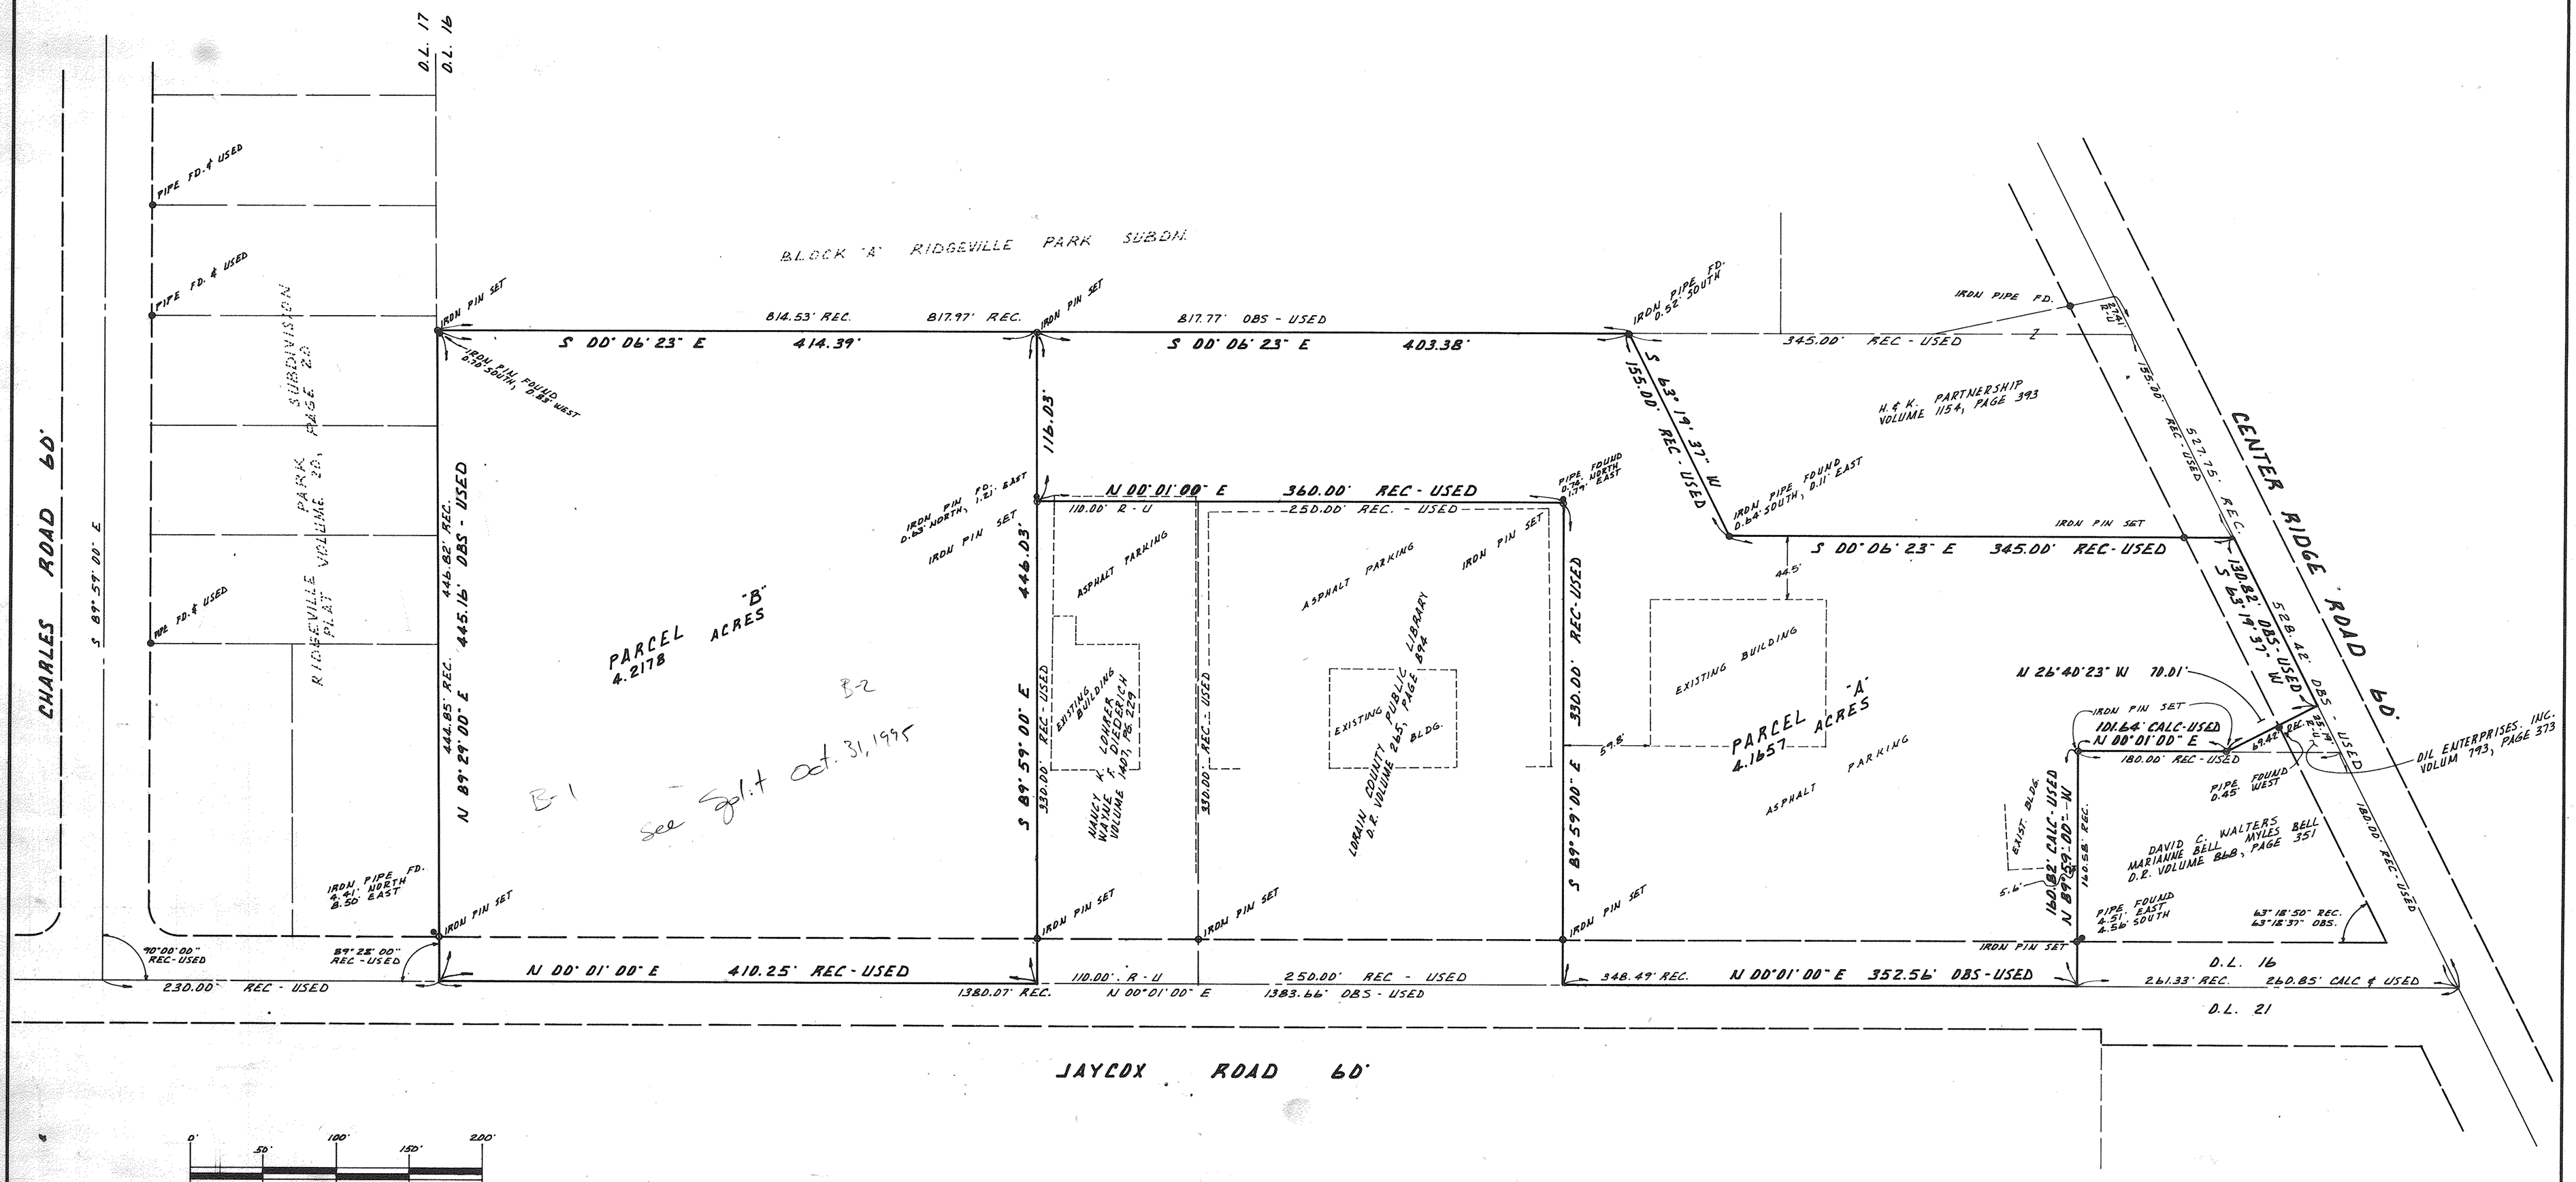

I declare this plat to be a true representation of an actual field survey made by me in November, 1994, performed to the standards set forth in ORC 4733-37 and correct to the best of my knowledge and belief.
Distances are given in feet and decimal parts thereof.
North datum used is the bearing of record for the centerline of Jaycox Road.
Property corners were found or set as indicated.

Donald E. Himes

STATE OF OHIO
DONALD E. HIMES
6163
REGISTERED SURVEYOR

ZWICK ASSOCIATES, INC.
engineers • surveyors
1344 W. BAGLEY ROAD, BEREA, OHIO 44017-2912 (216) 891-1492

PLAT OF SURVEY & PARCEL SPLIT

MADE FOR

NANCY K. LOHRER & WAYNE F. DIEDERICH
DEED VOLUME 1407, PAGE 229

CITY OF NORTH RIDGEVILLE
LORAIN COUNTY OHIO

DESIGNED	DRAWN	CHECKED
DATE NOV. 9, 1994	REVISED DEH	SCALE 1" = 50'