LORAIN

NO P.P. NUMBER AVAILABLE

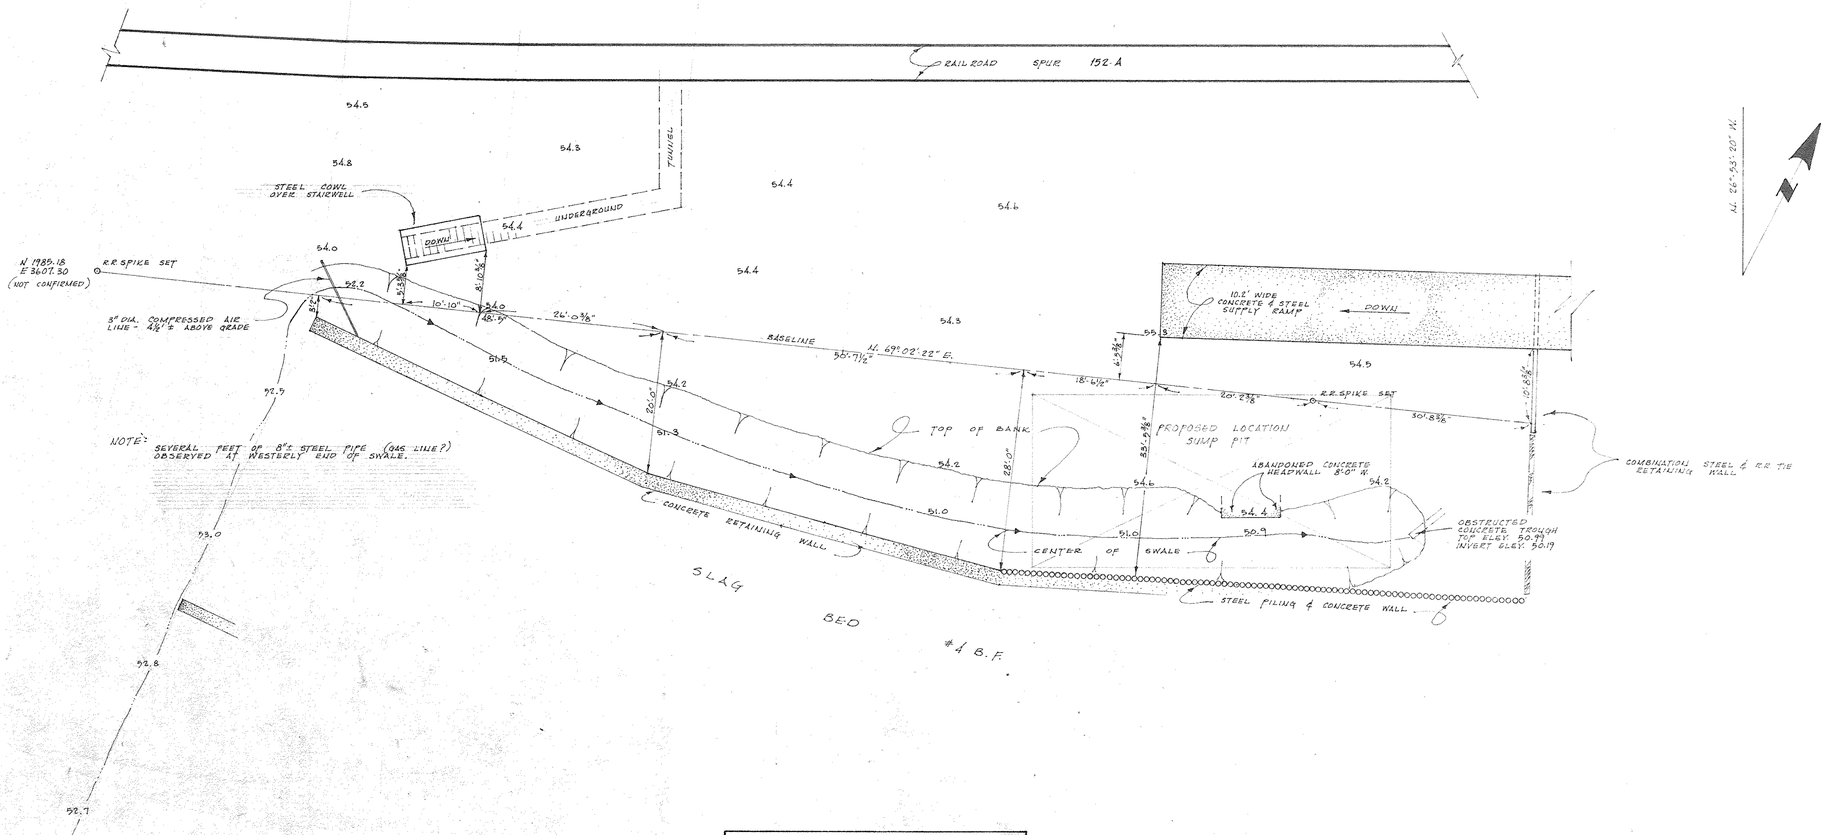

BENCH MARK - BRASS PLUG AT NORTHWEST CORNER OF SANITARY BUILDING ON THE WESTERLY SIDE OF LADLE HOUSE.
ELEVATION - 58.996 PLANT DATUM

UNITED STATES STEEL CORPORATION
LORAIN WORKS

MISCELLANEOUS LOCATIONS NORTHWEST OF BLAST FURNACE No. 4

SCALE: 1" = 10' MAY 1978

LAUNDON · SIMON · CAHL & ASSOCIATES, INC.
ENGINEERS SURVEYORS
JOB No. 78-720

03-00-088-101-016 In O.L. 91