16-00-031-000-036
034
16-D 042

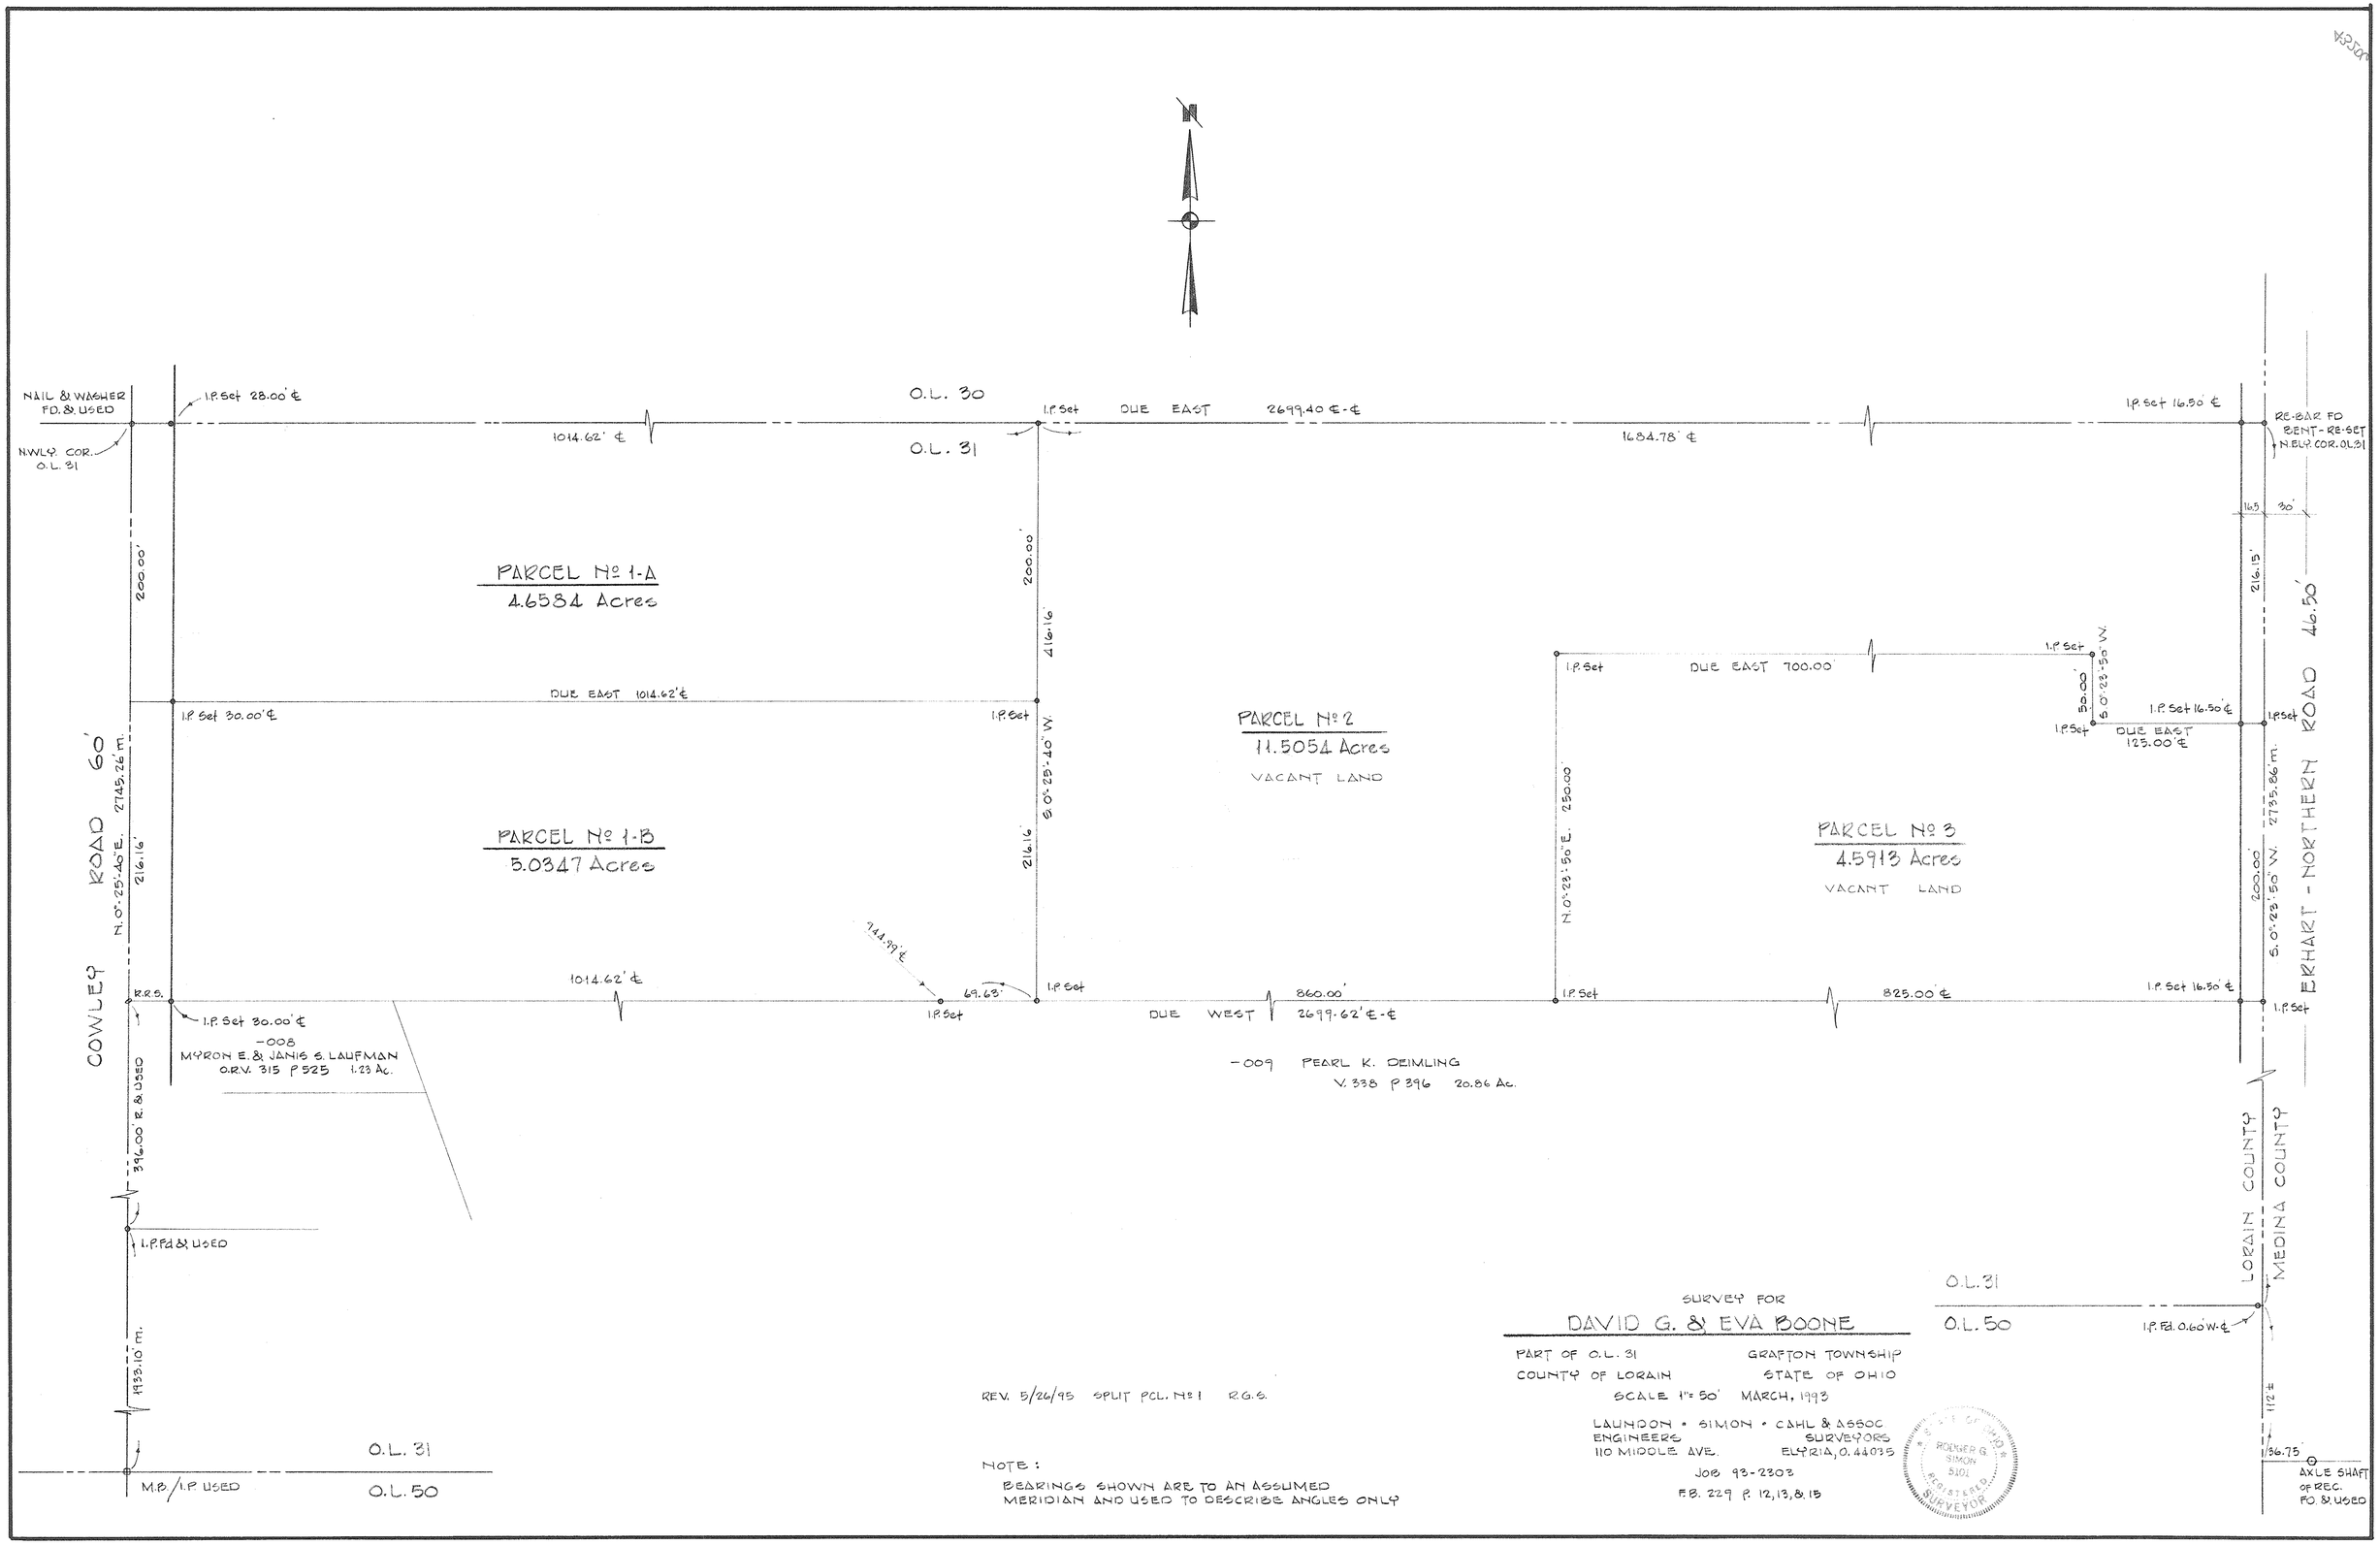

288