15-00-056-000-???
15-00-056-B

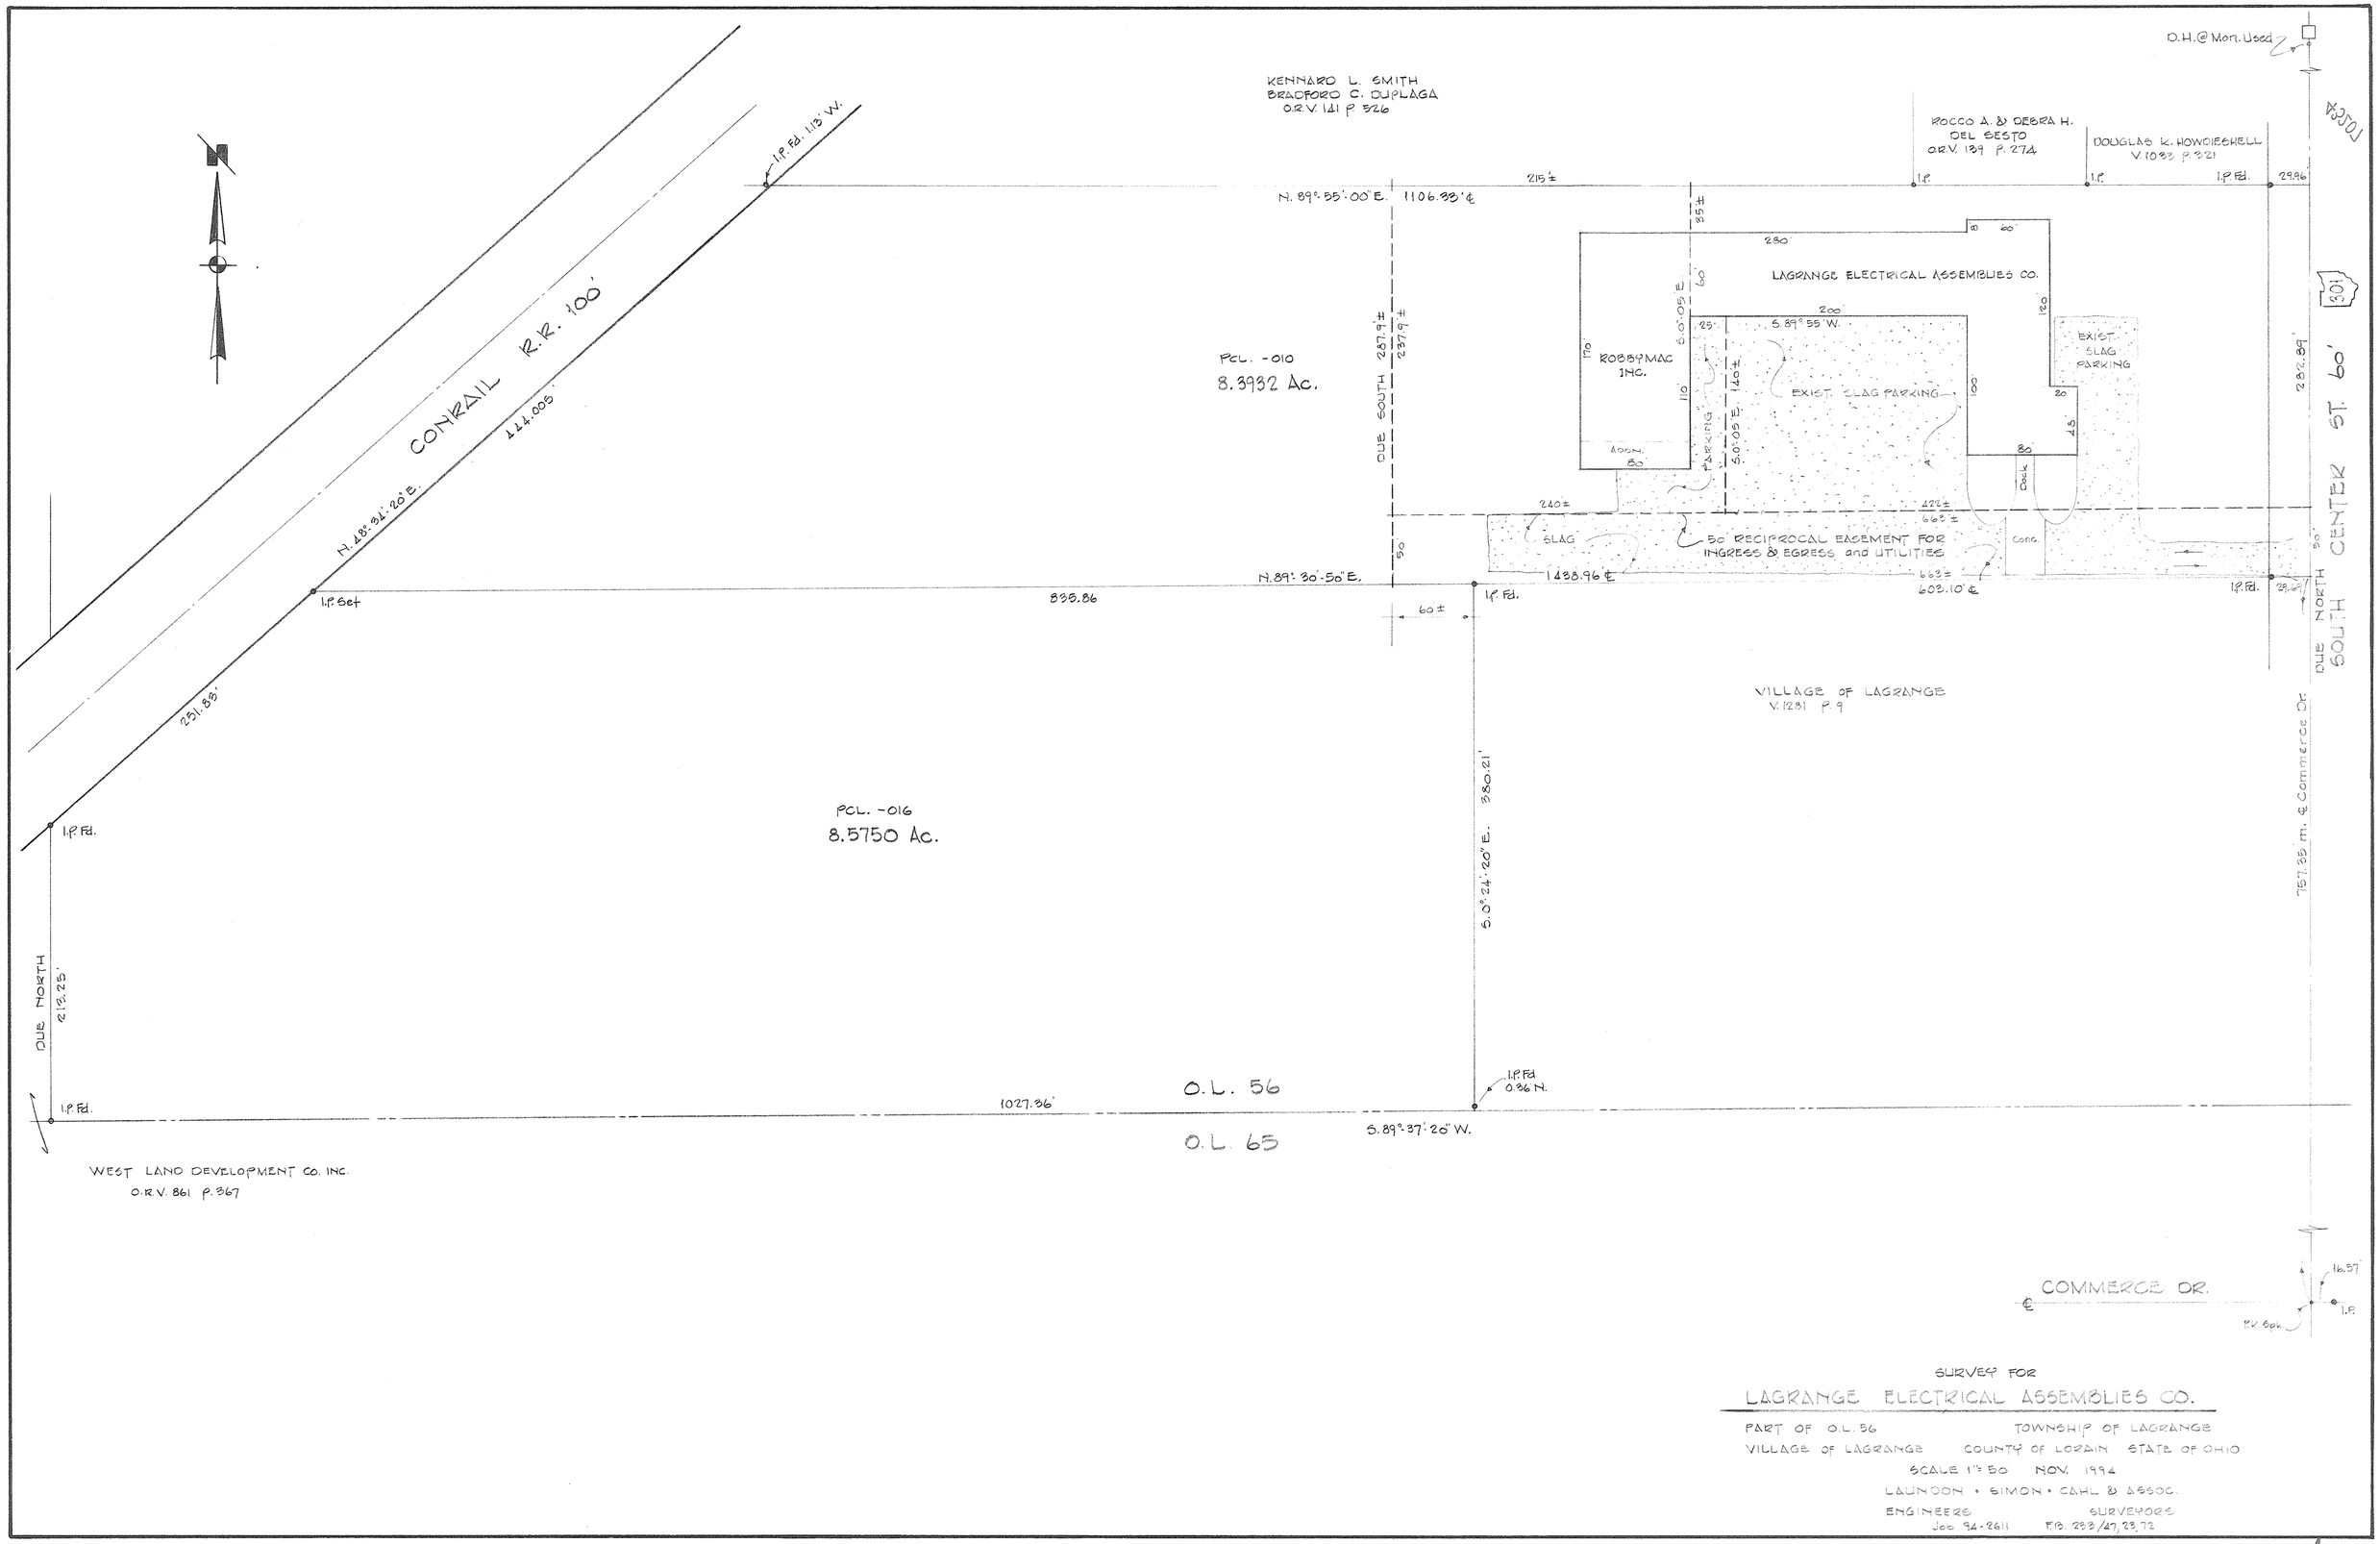

SURVEY FOR

LAGRANGE ELECTRICAL ASSEMBLIES CO.

PART OF O.L. 56 TOWNSHIP OF LAGRANGE

VILLAGE OF LAGRANGE COUNTY OF LORAIN STATE OF OHIO

SCALE 1" = 50 NOV. 1994

LAUNDON • SIMON • CAHL & ASSOC.

ENGINEERS SURVEYORS

Job 94-2611 F.B. 233/47, 23, 72

314