15-00-022-000-035
15-A

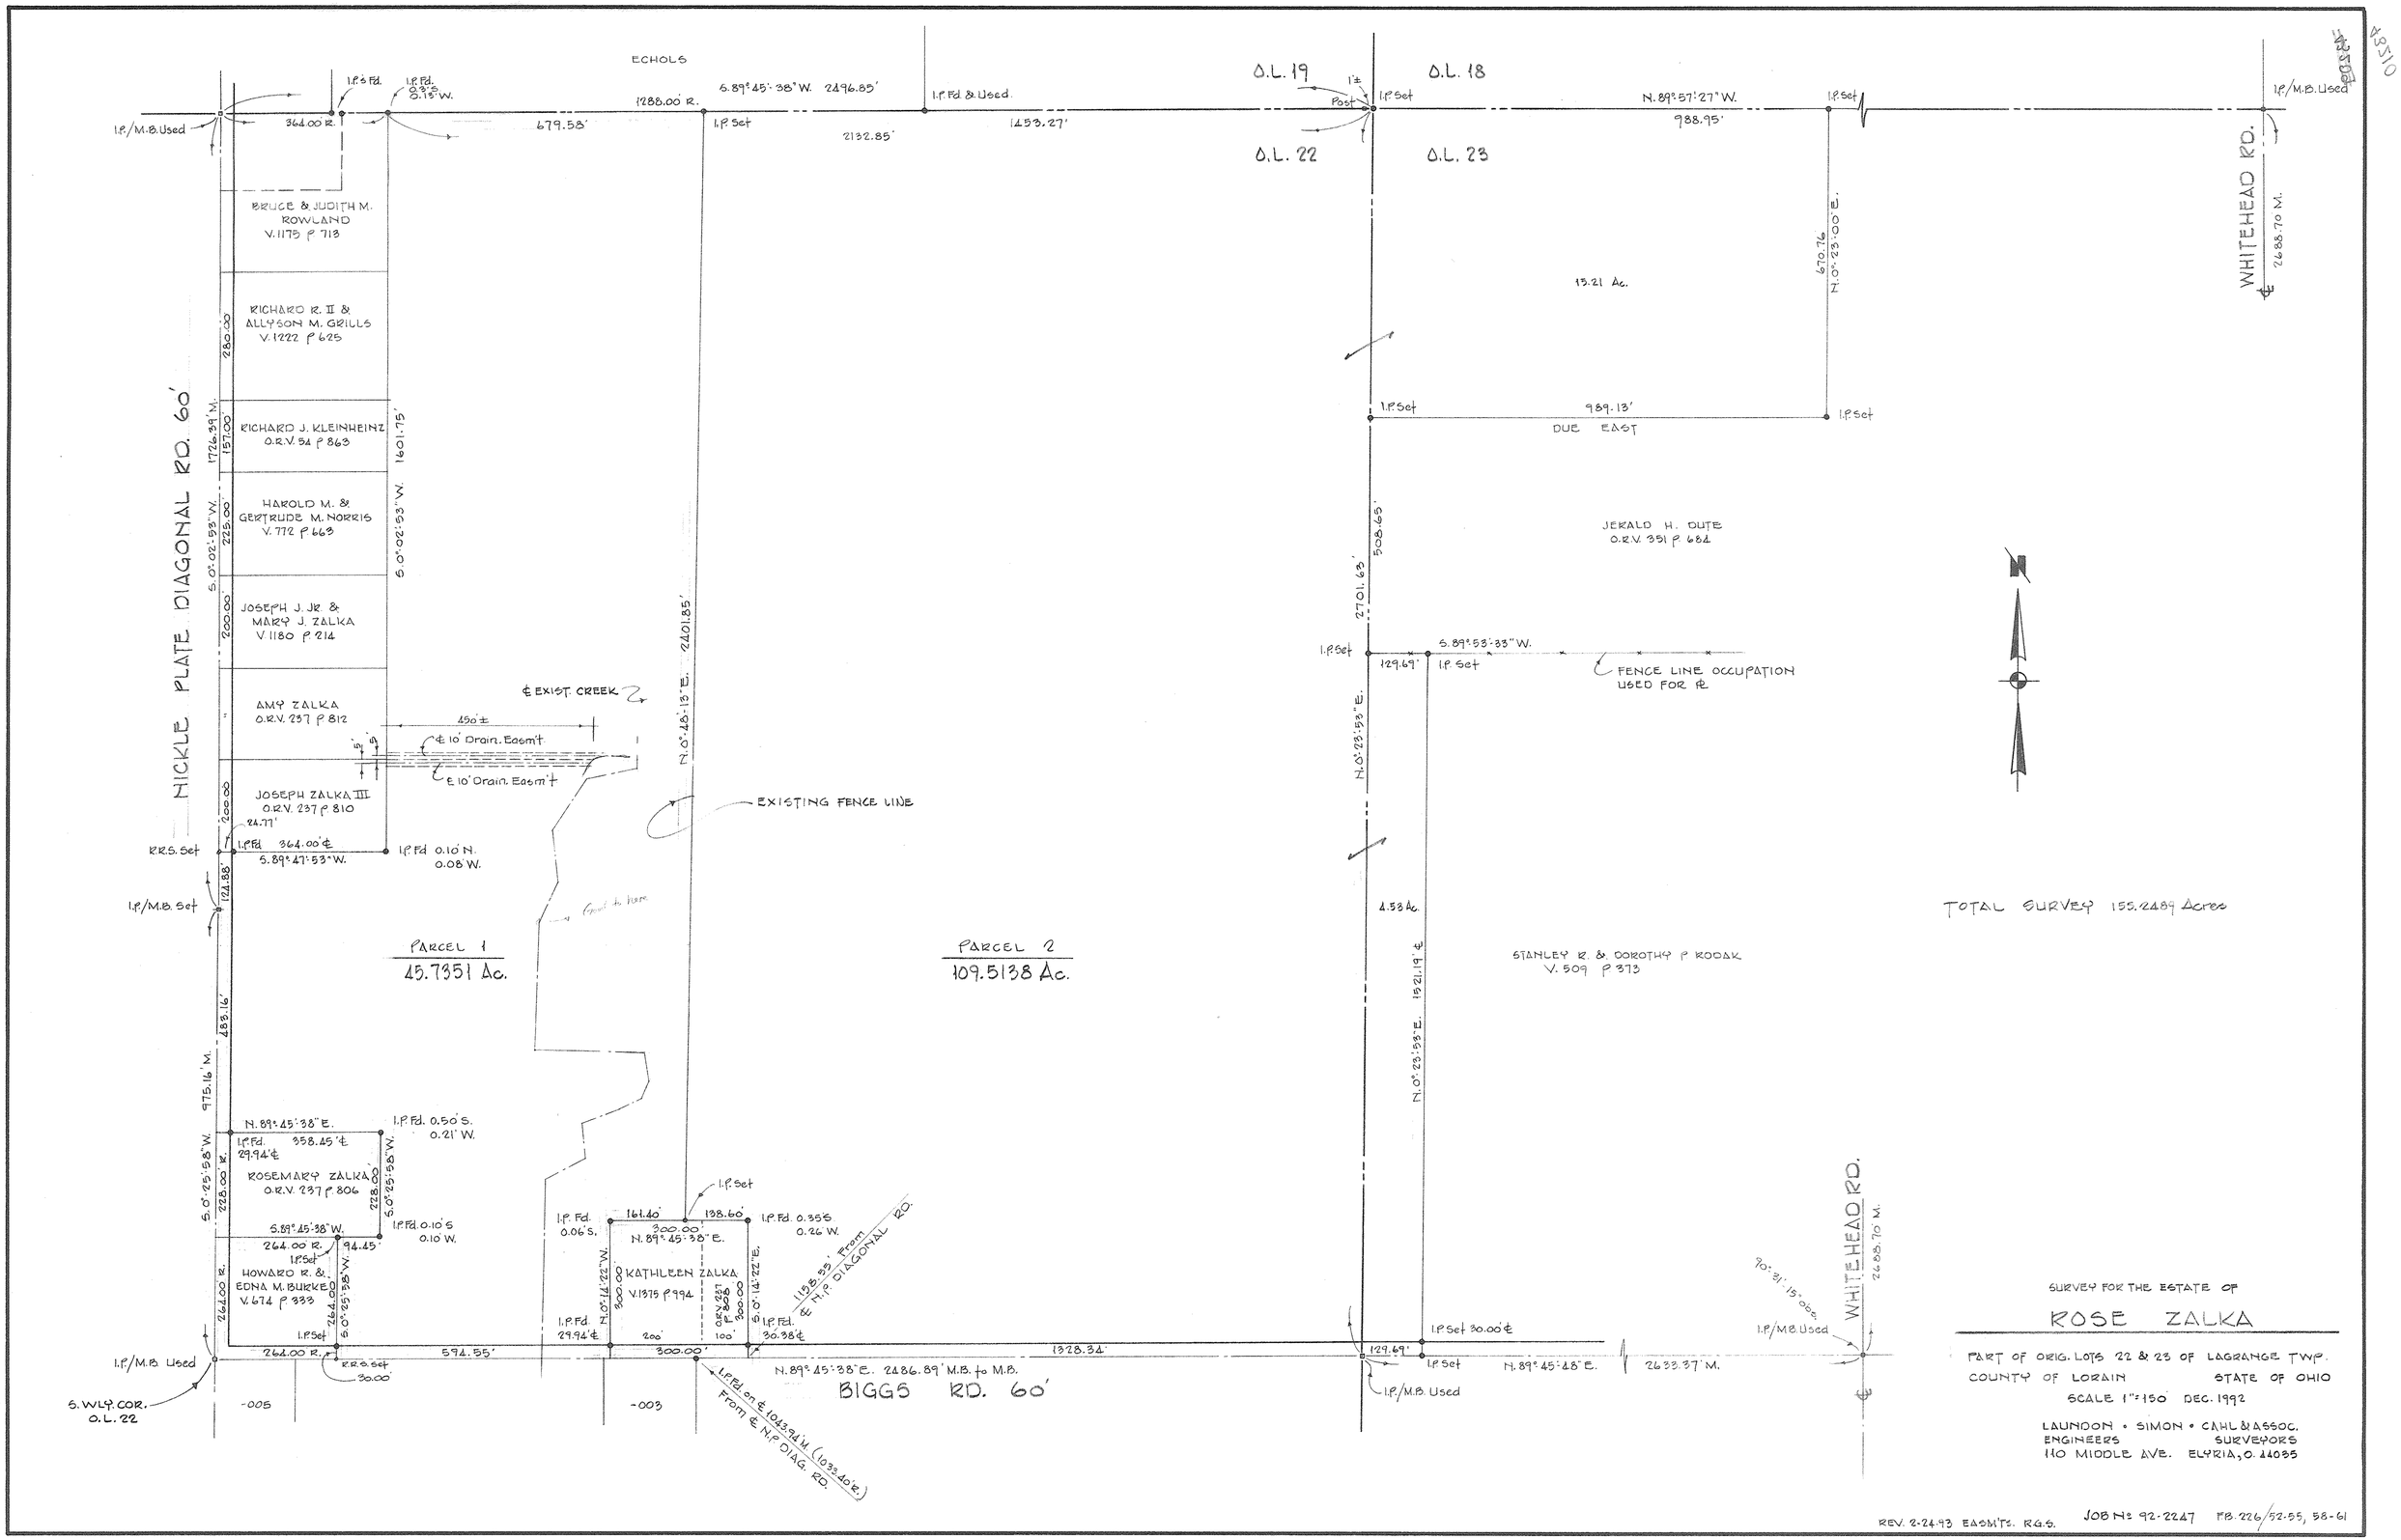


285