15-00-014-000-023
15-C

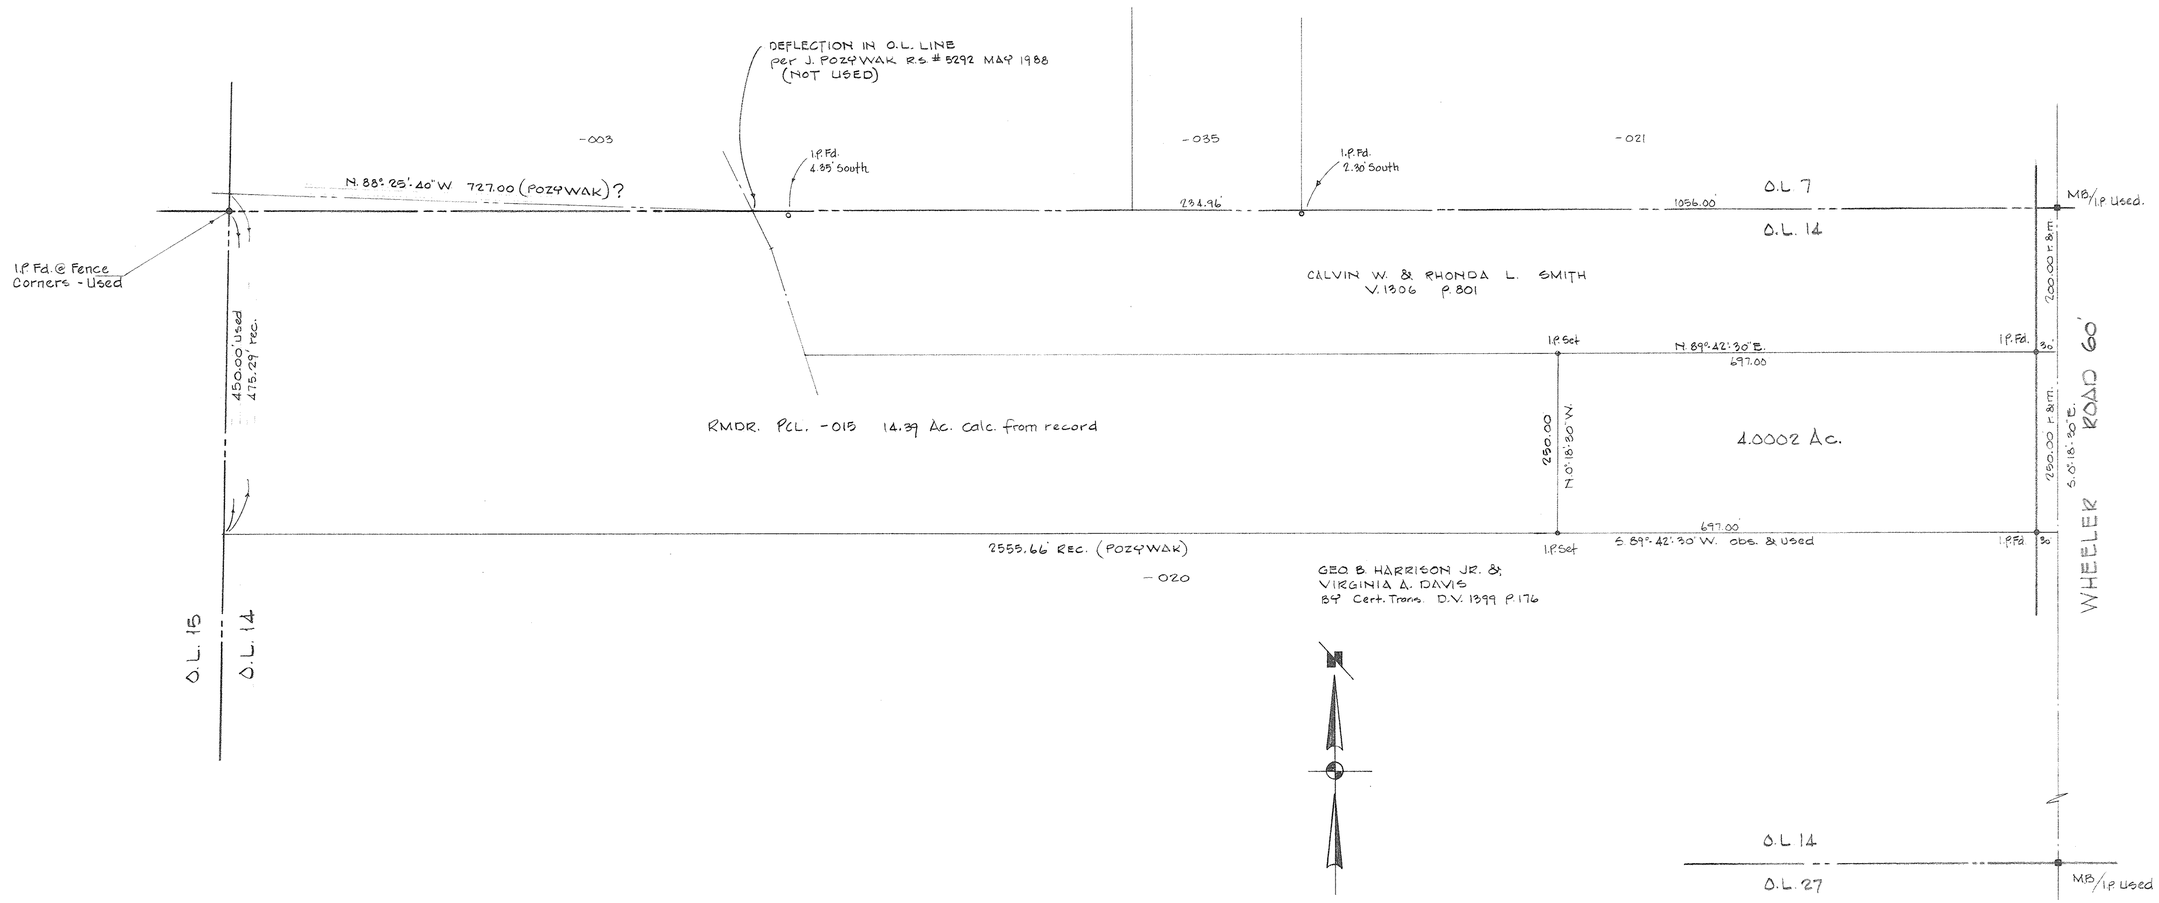

SURVEY FOR

CALVIN W. & RHONDA L. SMITH

PART OF O.L. 14 — TOWNSHIP OF LAGRANGE

COUNTY OF LORAIN — STATE OF OHIO

SCALE 1" = 100 — MARCH, 1992

LAUNDON · SIMON · CAHL & ASSOC.

ENGINEERS — SURVEYORS

JOB No: 92-2168

F.B. 223 P. 11

REV 4-6-92 RGS.

280