03-00-106-A,B
03-00-107-A,B
03-00-111-A,B
03-00-112-A,B

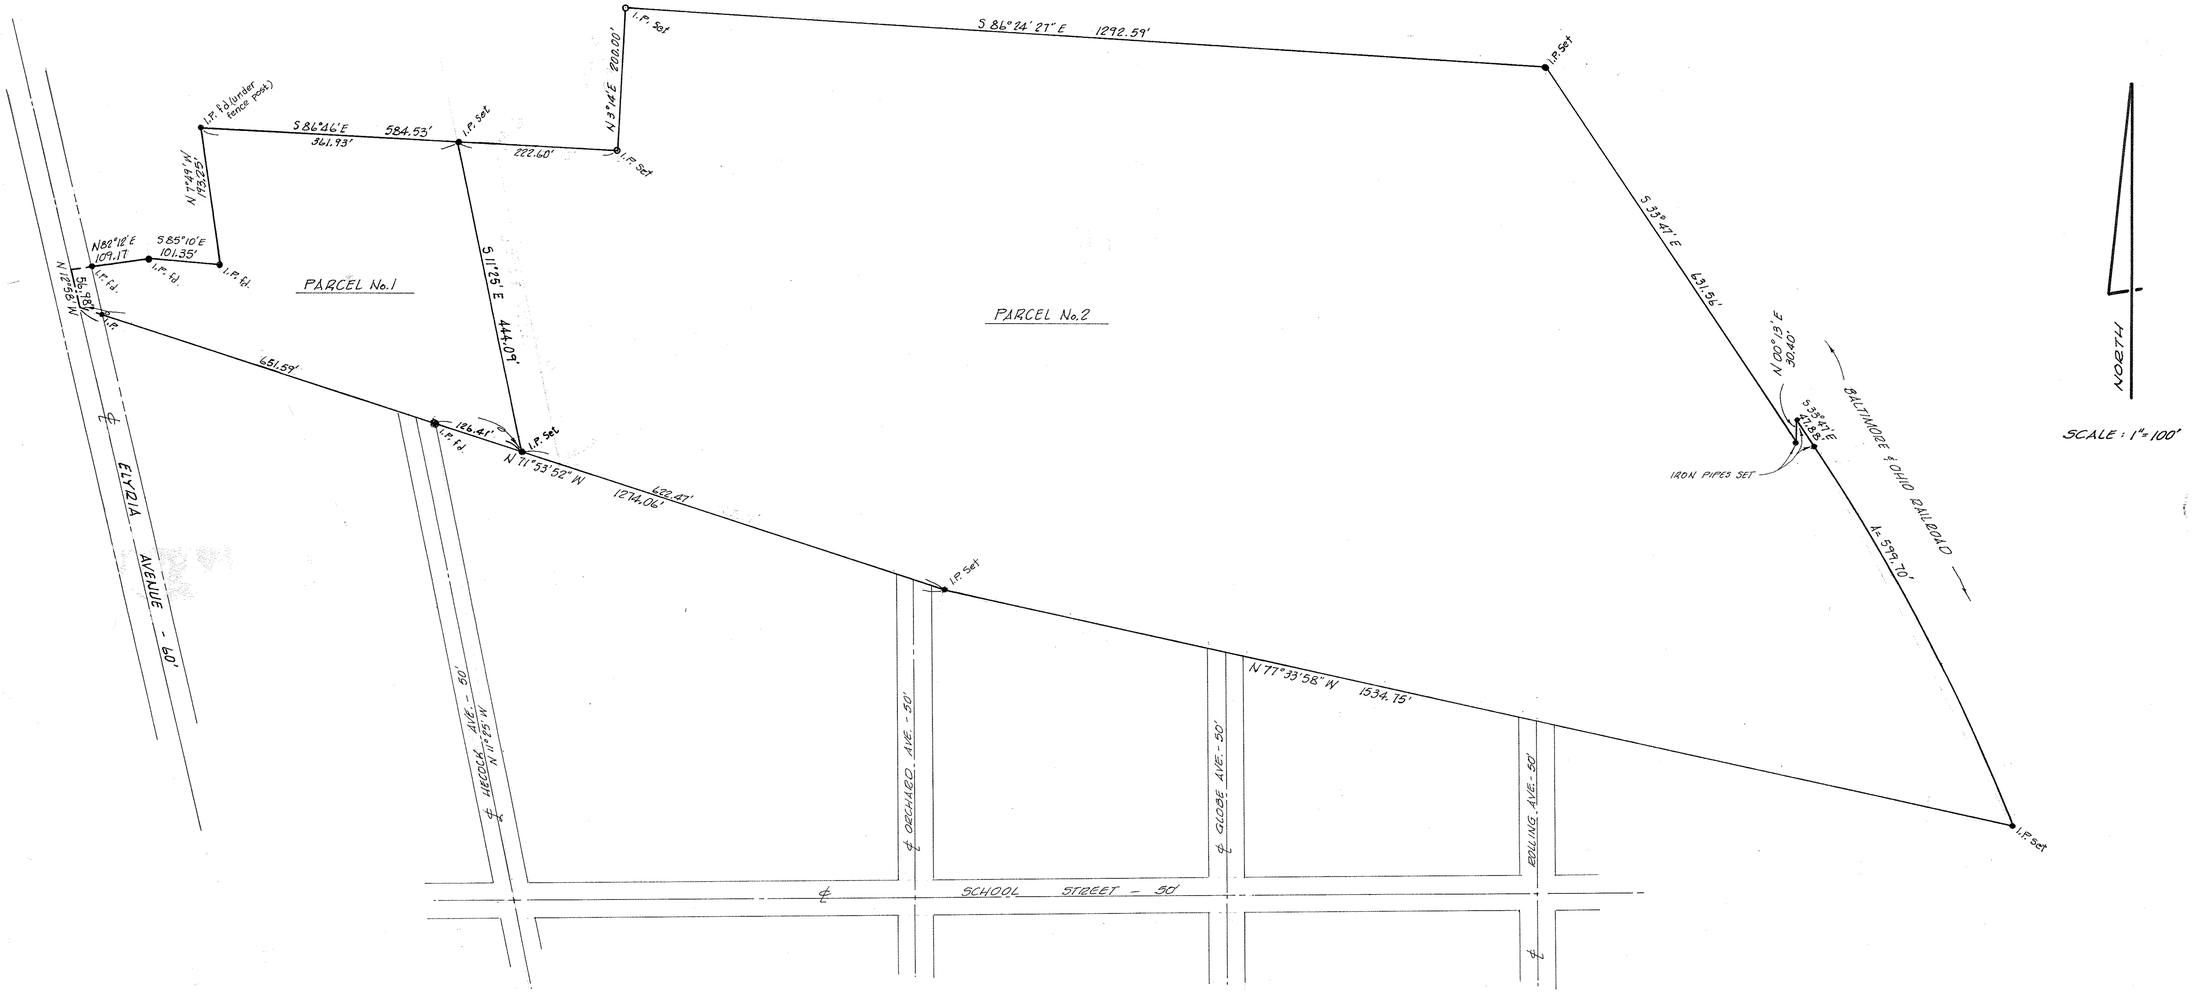

MAP of SURVEY
for
ANNA WOSKOBNICK
PART of ORIGINAL LOTS Nos. 106, 107, 111 and 112
SHEFFIELD TOWNSHIP, LORAIN COUNTY, OHIO

STATE OF OHIO
LAWRENCE V. McGLINCHY
4970
REGISTERED SURVEYOR

McGLINCHY and ASSOCIATES
REGISTERED ENGINEERS and SURVEYORS
ELYRIA OHIO
JUNE 30, 1977 JOB # 772100
REV. 7-21-77