SURVEY OF DEAN ROAD

Showing Location of Erie - Lorain County Line
Scale 1" = 200 on Details 1" = 50'
Plotted from data in field Book 192, Pg. 53-57
By John Pozywak

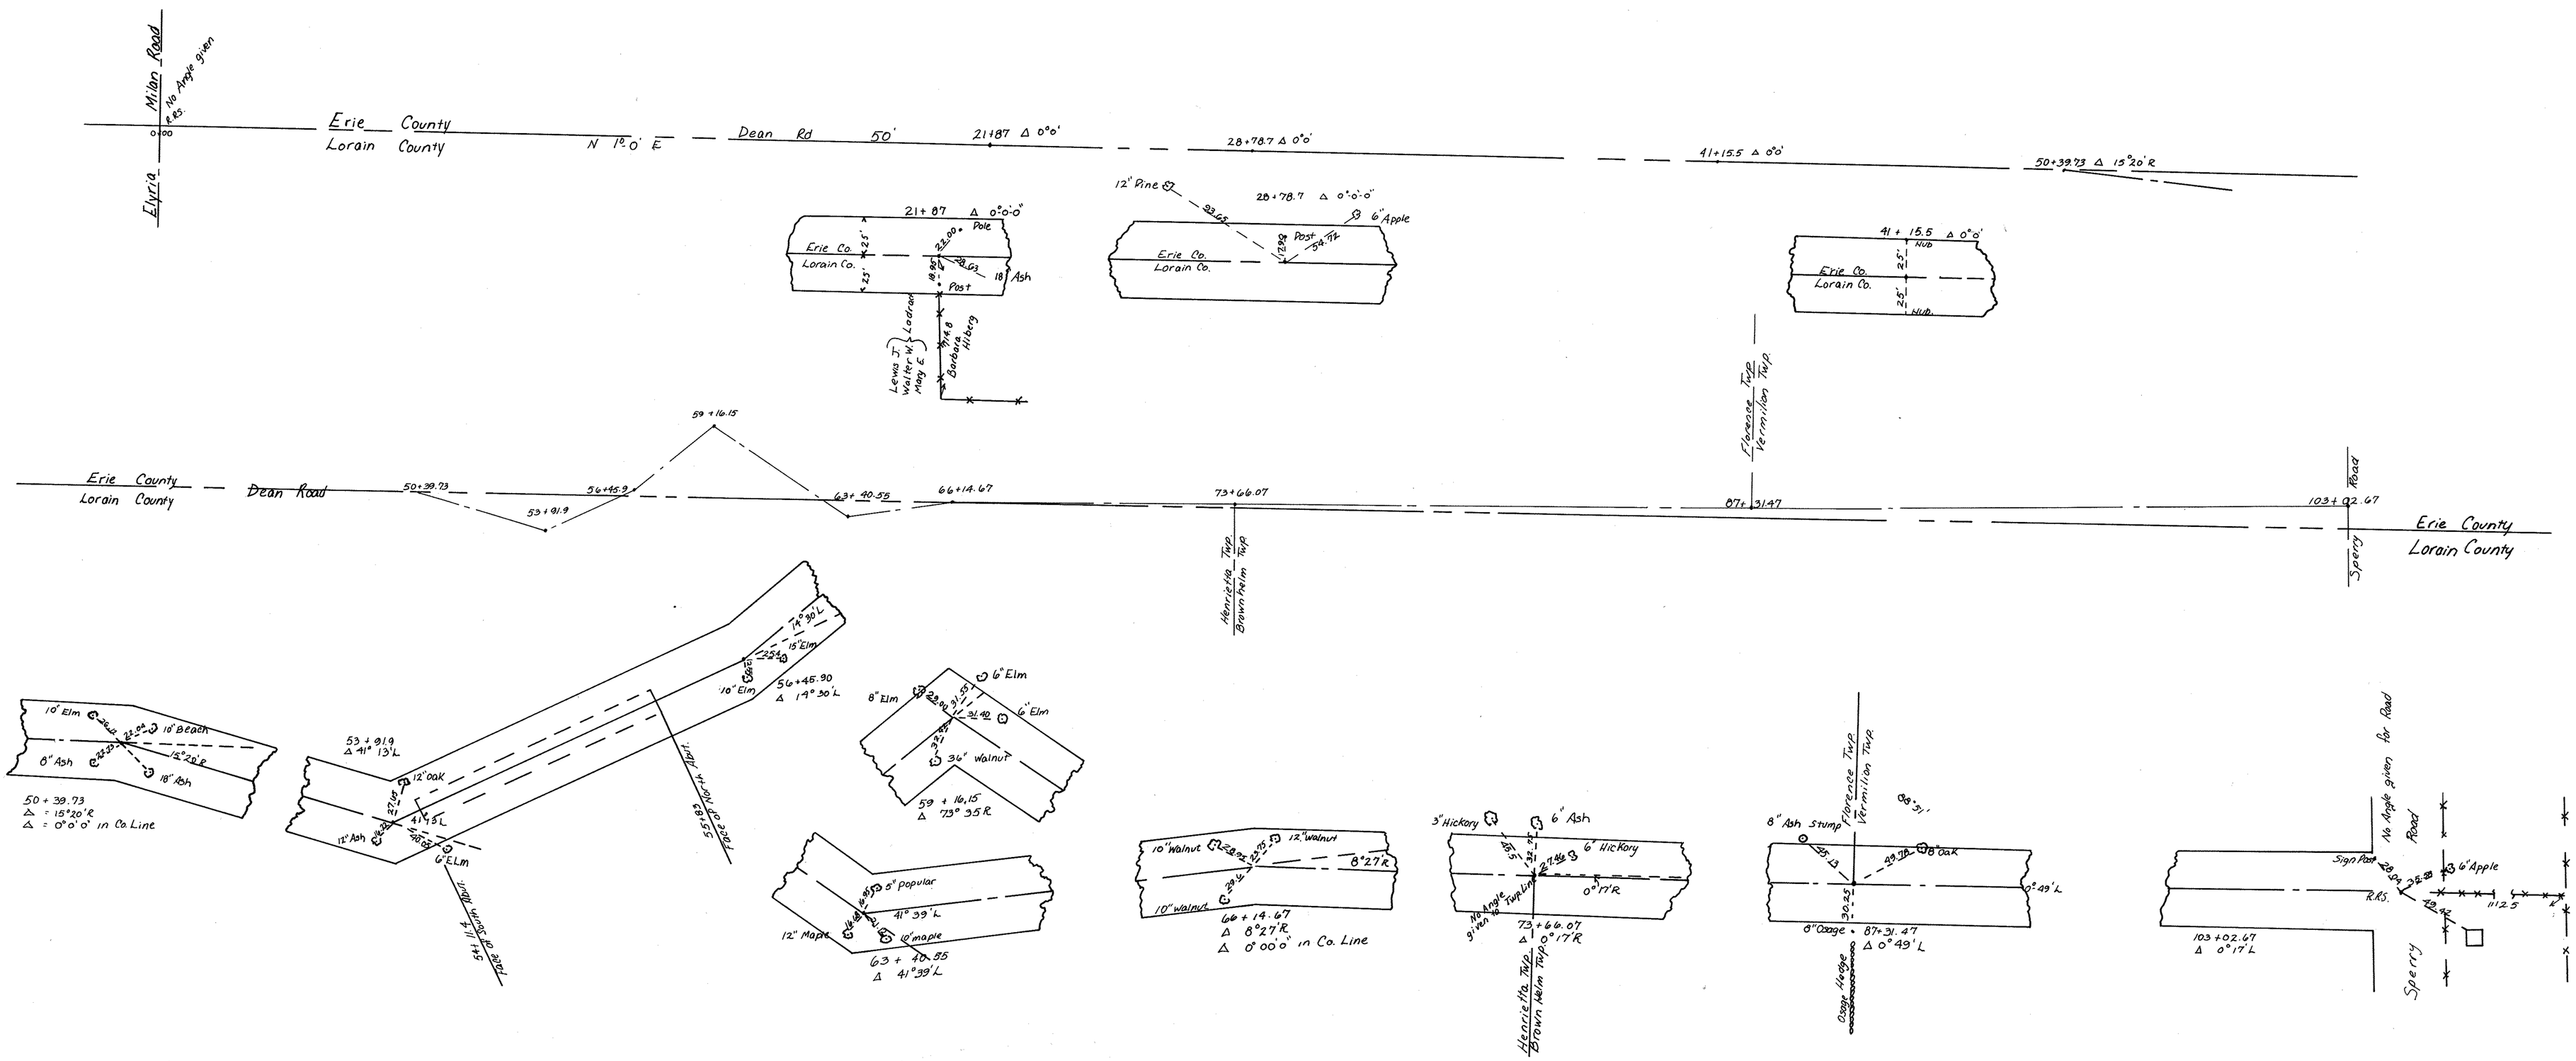

8-A

TRACED OFF OLD BLUE PRINT 3-24-81 Kenneth L. Ash

1584

DEAN Road