


DATE: DECEMBER 5, 1989
SCALE: 1" = 20'

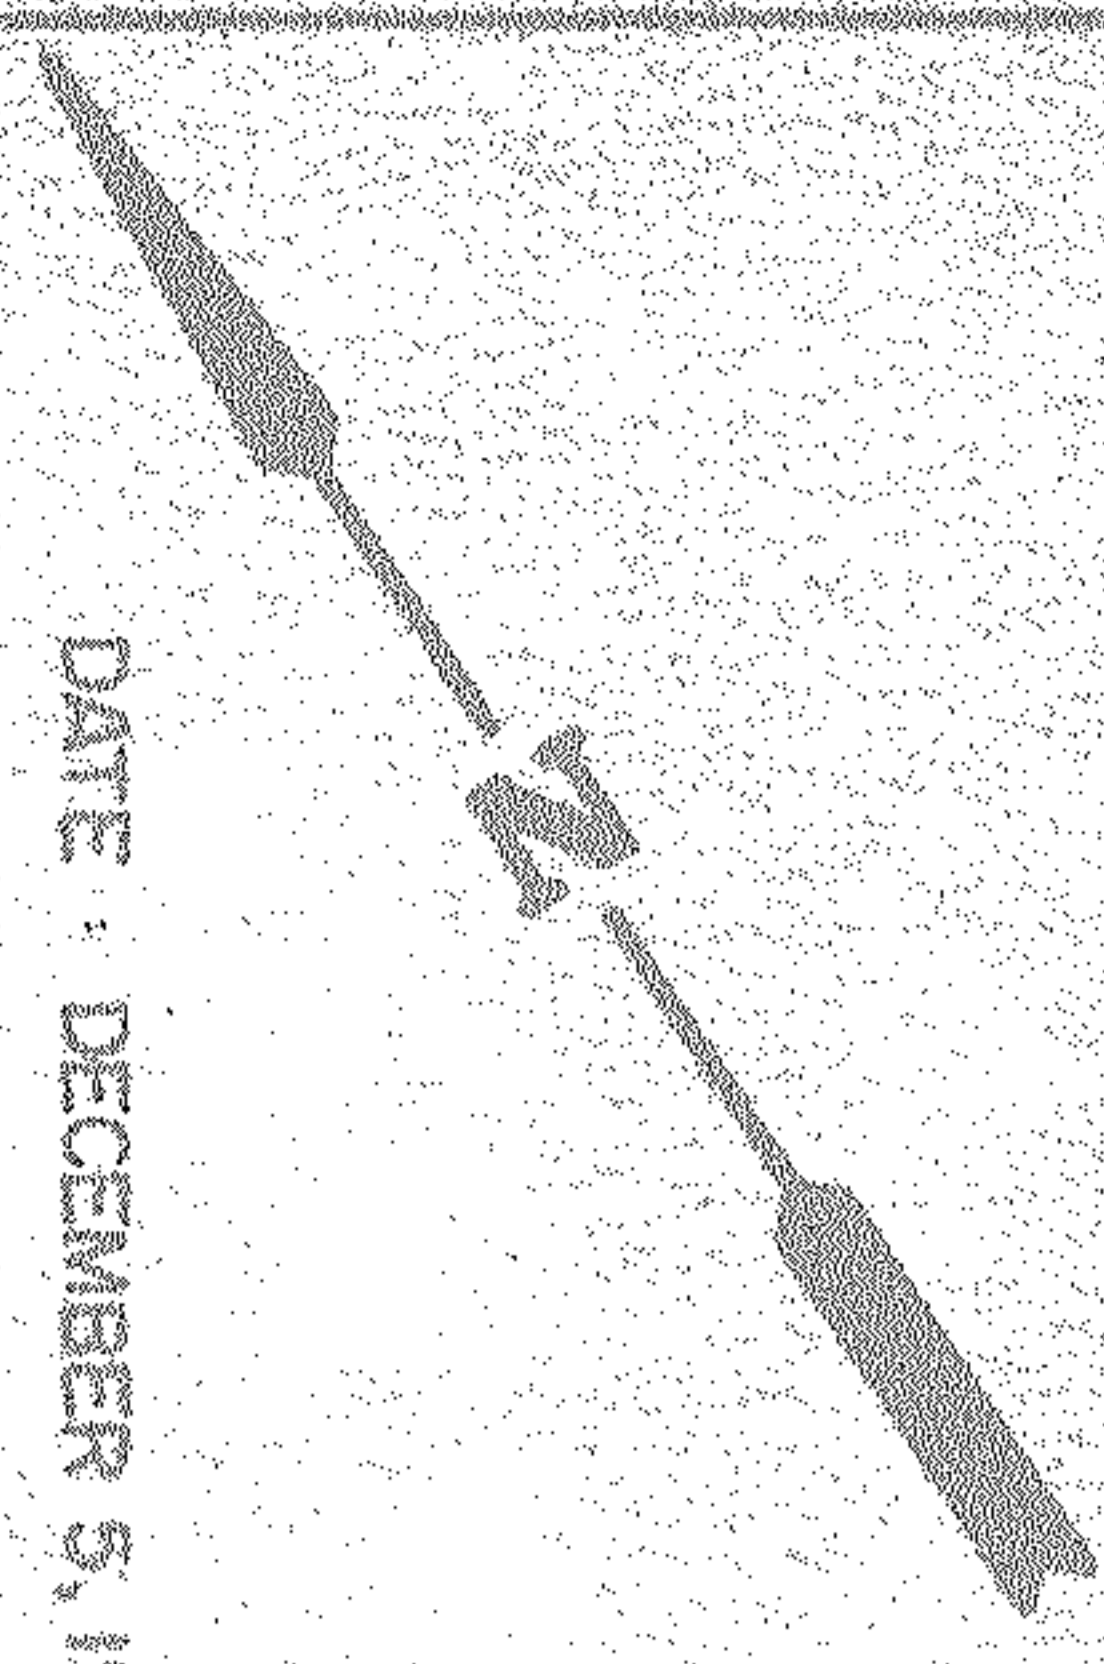


BOUNDARY SURVEY
FOR

CLARK OIL & REFINING CORP.


CLARK STATION 1174

ELYRIA, OHIO

FLORAL CT.

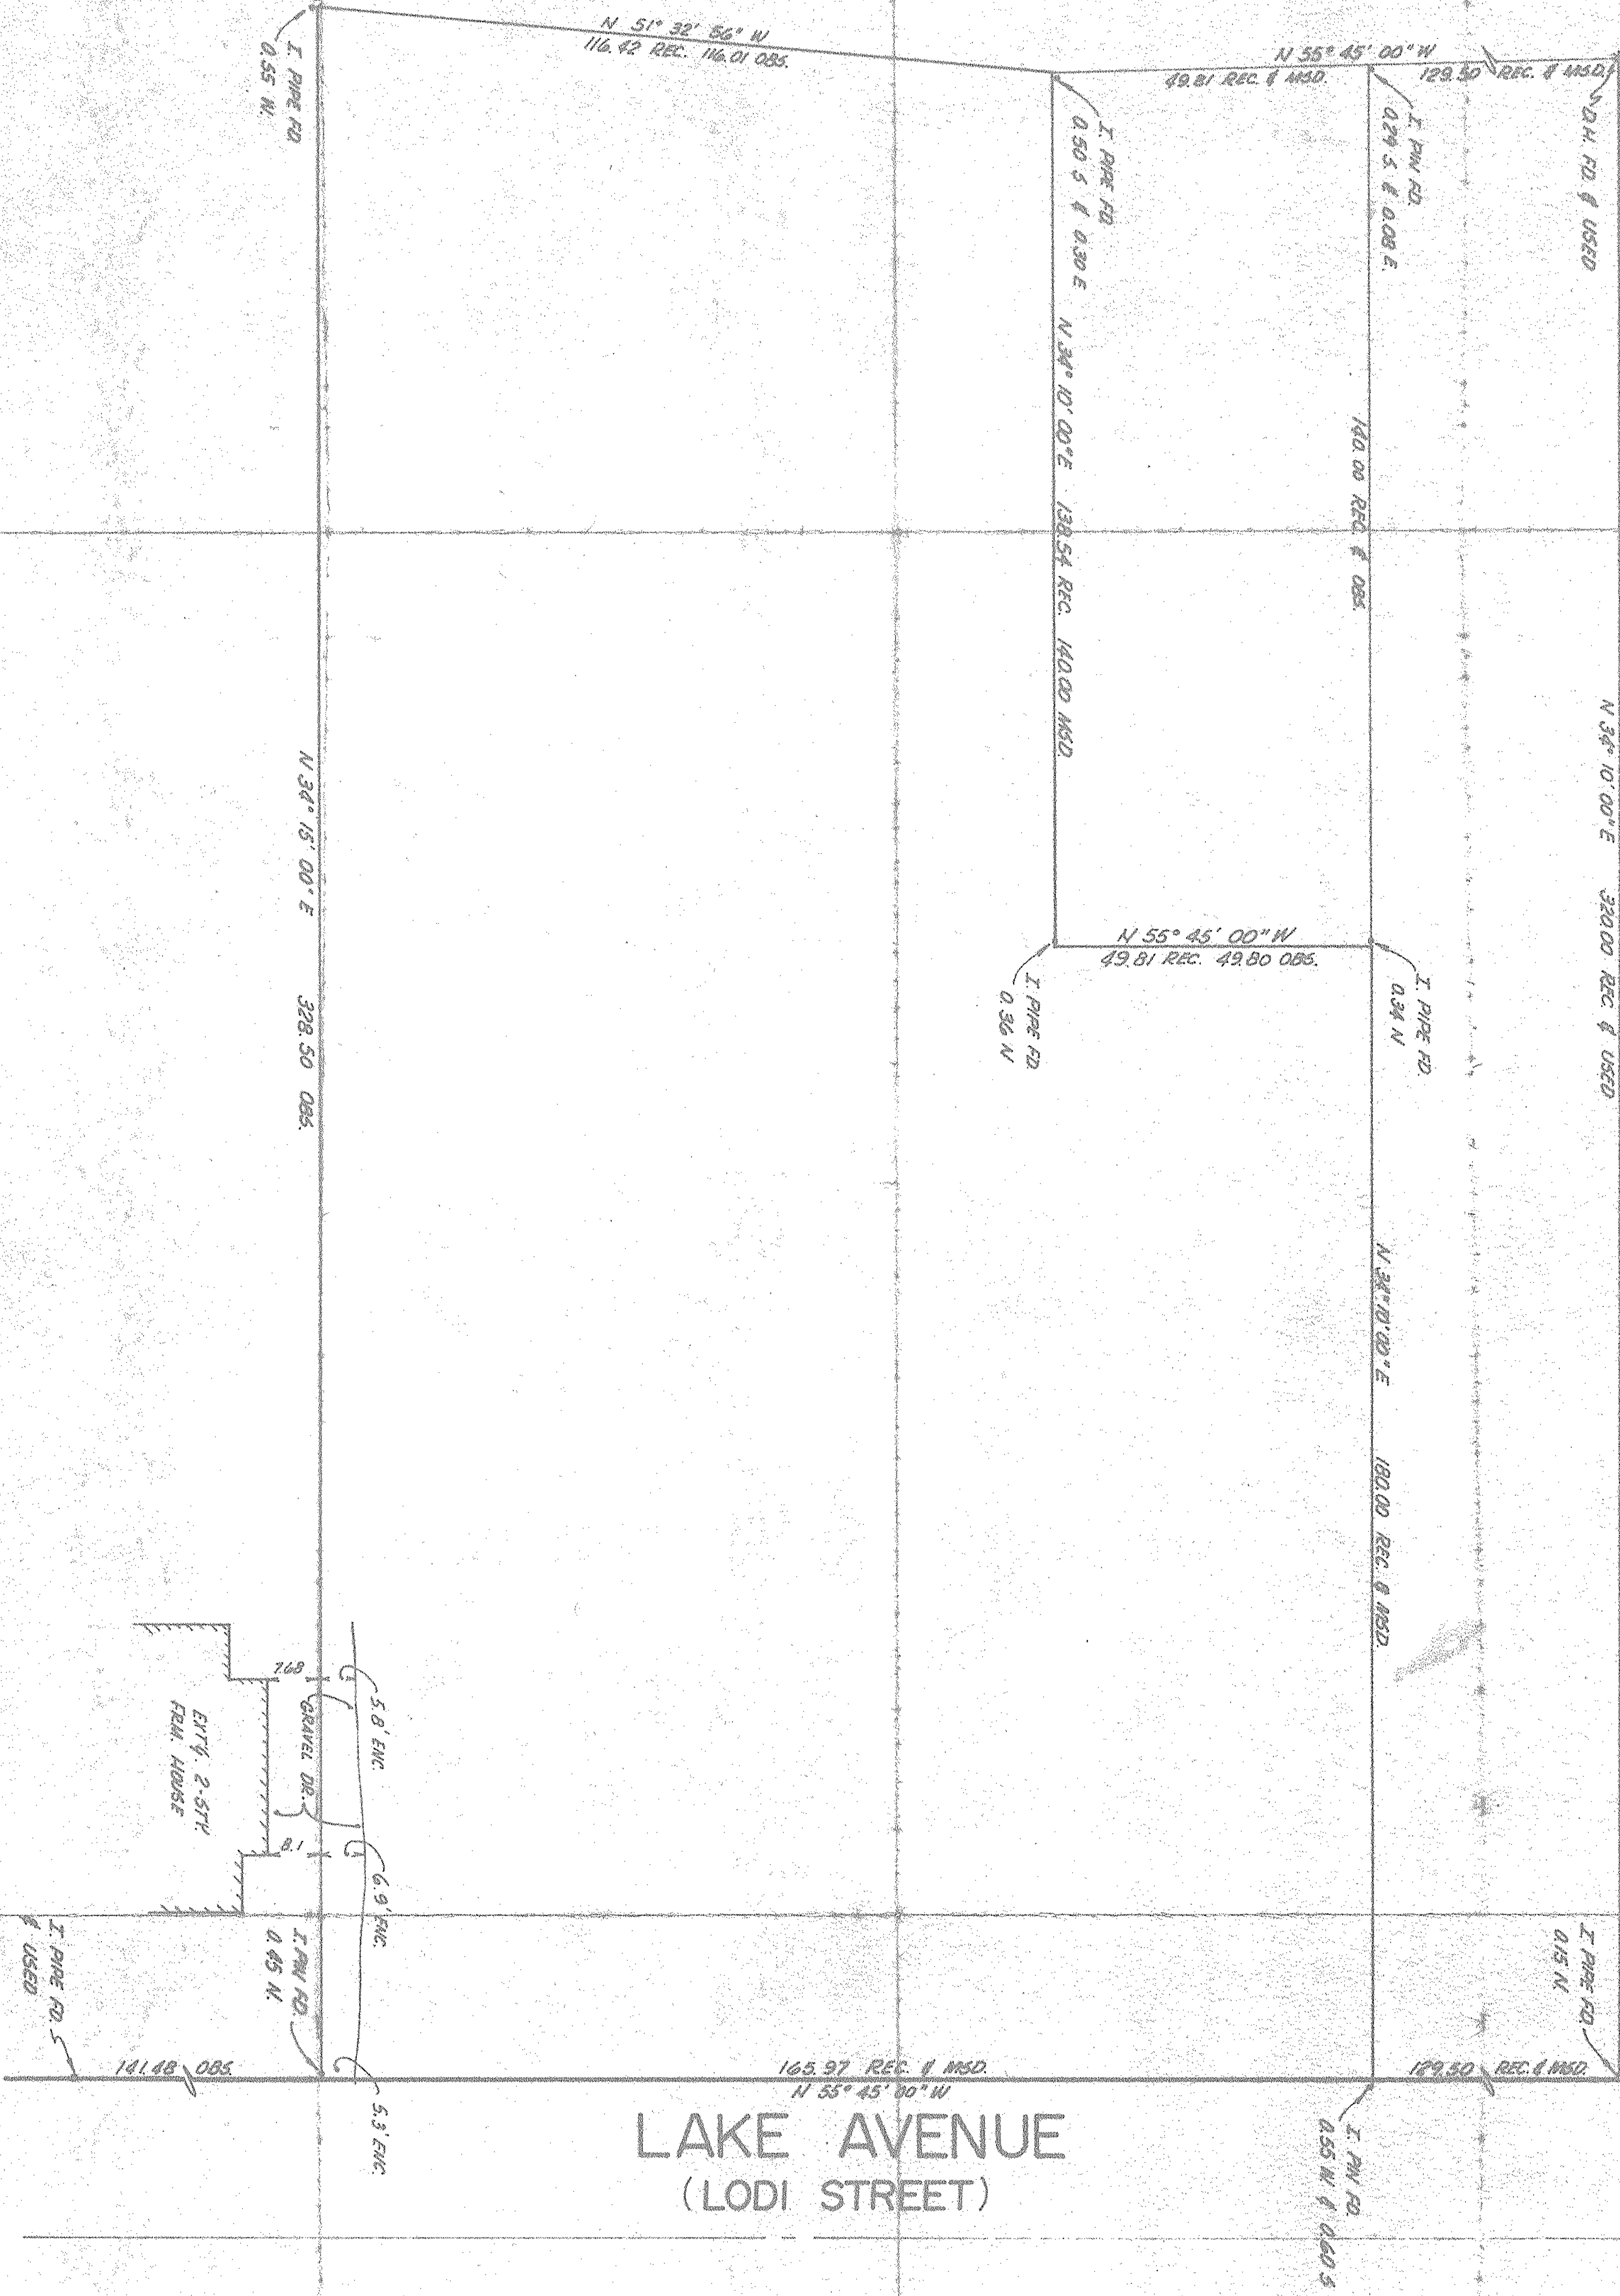

LAKE AVENUE
(LODI STREET)

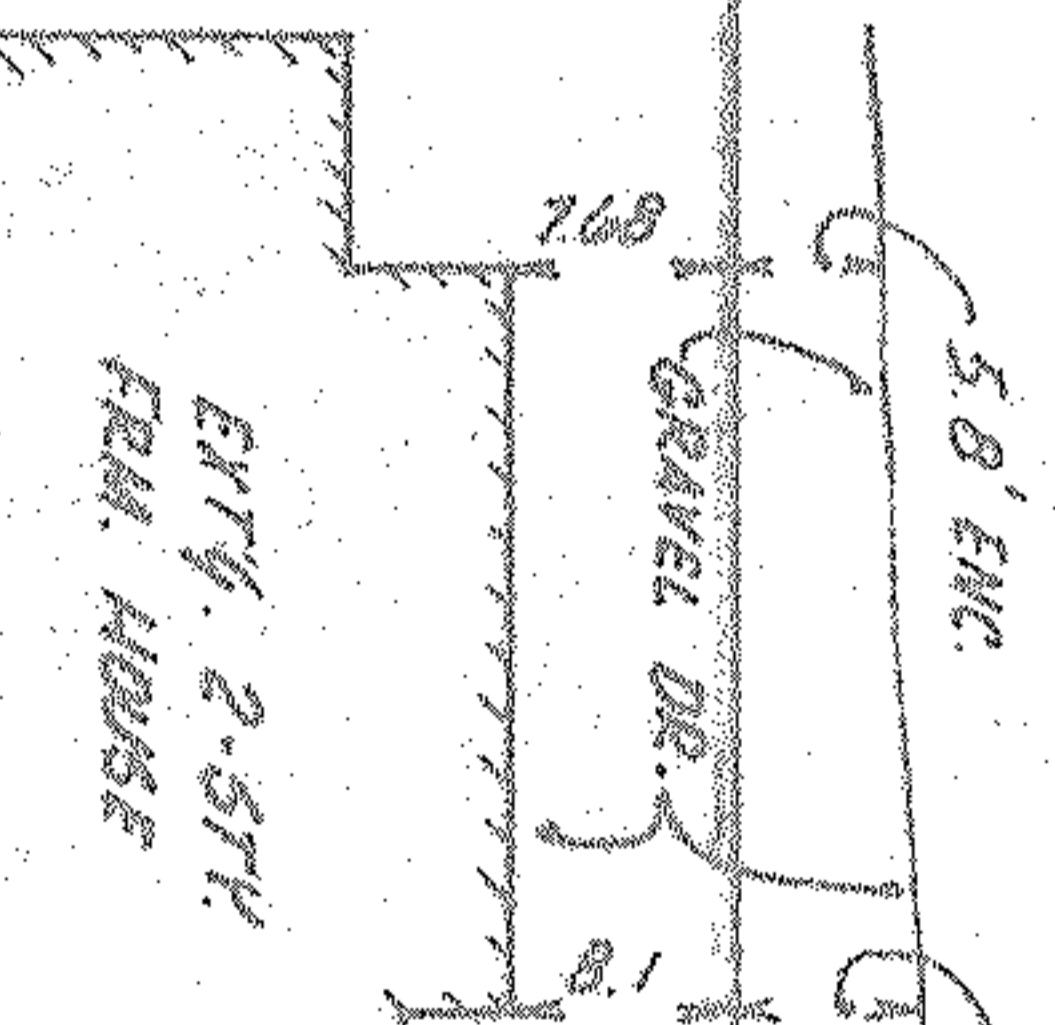

43553