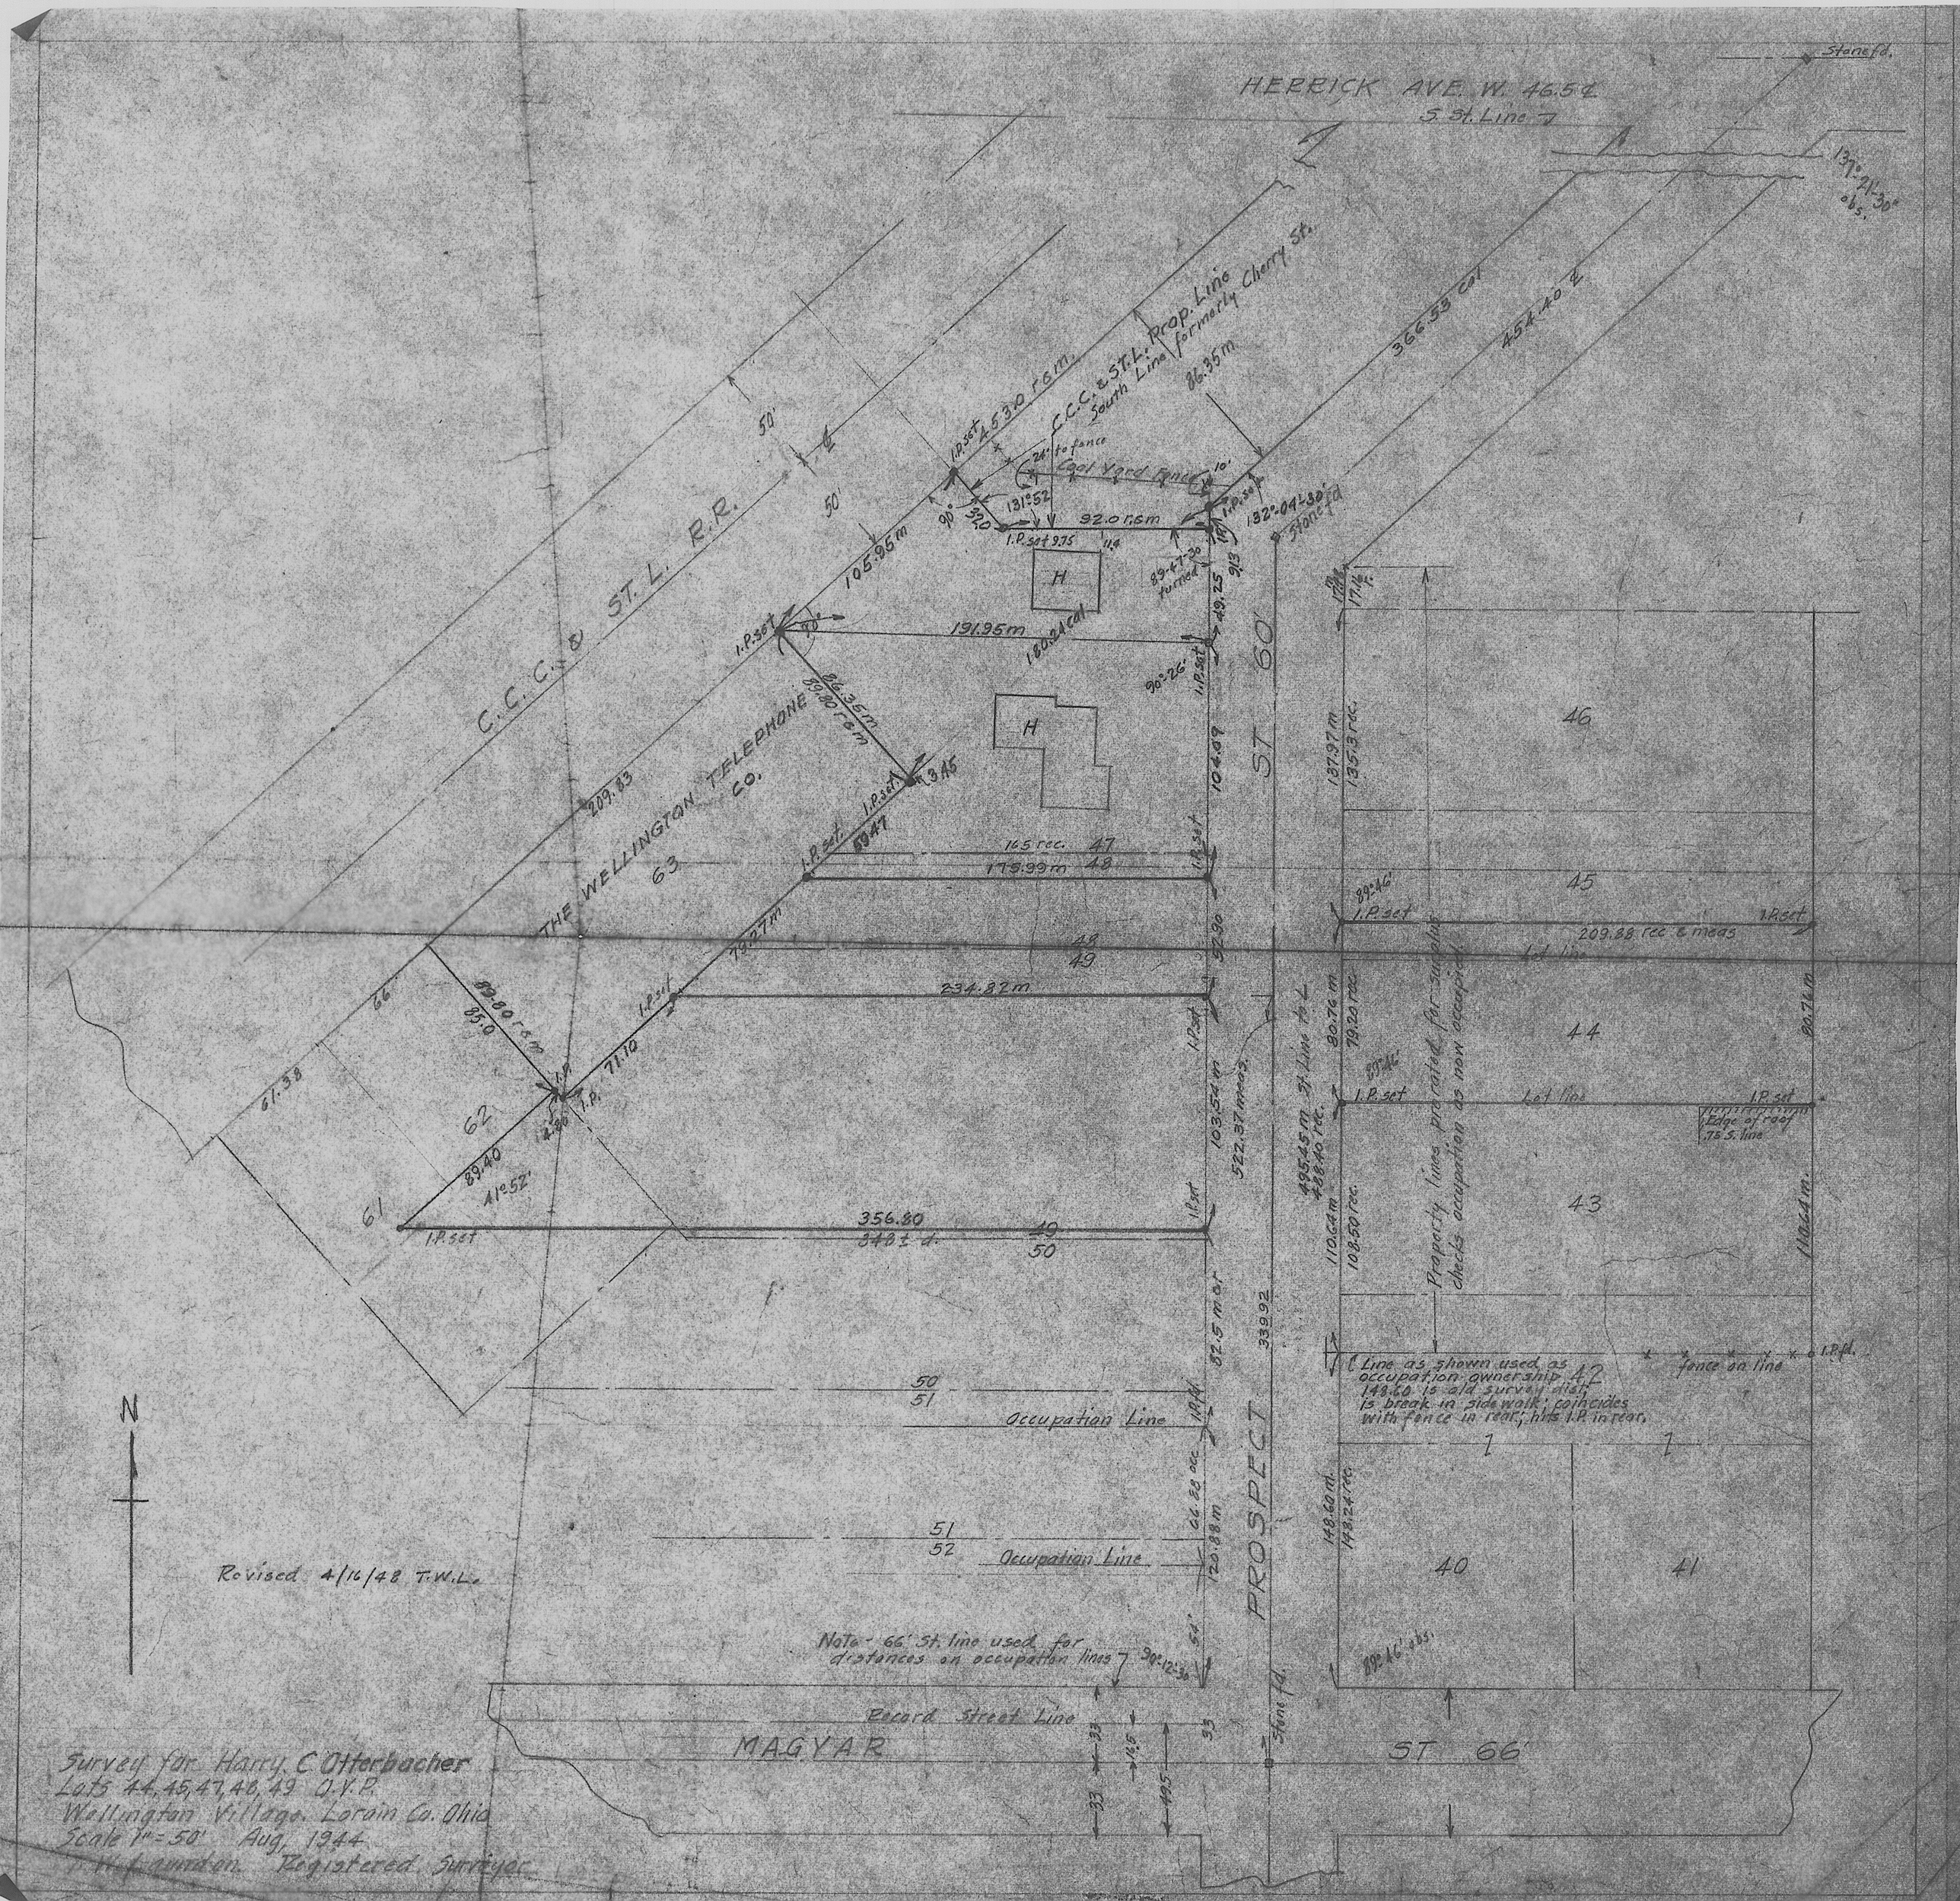
HERRICK AVE. W. 46.5 ℄
S. St. Line
Stone fd.
137°-21'-30" obs.
C.C.C. & ST. L. R.R.
C.C.C. & ST. L. Prop. Line
South Line formerly Cherry St.
453.0 r.c.m.
86.35 m
366.53 cal
454.40 ℄
Coal Yard Fence
24' to fence
131°52'
92.0 r.c.m
132°-04'-30"
Stone fd
105.95 m
191.95 m
180.24 cal
89-47-30 turned
90°26'
86.35 m
89.80 r.c.m
209.83
THE WELLINGTON TELEPHONE CO.
63
165 rec.
175.99 m
79.27 m
234.82 m
89.80 r.c.m
85.0
71.10
61.38
62
89.40
41°52'
61
356.80
348± d.
49
50
ST 60'
46
45
44
43
42
41
40
137.97 m
135.3 rec.
209.88 rec & meas
Lot line
Edge of roof .75 S. line
Property lines prorated for surplus checks occupation as now occupied
495.45 m St. Line to L
488.40 rec.
110.64 m
108.50 rec.
80.76 m
79.20 rec.
Line as shown used as occupation ownership 148.60 is old survey dist; is break in sidewalk; coincides with fence in rear; hits I.P. in rear.
fence on line
I.P. fd.
148.60 m.
148.24 rec.
89°46' obs.
PROSPECT
339.92
Occupation Line
Occupation Line
Note - 66' St. line used for distances on occupation lines
Record Street Line
MAGYAR
ST 66'
N
Revised 4/16/48 T.W.L.
Survey for Harry C Otterbacher
Lots 44, 45, 47, 48, 49 O.V.P.
Wellington Village. Lorain Co. Ohio
Scale 1" = 50' Aug, 1944
Registered Surveyor