


18-00-027-105-009  
 18-00-027-105-010  
 18-00-027-B

435510

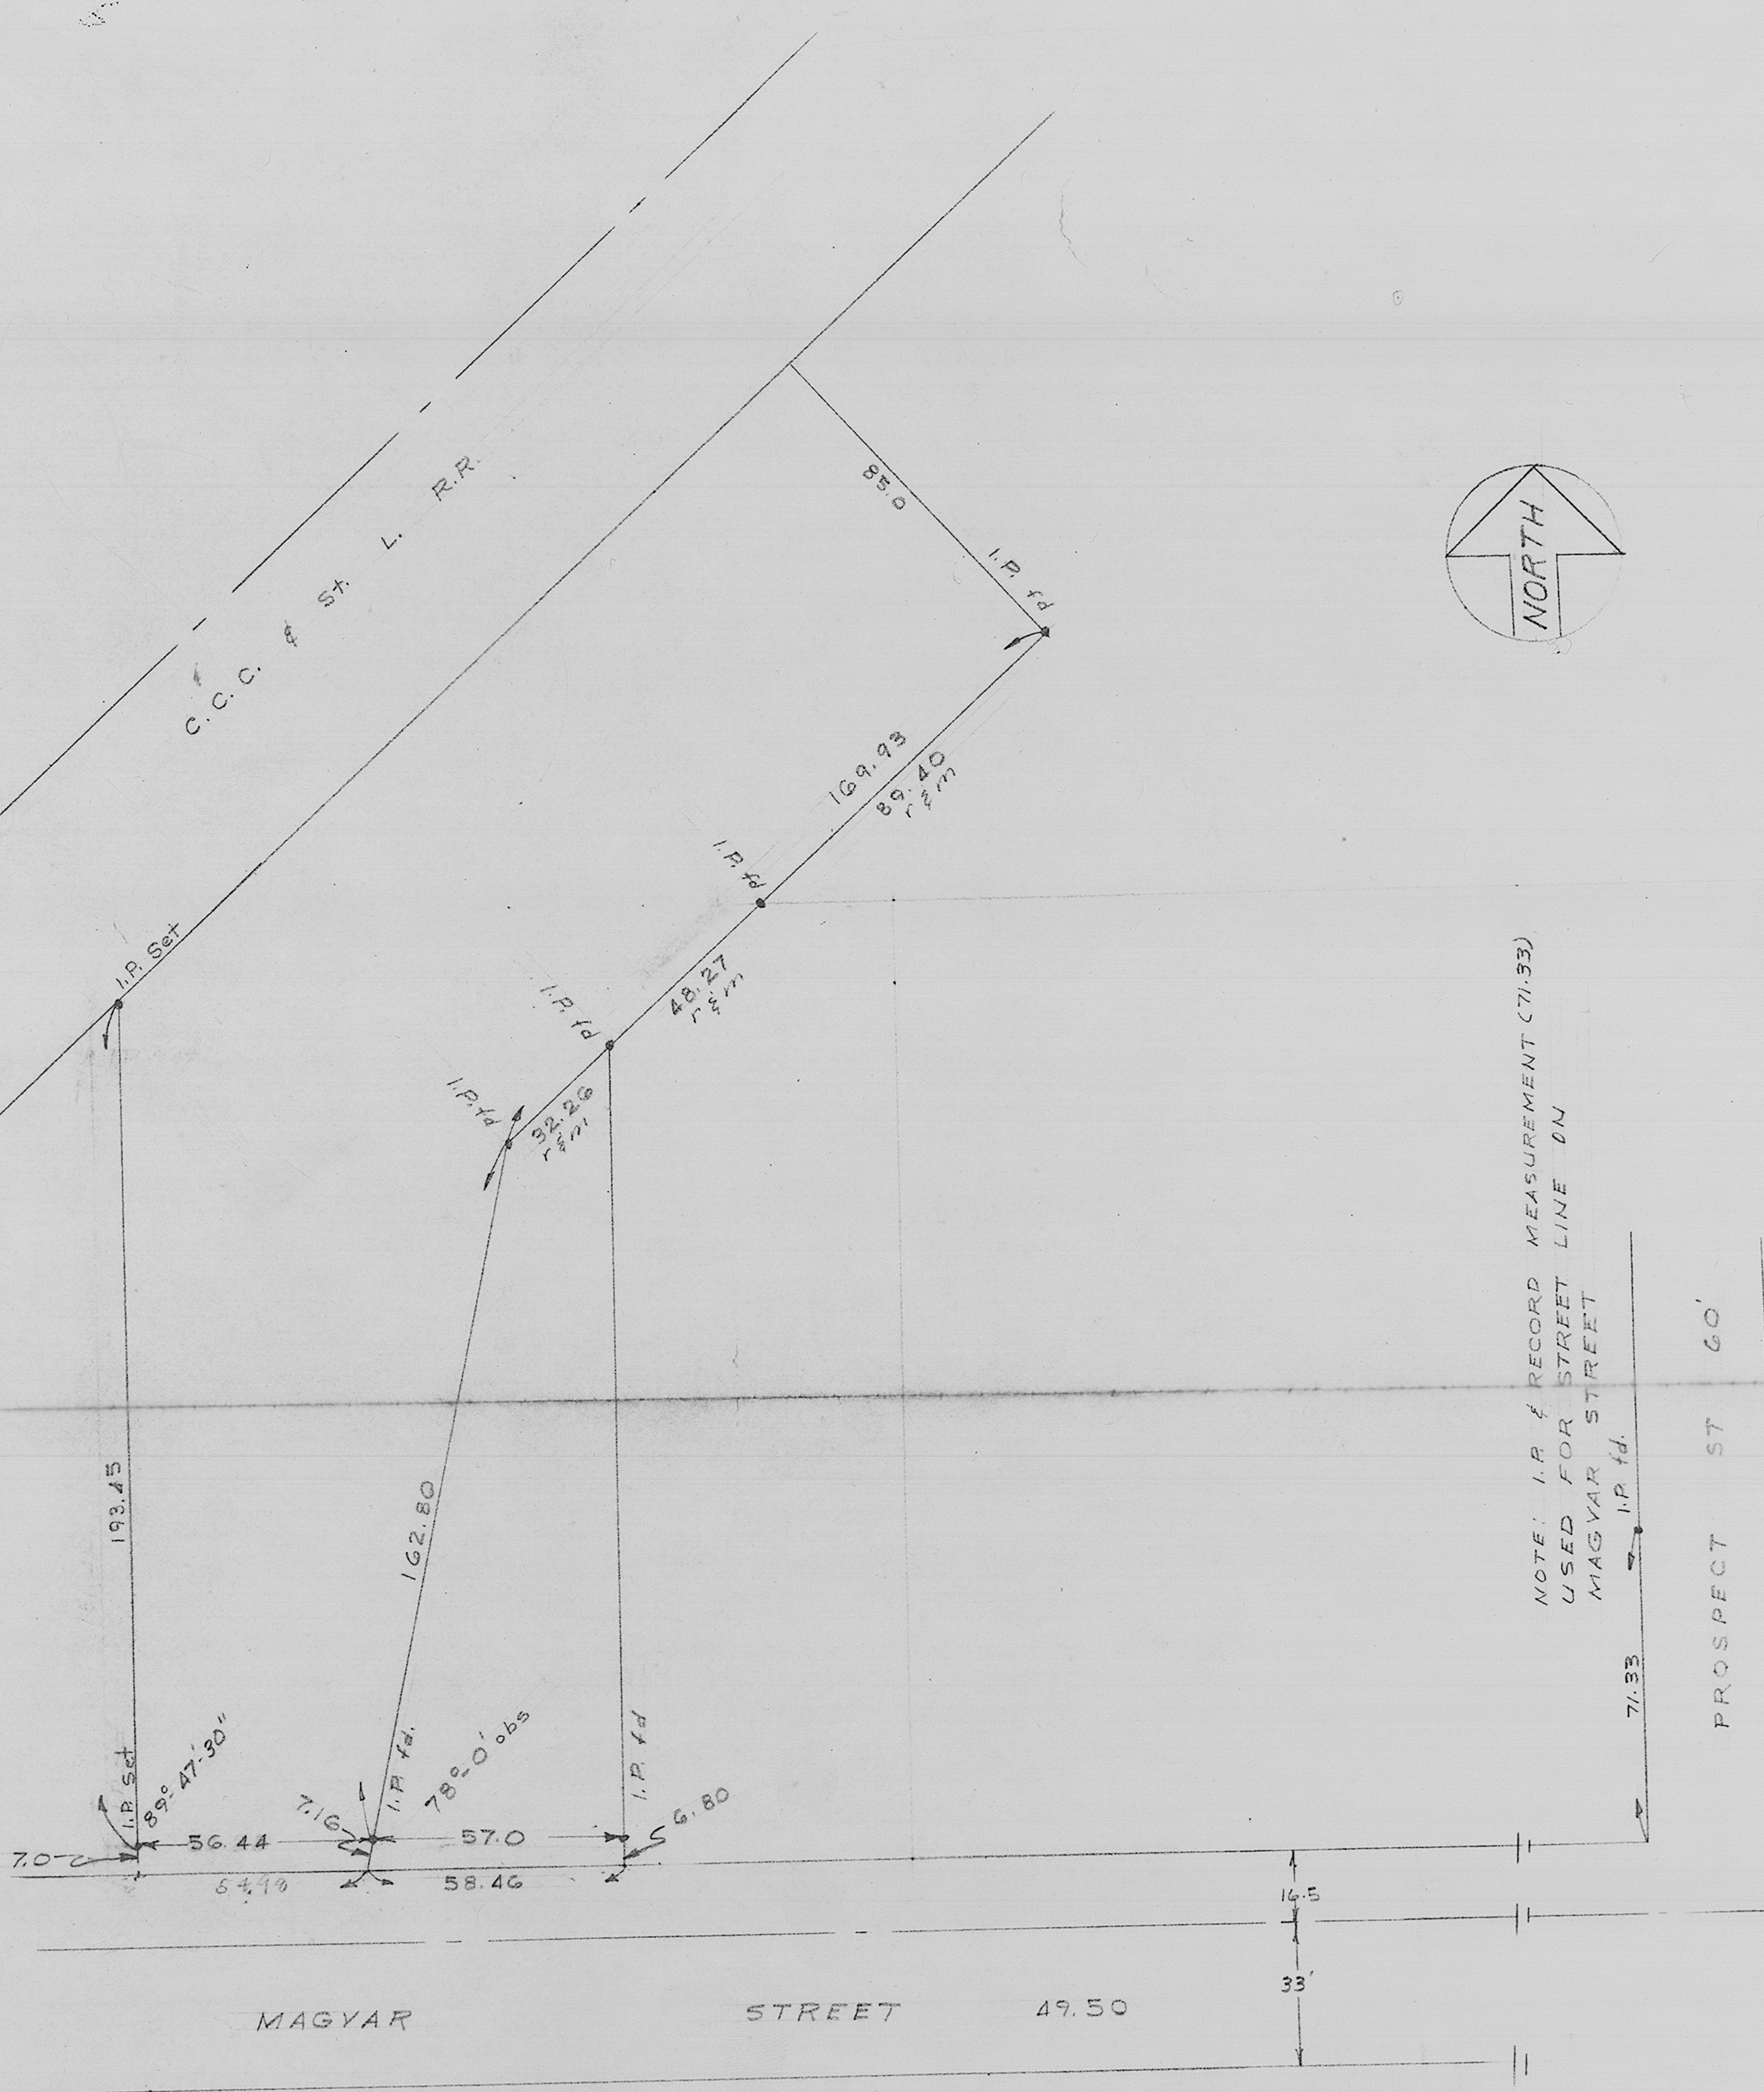

NOTE: I.P. RECORD MEASUREMENT (71.33)  
 USED FOR STREET LINE ON  
 MAGYAR STREET

SURVEY FOR JOHN E. BROWN  
 PARTS OF LOTS 56, 58, 59, 60, 61, 62  
 BLOCK No 1 ORIG VILLAGE PLAT  
 WELLINGTON VILLAGE LORAIN COUNTY OHIO  
 SCALE: 1" = 40' SEPTEMBER 1964  
 LAUNDON and HUFFMAN - REG. SURVEYORS