18-00-027-113-008
18-00-027-113-009
18-00-027-113-015
18-00-027-D

43585

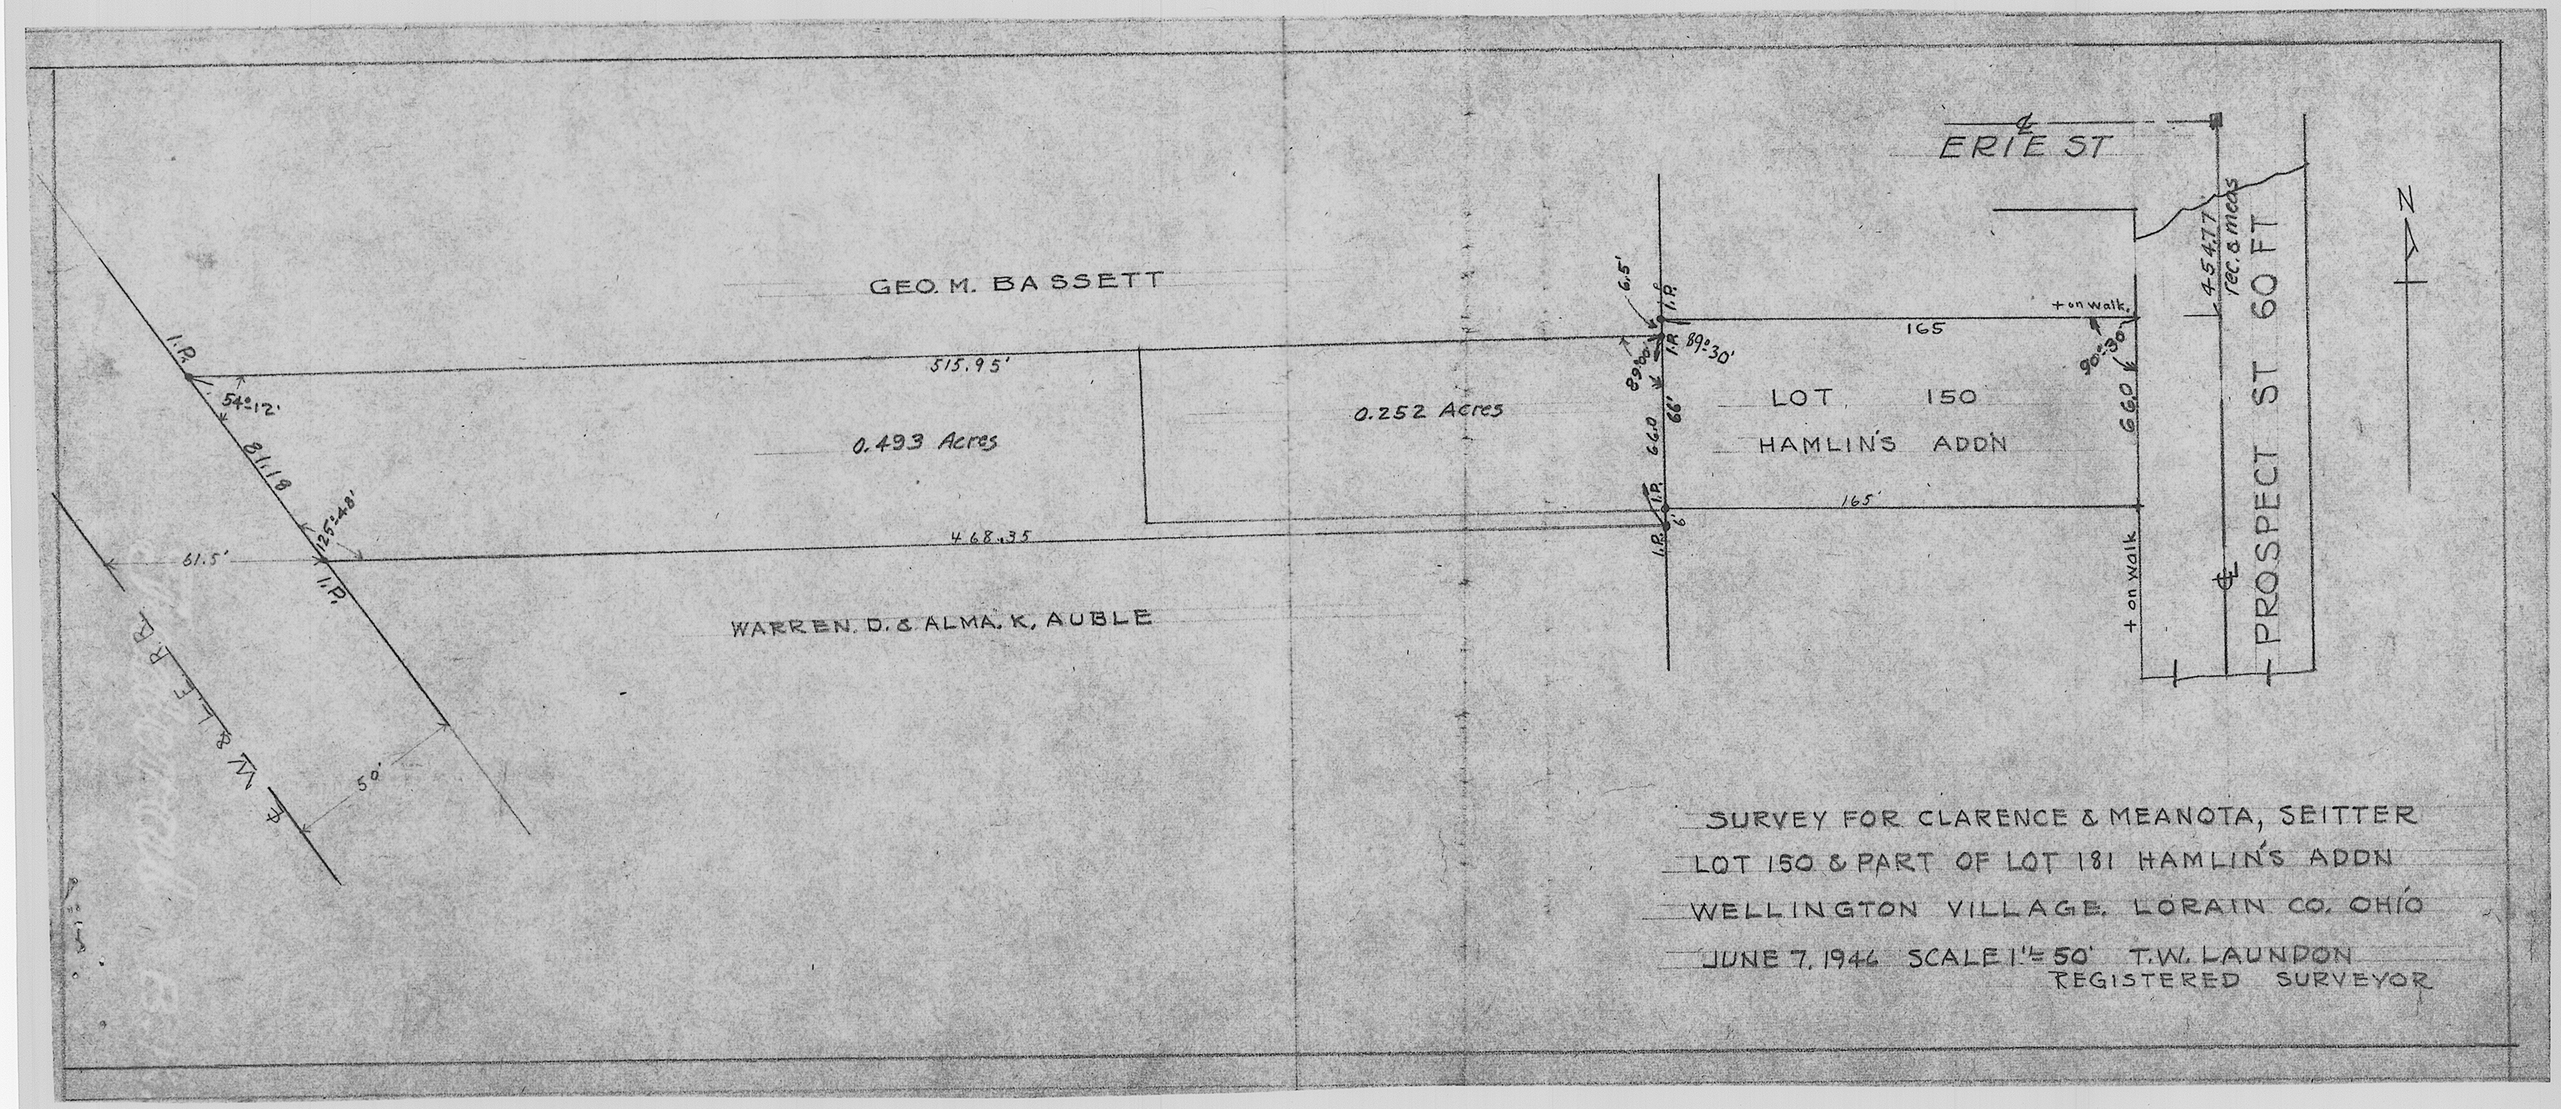

SURVEY FOR CLARENCE & MEANOTA, SEITTER
LOT 150 & PART OF LOT 181 HAMLIN'S ADDN
WELLINGTON VILLAGE. LORAIN CO. OHIO
JUNE 7, 1946 SCALE 1" = 50' T.W. LAUNDON
REGISTERED SURVEYOR