MAP OF SURVEY

Prepared For LAND TITLE AGENCY

Perm. Pcl. No. 11-00-040-000-011 S/L PROP. PARCEL 9

Street Address

in PROPOSED EATON ISLAND FARMS Subdivision

City Of EATON TOWNSHIP

County Of LORAIN Ohio

Date AUGUST 14, 1996 Scale 1" = 200'

STATE OF OHIO
RICHARD ROY MACKAY
4195
REGISTERED
PROFESSIONAL SURVEYOR

LEGEND

- I. Pin Set
- I. P. Found

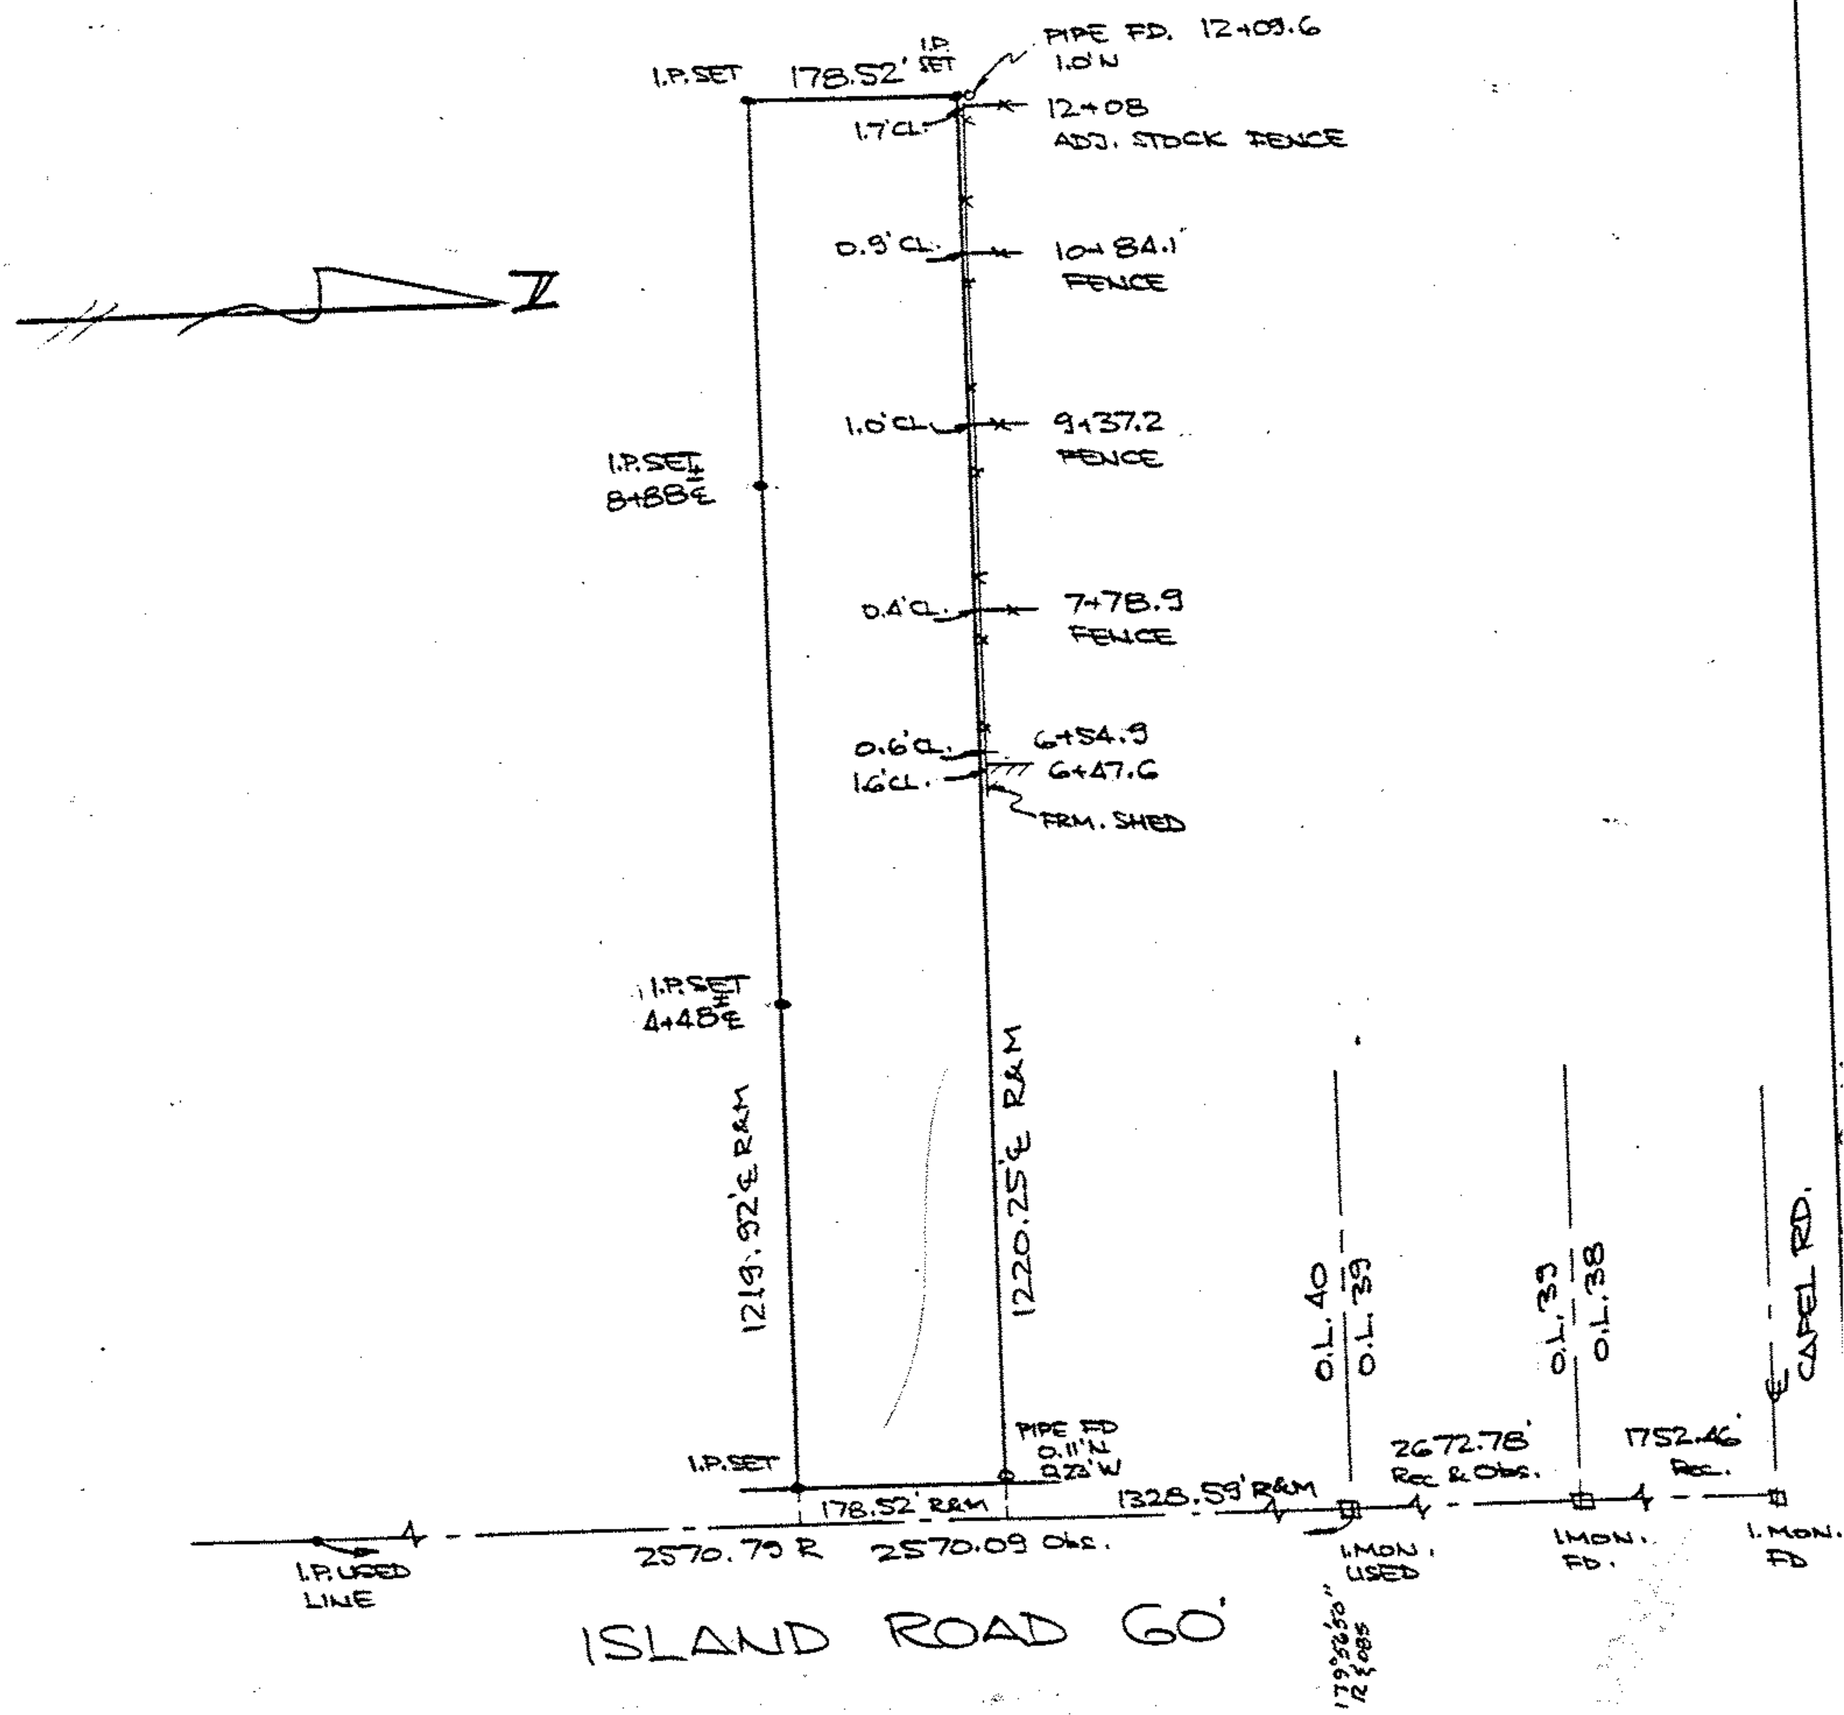

CERTIFICATION

Dimensions are expressed in feet and decimal parts thereof.
Monuments are at points shown and certified correct.

Richard R Mackay

RICHARD R. MACKAY – REGISTERED OHIO SURVEYOR NO. 4195

MACKAY *Engineering & Surveying Company* 7017 Pearl Road, Cleveland, Ohio 44130 (216)886-4500 / 886-4590 Fax