18·00·033·000·022
18·00·033·000·023
18·8

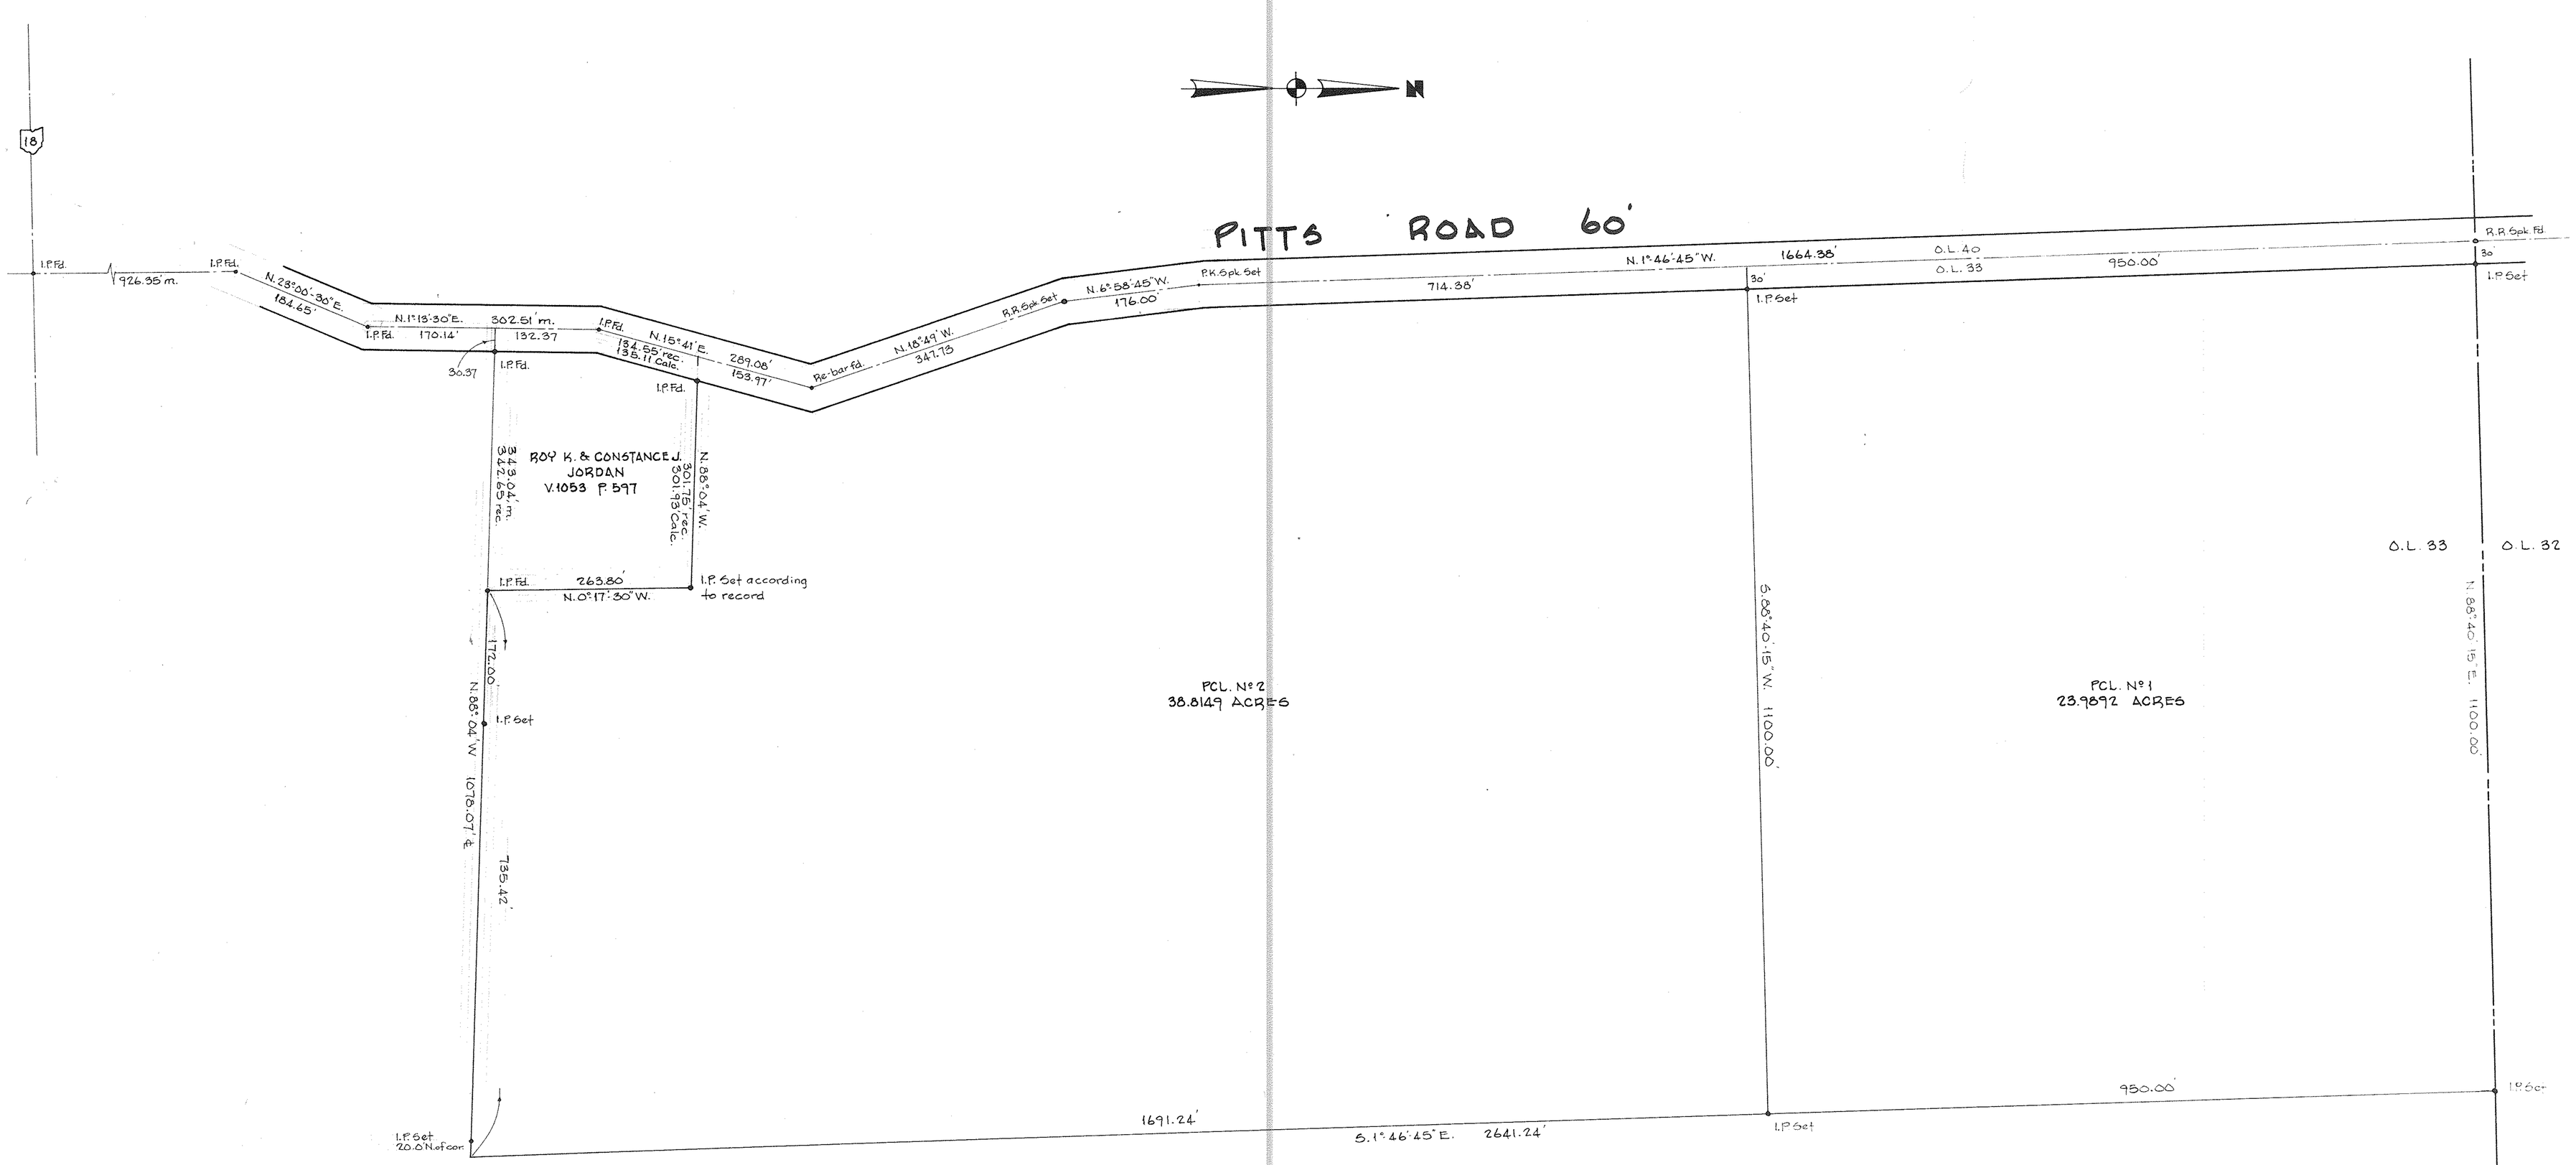


SURVEY FOR

# LORAIN COUNTY SAVINGS & TRUST CO. (TRUSTEE)
## % KING REALTY

PART OF O.L. 33 WELLINGTON TOWNSHIP COUNTY OF LORAIN STATE OF OHIO

SCALE 1"=100' OCTOBER 1, 1981

LAUNDON • SIMON • CAHL & ASSOC. ENGINEERS & SURVEYORS

JOB Nº 81-1088 F.B. 156 P. 62-65