19-G
19-02-030-000-022, -034, -039, -037, -041

48302

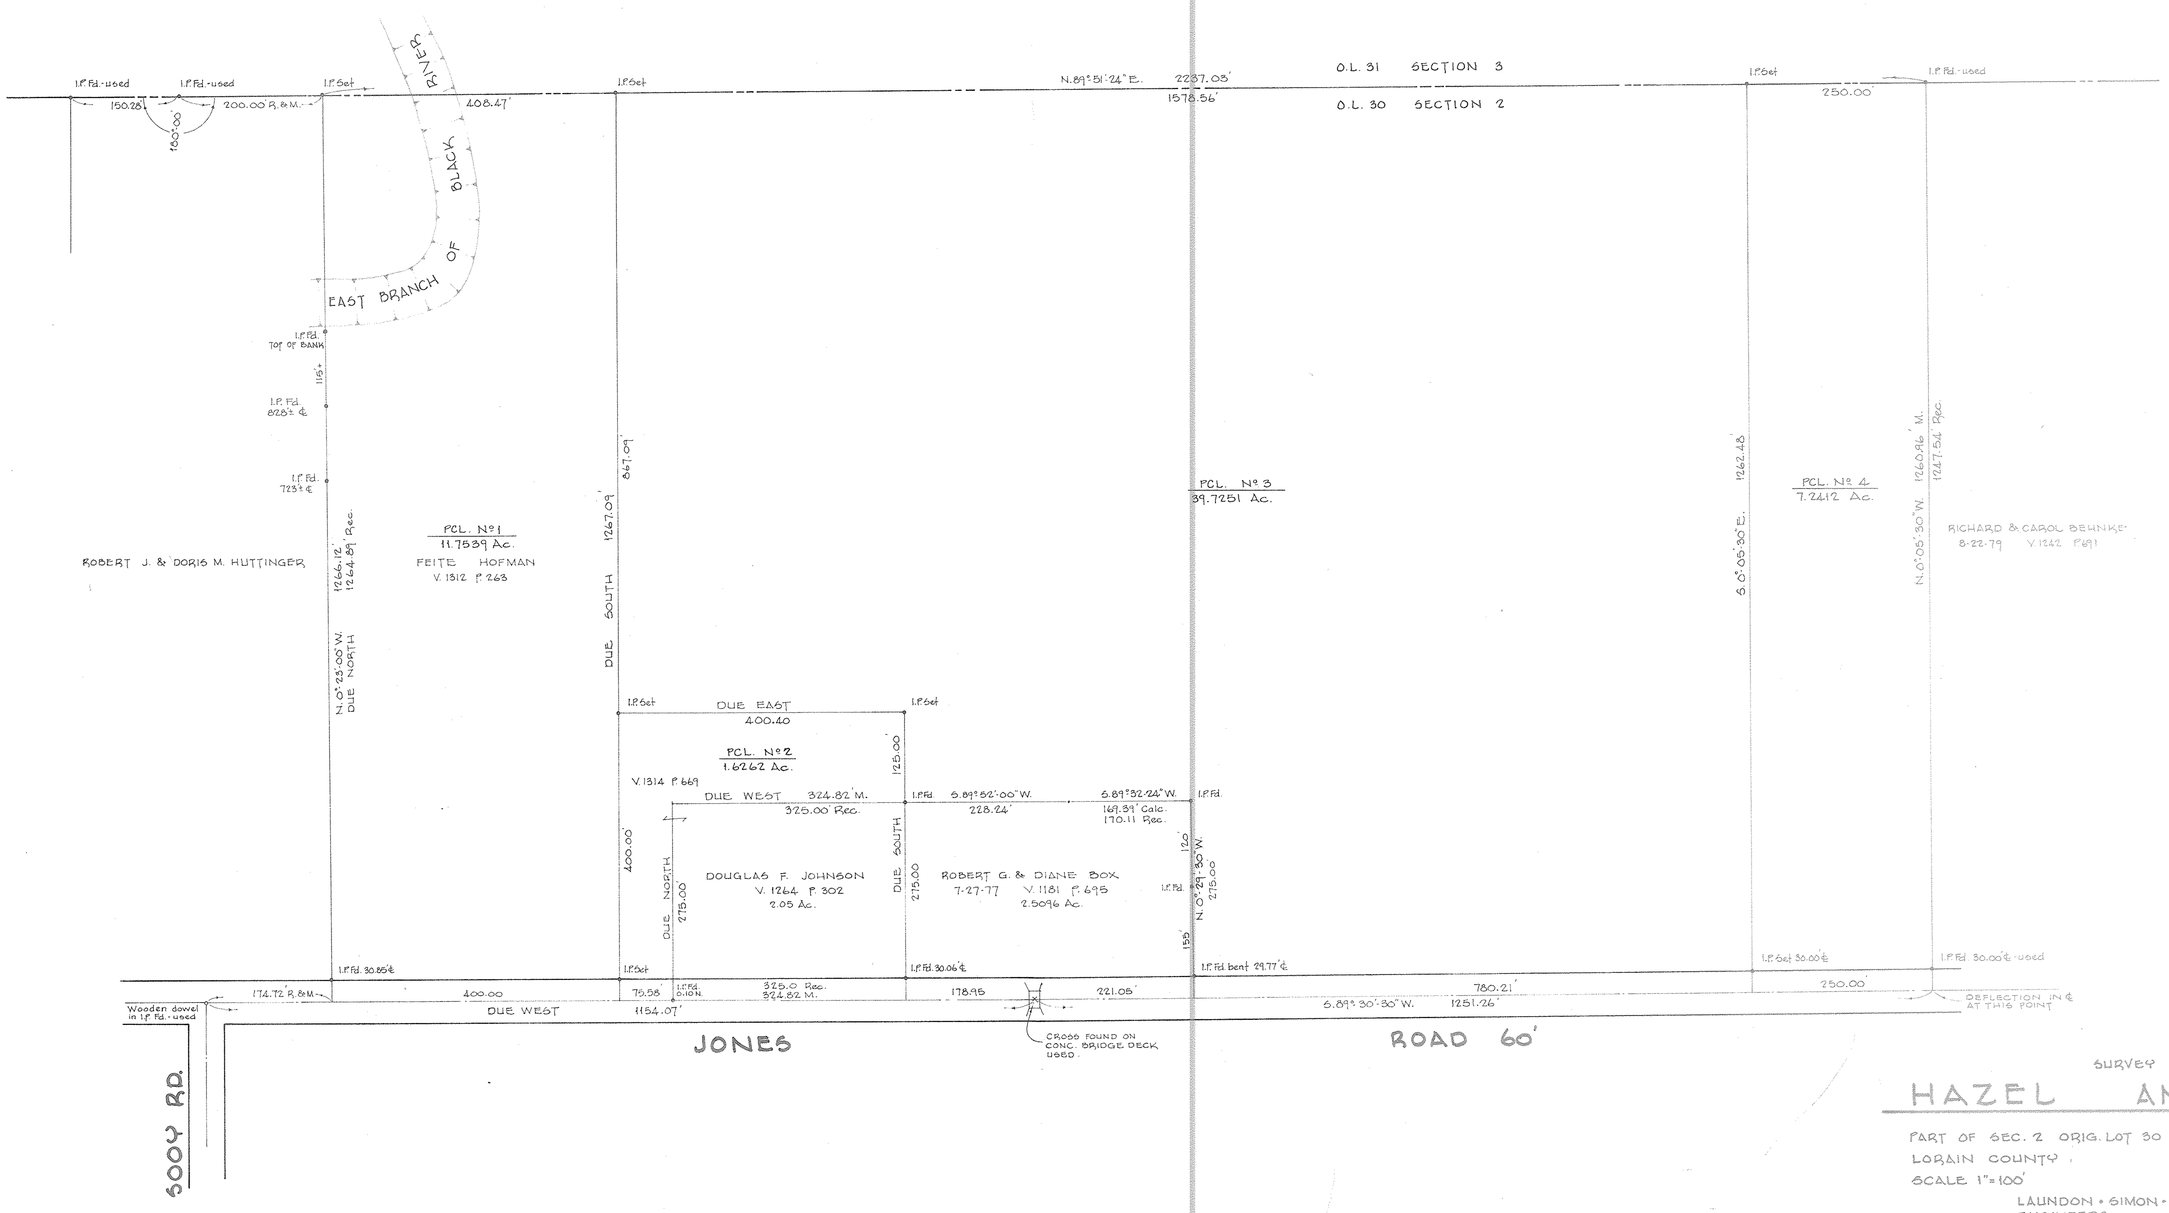

SURVEY FOR

HAZEL ANDREWS

PART OF SEC. 2 ORIG. LOT 30 PENFIELD TWP.
LORAIN COUNTY, OHIO
SCALE 1"=100' MAY, 1988

LAUNDON • SIMON • CAHL & ASSOC.
ENGINEERS SURVEYORS
JOB Nº 88-1187 F.B. 176 P. 29

REV. 5-15-84 W. R. BEHNKE & PCL. 4 ACREAGE.

163