A3200

SURVEY

OF PART OF

ORIGINAL LOT Nº 40 TRACT Nº 6
PENFIELD TOWNSHIP
COUNTY OF LORAIN STATE OF OHIO

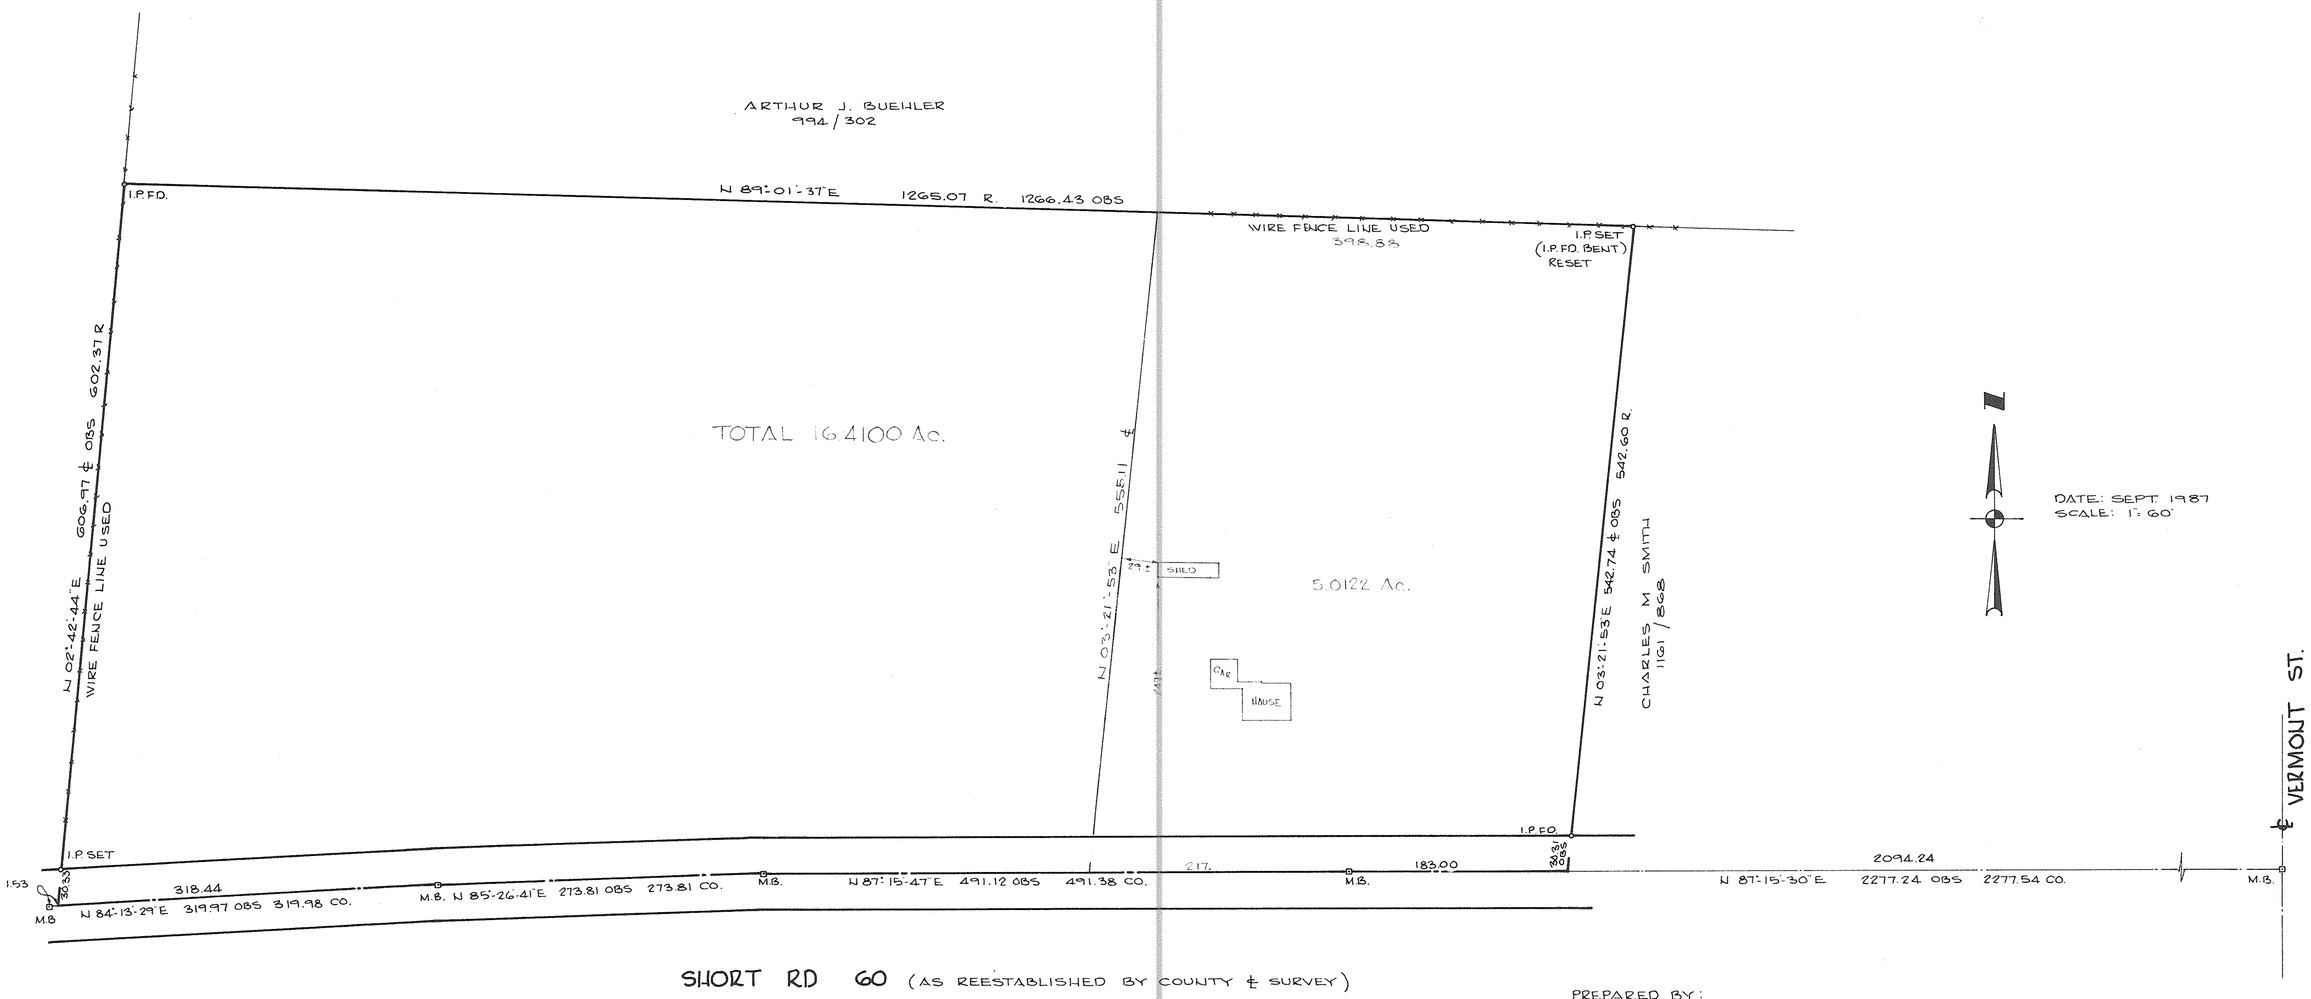

SHORT RD 60 (AS REESTABLISHED BY COUNTY & SURVEY)

PREPARED BY:

LAUNDON - SIMON - CAHL AND ASSOC., INC.

ENGINEERS AND SURVEYORS
219 COURT ST.
ELYRIA, O

JOB Nº 87-1645

STATE OF OHIO
DANE A. HAPONEK
S-6211
REGISTERED SURVEYOR

220