LORAIN COUNTY SURVEY BANK

TOTAL AREA	87.33422	ACRES
TAKE AREA	87.33422	ACRES
REMAINDER	00.00000	ACRES

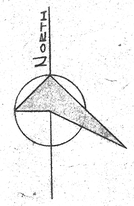

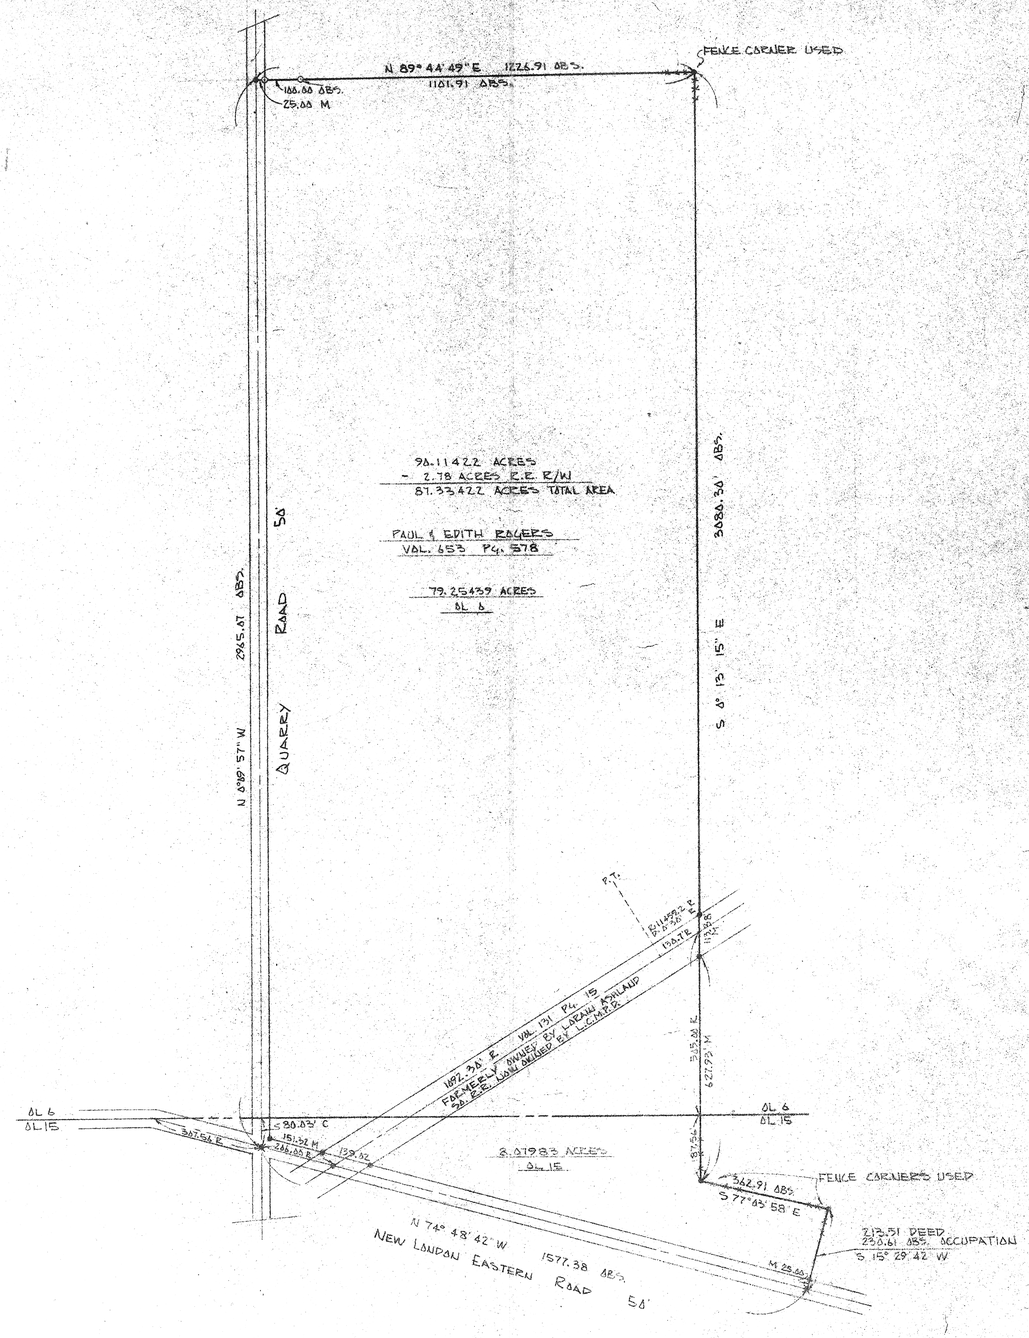

LEGEND

IRON PIN FOUND	○
IRON PIN SET	●
RAILROAD SPIKE SET	✖
FENCE	++++
RECORD	R.
OBSERVED	ABS.
MEASURED	M

LORAIN COUNTY METROPOLITAN PARK DISTRICT
LAND ACQUISITION SURVEY
P & E. ROGERS PROPERTY
ROCHESTER TOWNSHIP

SCHAFER, HURA & ASSOCIATES, INC.
ENGINEERS AND SURVEYORS
4370 OBERLIN AVE.
LORAIN, OHIO

CCR
5

ORIGINAL LOT	6 & 15	DATE	5-3-72
TOWNSHIP	ROCHESTER	SCALE	1" = 200'
CITY OF		FIELD BOOK	220 PG. 123-124
COUNTY OF	LORAIN	DRAWN BY	JEE
STATE OF	OHIO	CHECKED BY	J.K. M.L.
N. O.	1972-40 A&B	FILE NO.	20-6-15