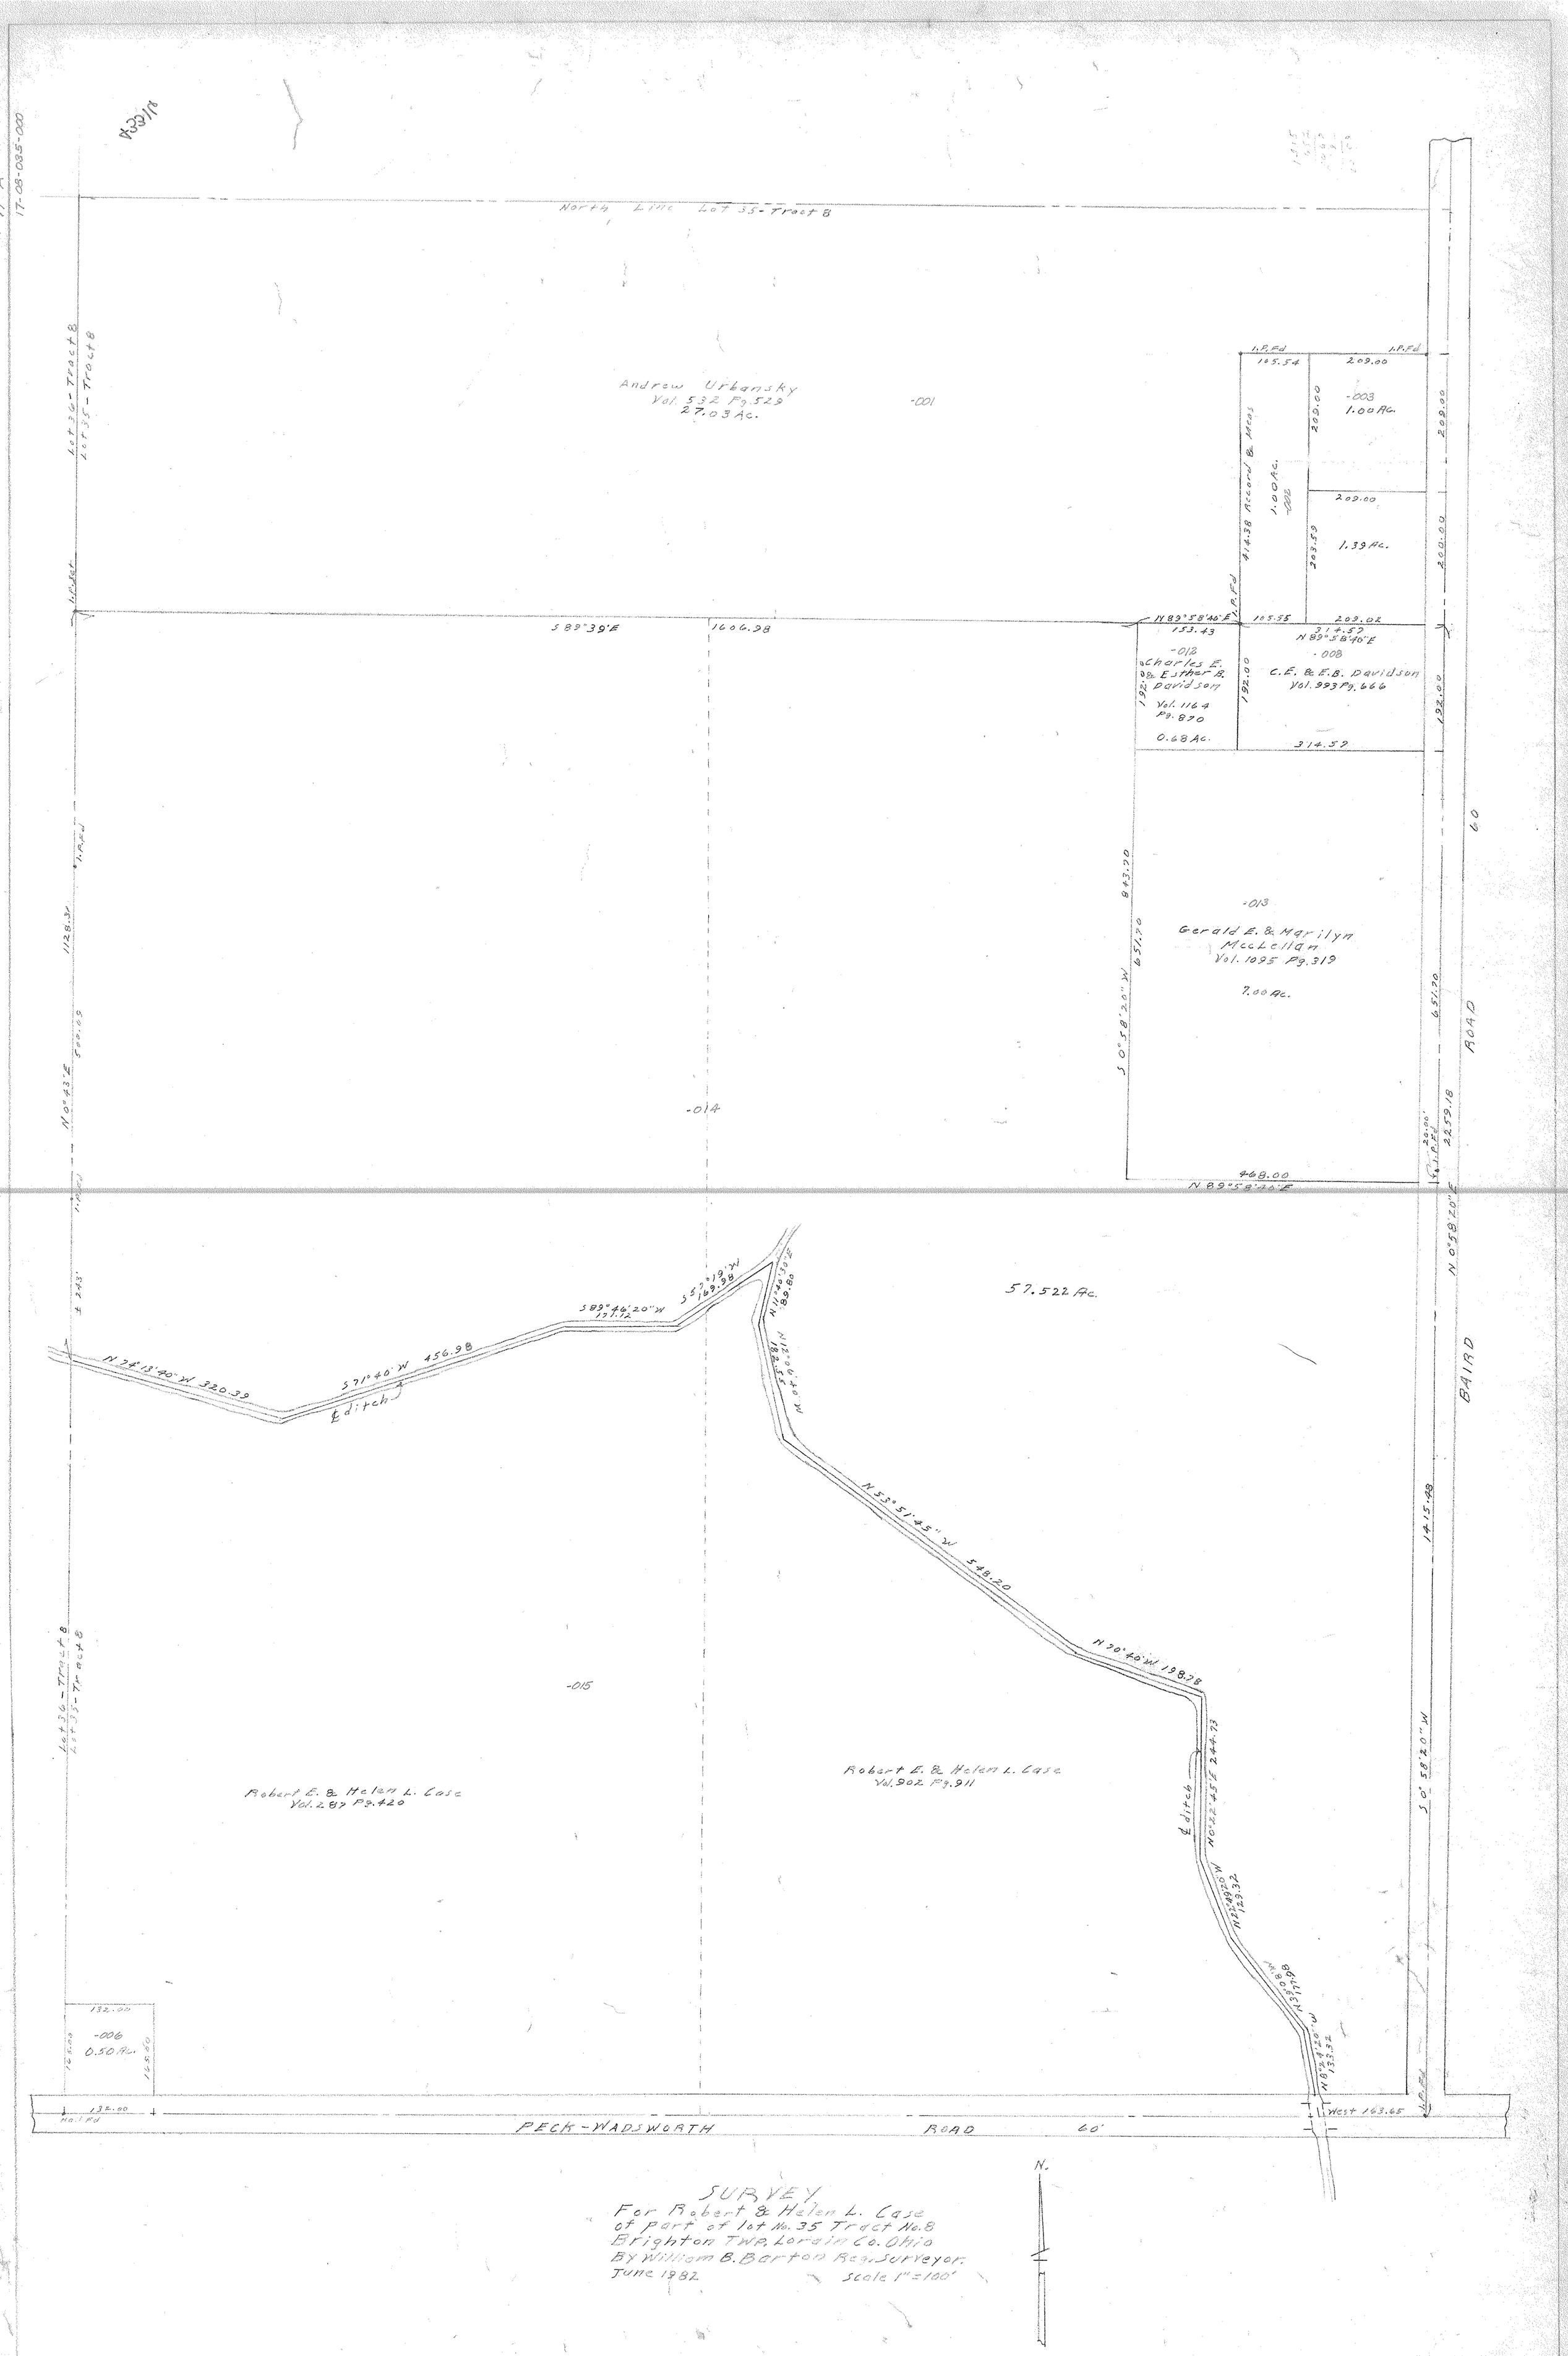

SURVEY
For Robert & Helen L. Case
of part of lot No. 35 Tract No. 8
Brighton Twp. Lorain Co. Ohio
By William B. Barton Reg. Surveyor.
June 1982. Scale 1" = 100'