17-08-036-000-
17-20-018-000
17-A

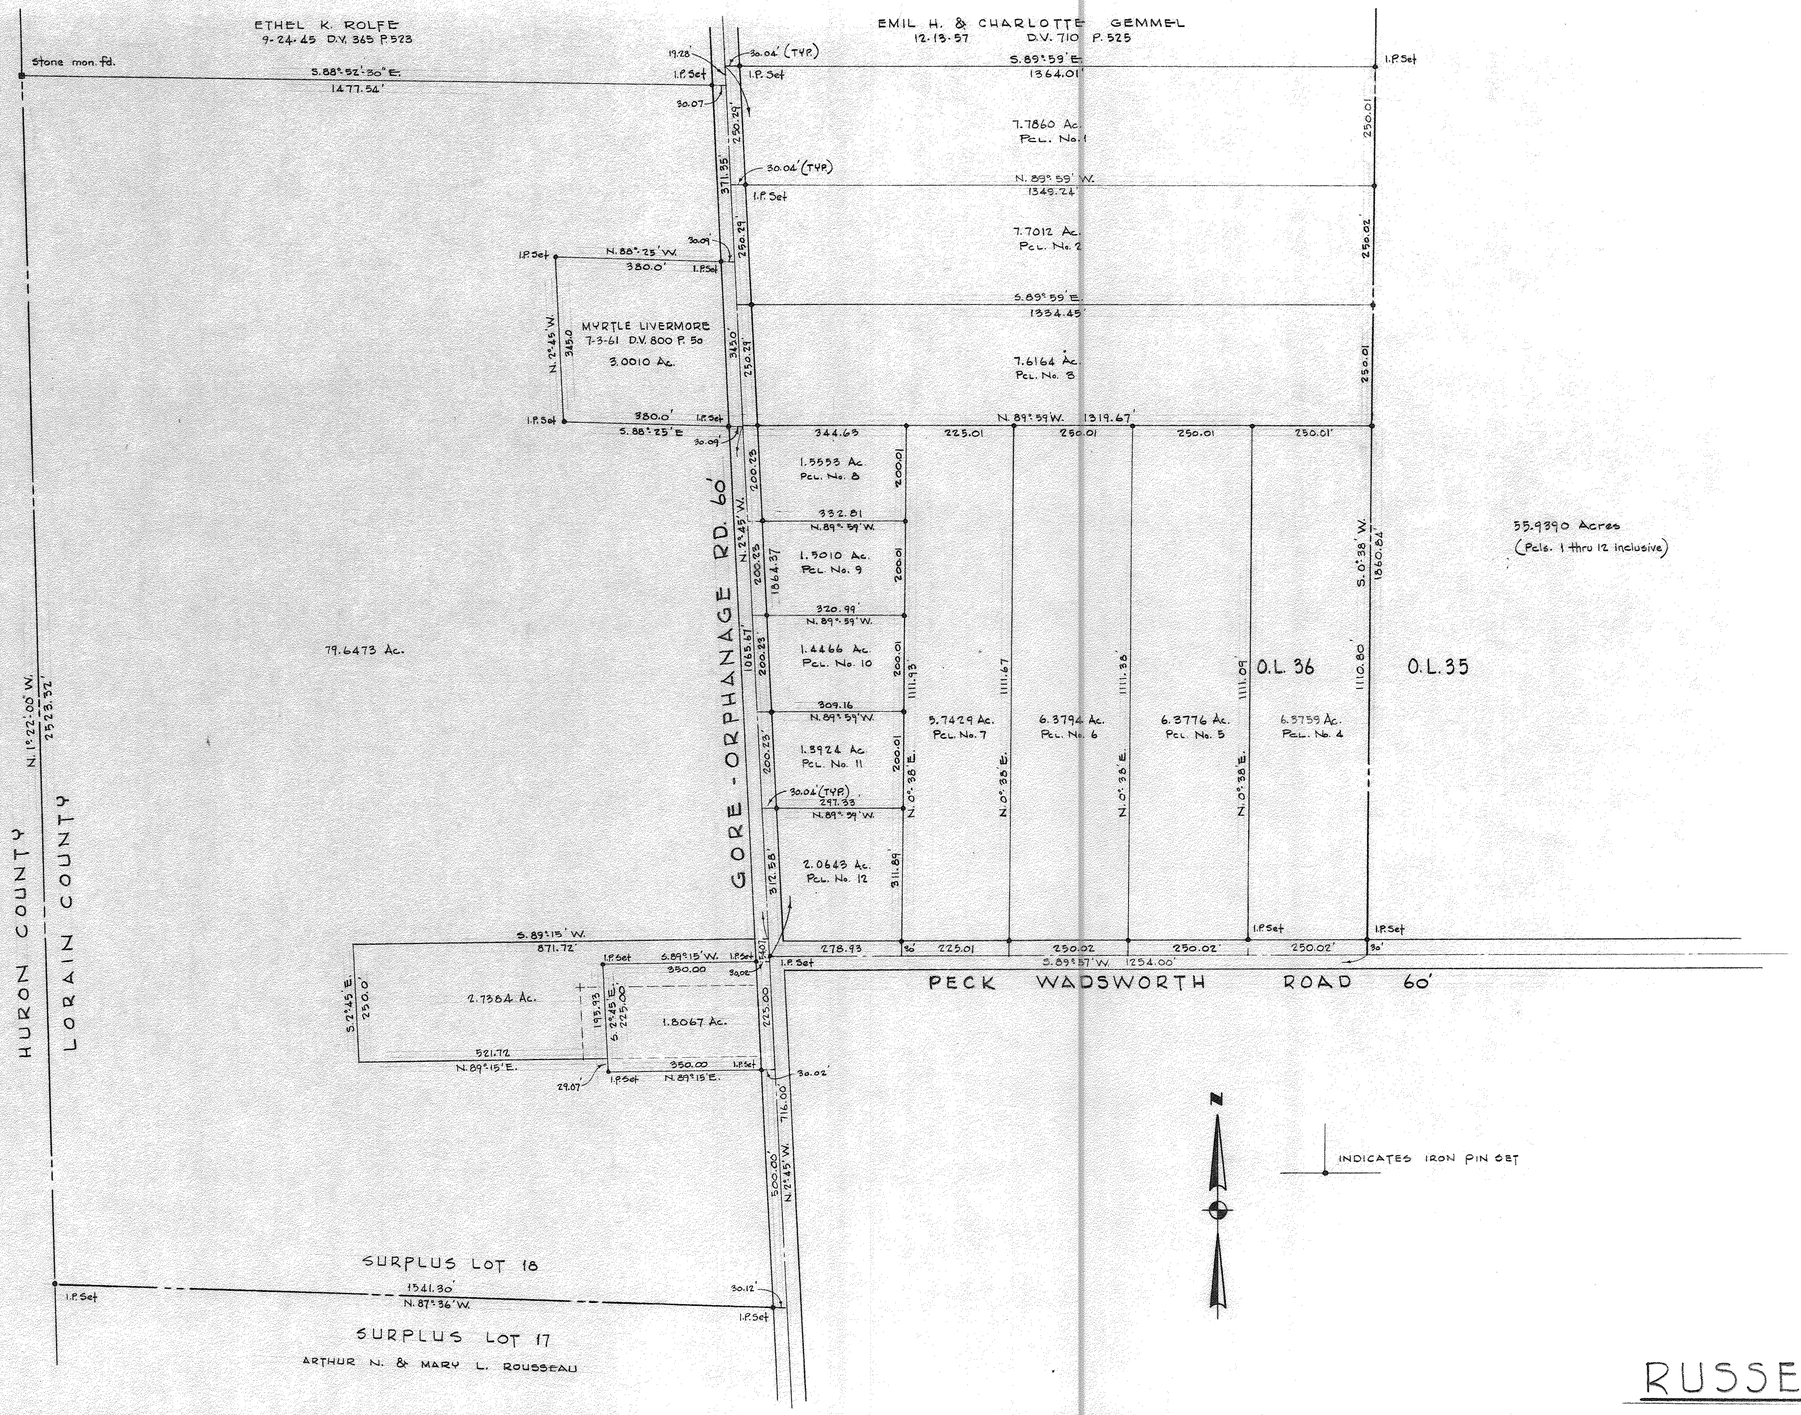

SURVEY FOR

RUSSEL L. SWORD

PART OF SURPLUS LOT 18 OF THE GORE STRIP AND ORIG. LOT 36
BRIGHTON TWP. LORAIN COUNTY OHIO
SCALE 1"=150' JULY, 1978

LAUNDON • SIMON • CAHL & ASSOC.
ENGINEERS SURVEYORS

Job No. 76-549 F.B. 180 P. 51 Oct. '78
Job No. 78-769 F.B. 180 P. 60 July '78
Job No. 79-924 No Field Book Oct. '79

REVISED 11-22-78 ADDN. OF PCLS 2,3,5,6,7,8,9,10,11 & 12 R.G.S.
REVISED 10-15-79 HEGMAN PCL. (79-924)

NATIONAL CLEARPRINT