18-00-021-113
18-00-021-C

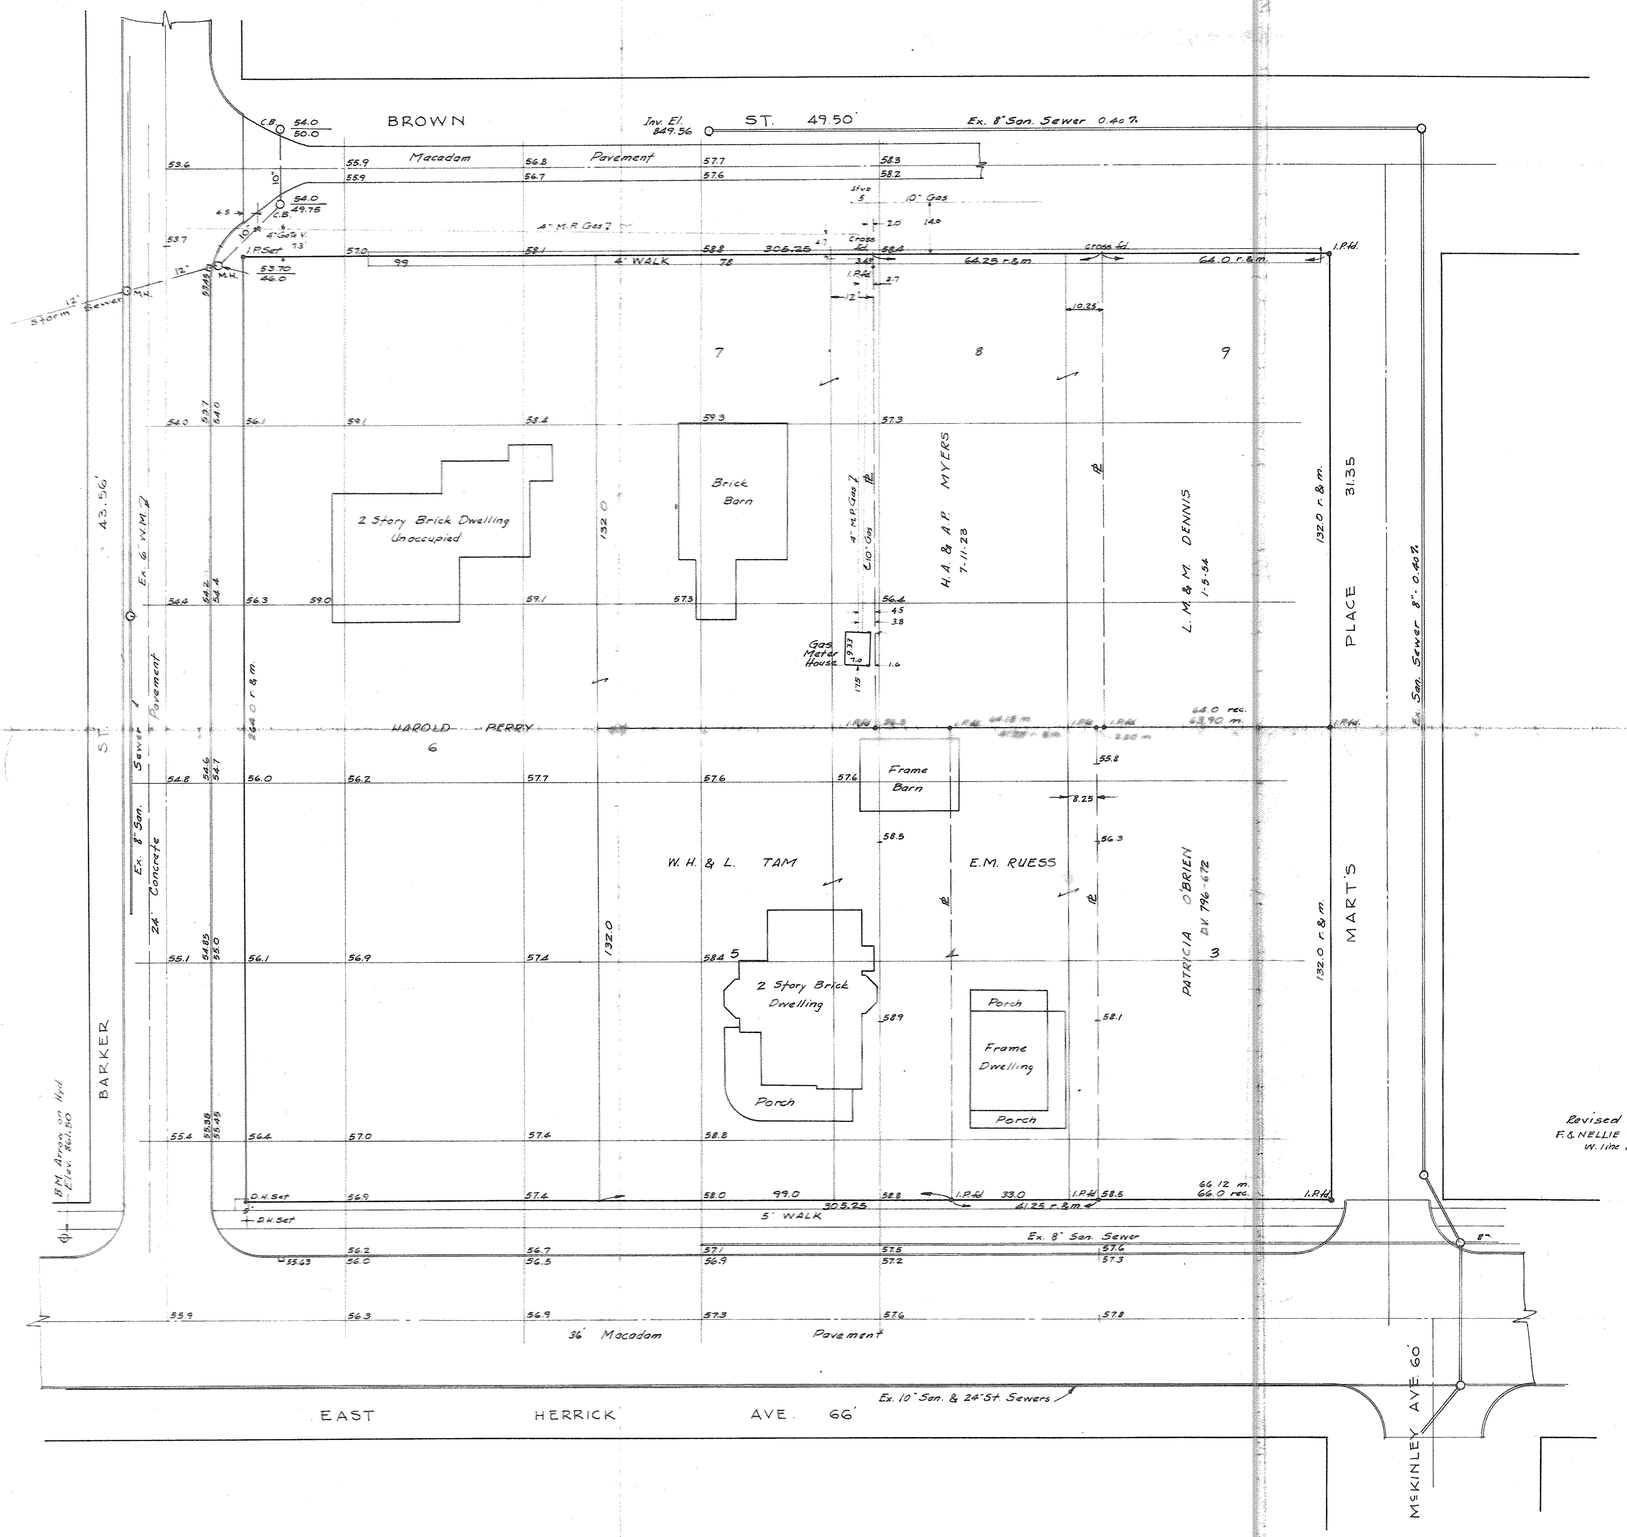

LAND AND TOPOGRAPHICAL SURVEY
PARKHAVEN BUILDERS

PT. OF S/L 3 & 8 ALL OF S/L'S 4, 5, 6 & 7 IN O.V.P. 5
VILLAGE OF WELLINGTON LORAIN CO., OHIO
SCALE 1"=20' SEPT. 7, 1961
LAUNDON & HUFFMAN REG.-ENGINEERS-SURVEYORS

Revised 4/24/62 O.P.G.Co lines located
F. & NELLIE CURTICE TO OHIO FUEL GAS CO LEASE V. 243-247
W. line Lot 8. 7/6/37