18-00-023-A
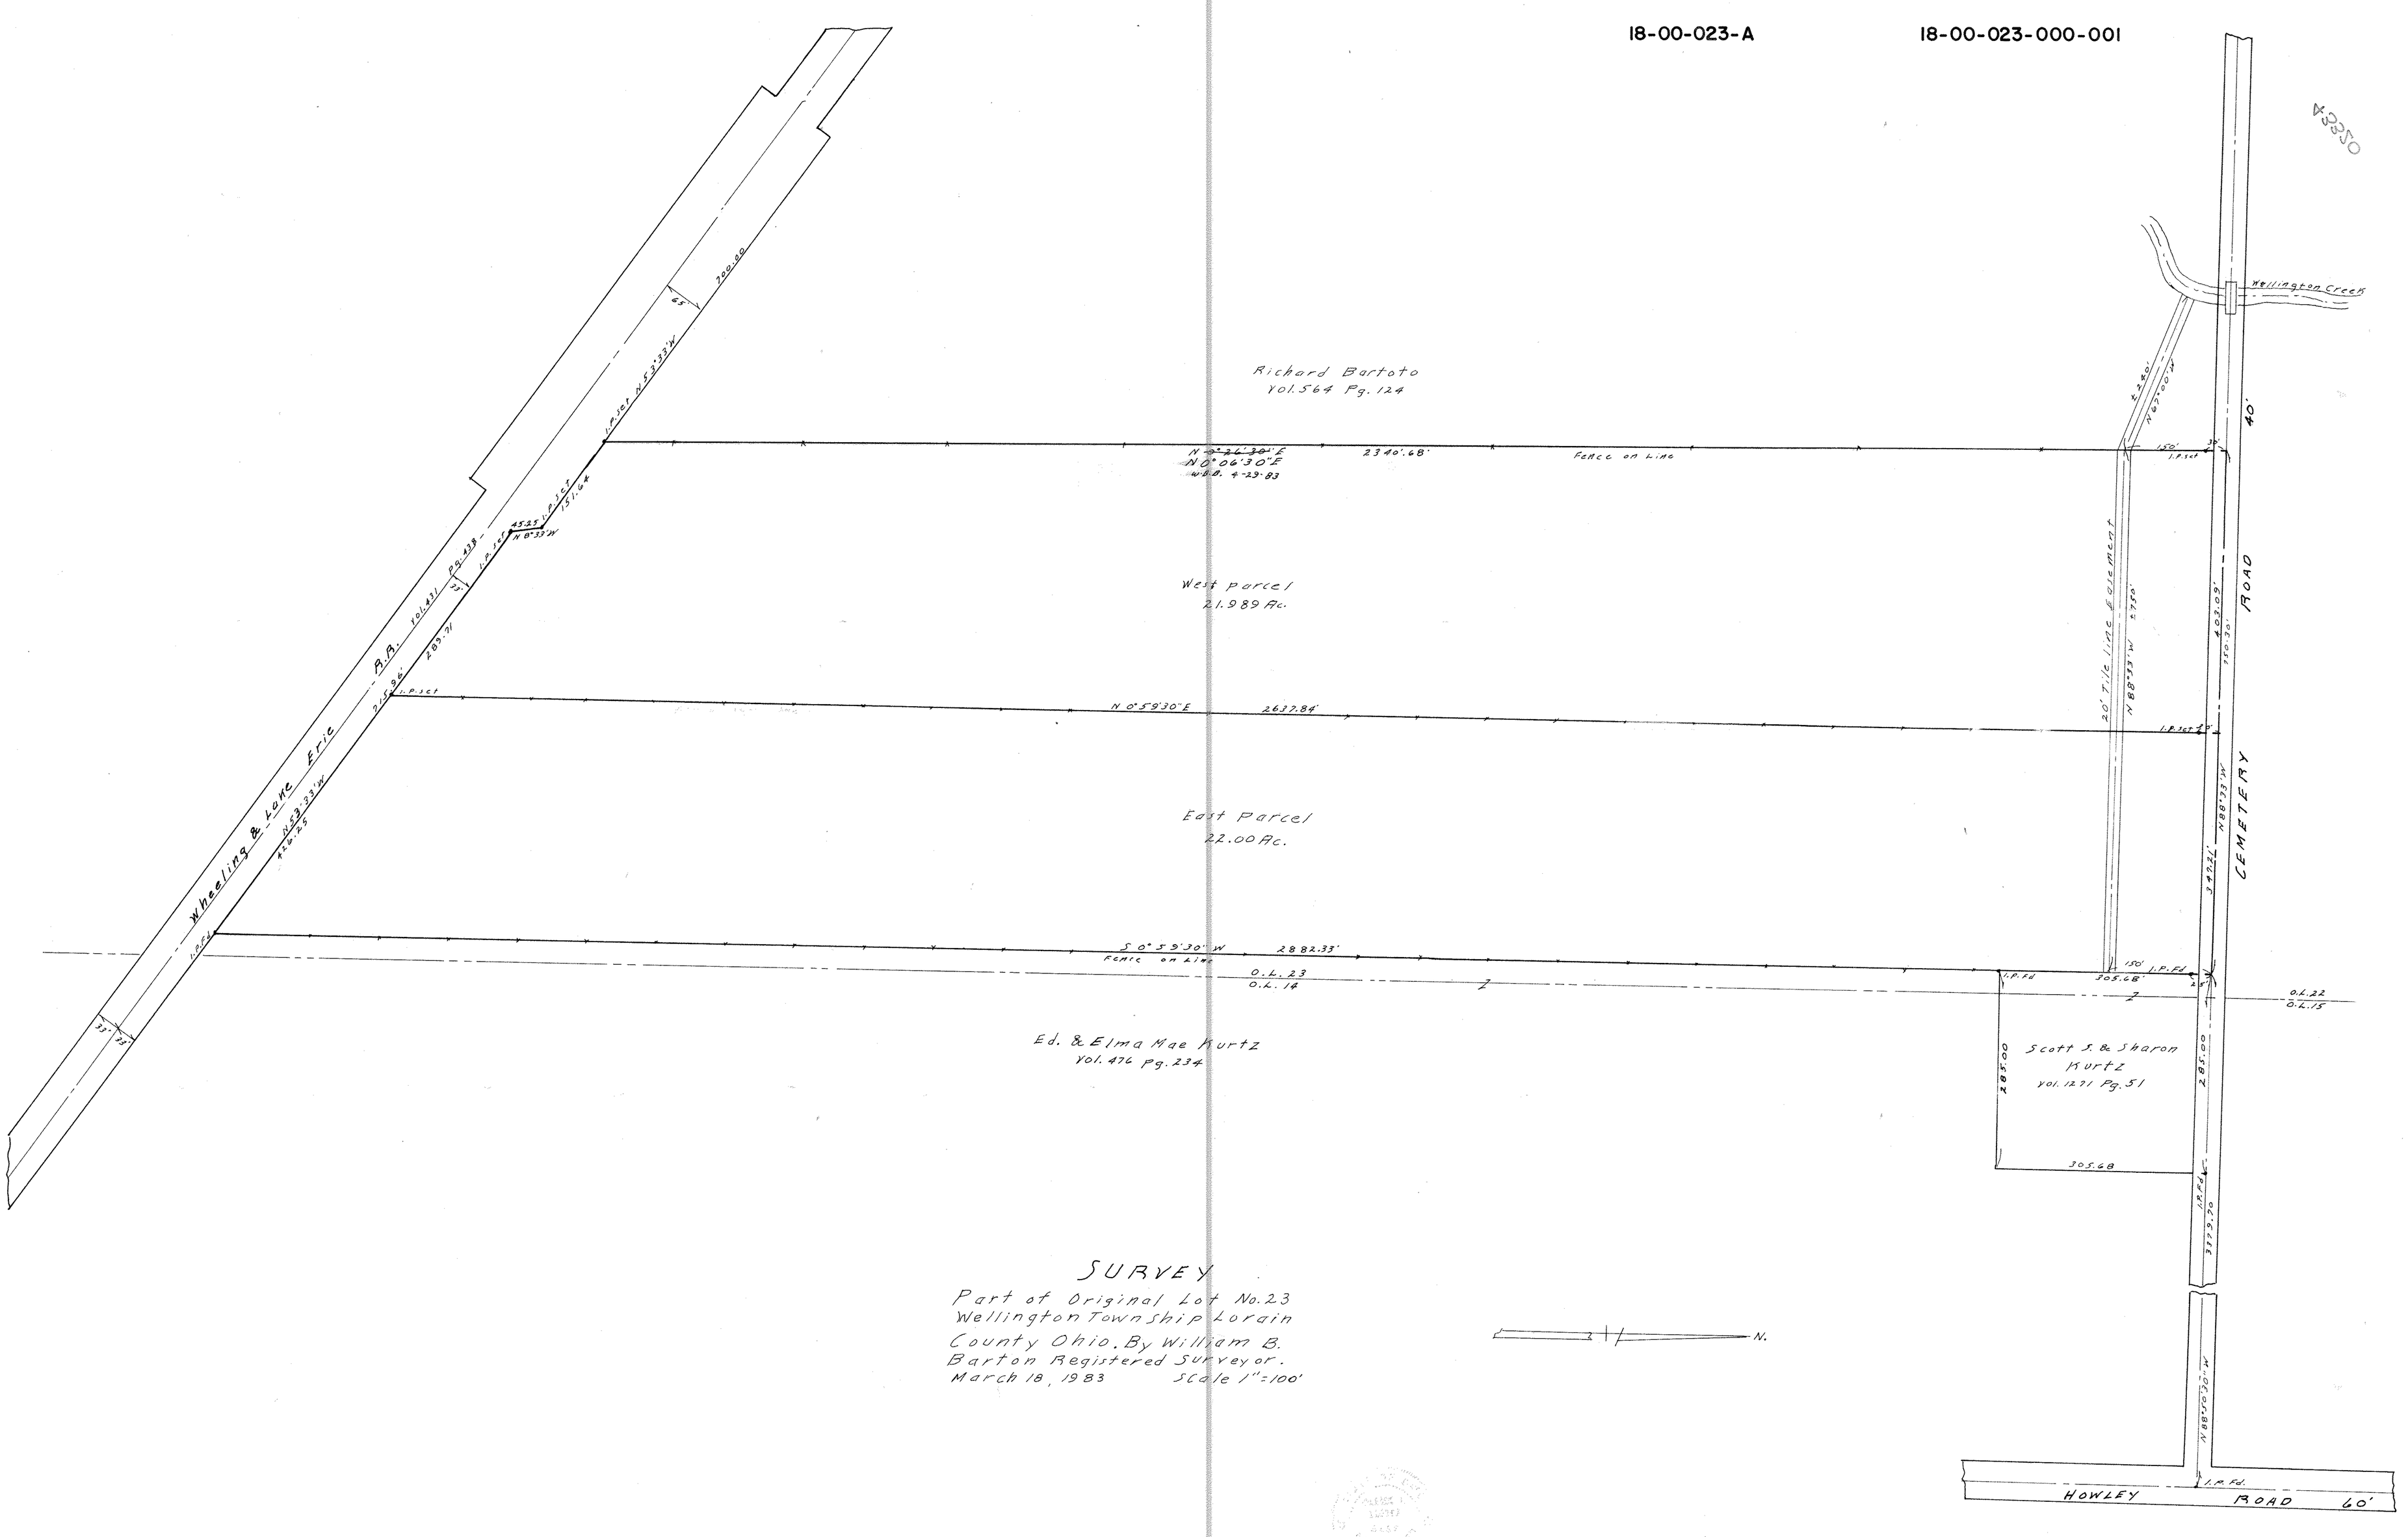
18-00-023-000-001