10-00-009-118-???
10-00-009-E

A33178

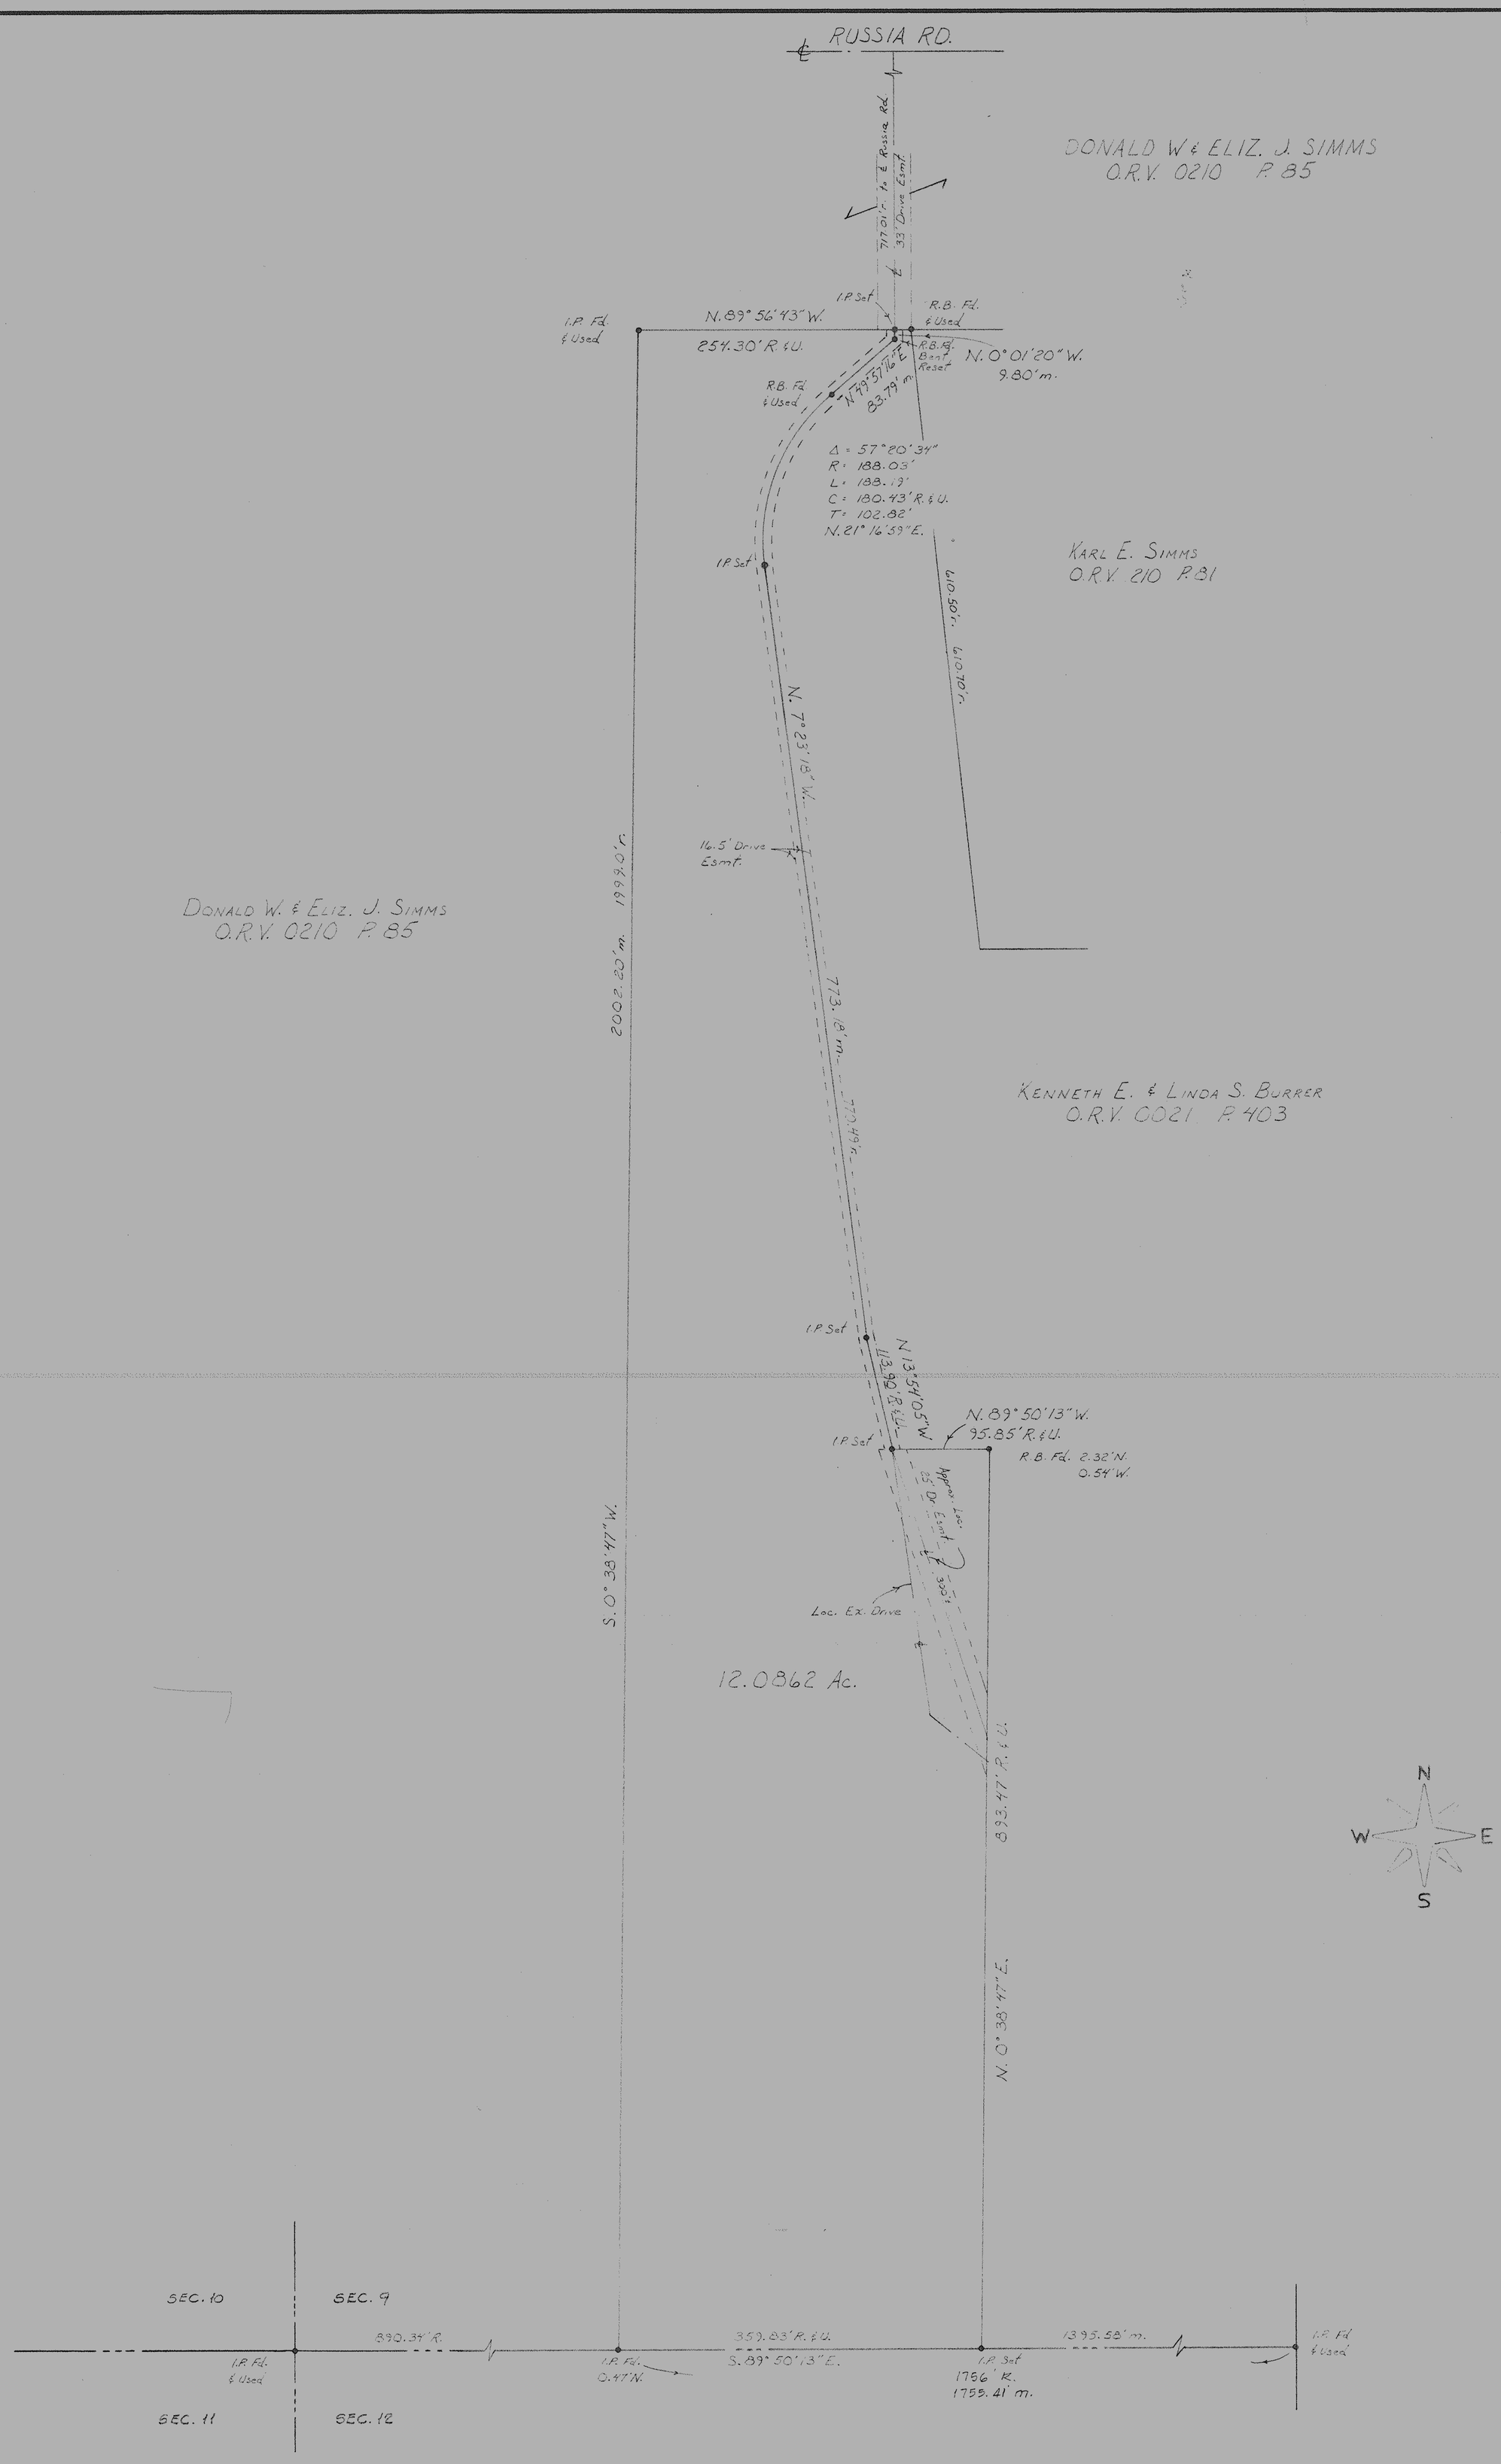

SURVEY FOR

HOWARD MAYNE

PART OF SEC. 9 CARLISLE TOWNSHIP
COUNTY OF LORAIN STATE OF OHIO
SCALE: 1" = 80' JANUARY 1994

BY
LAUNDON • SIMON • CAHL & ASSOC.
ENGINEERS SURVEYORS
710 MIDDLE AVE. ELYRIA, OHIO

JOB № 93-2473 FB. 232 P. 29 & 35

297