10-00-003-112-???
10-00-003-B

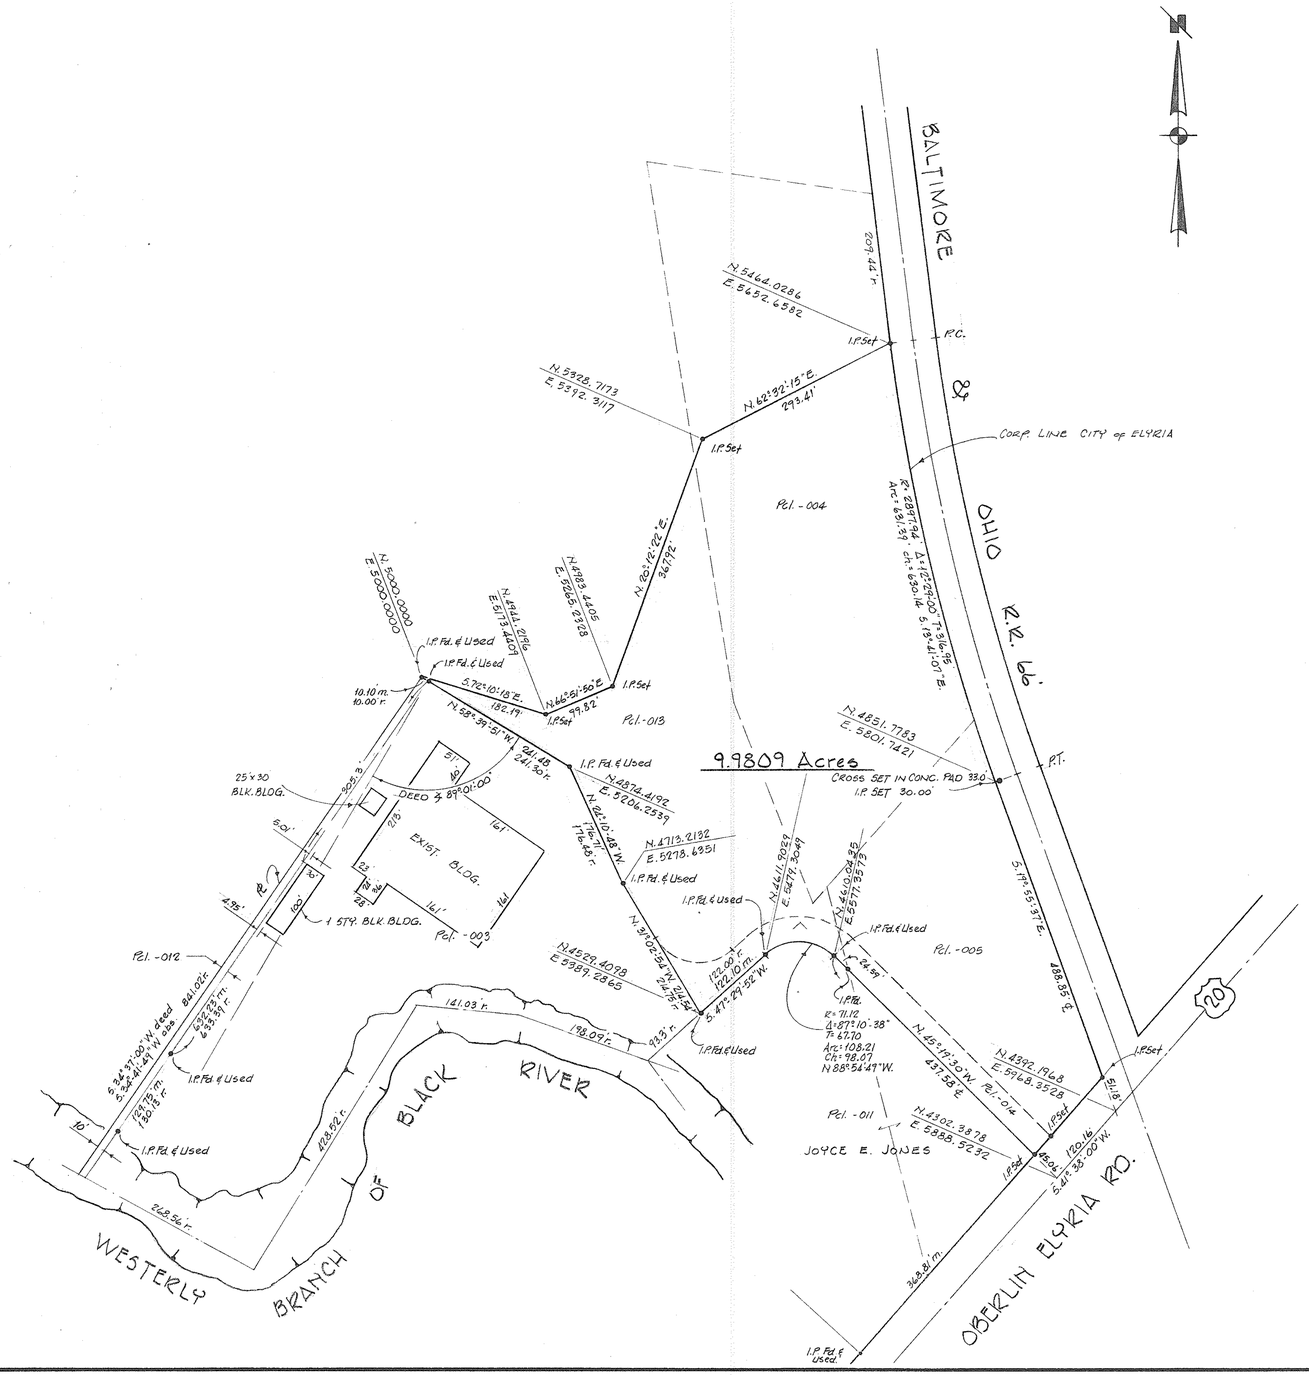

BUILDING LOCATION FOR LORNE J. ELBERT AUG. 1994

THIS IS TO CERTIFY THAT THIS SURVEY WAS MADE IN ACCORDANCE WITH THE "MINIMUM STANDARDS FOR BOUNDARY SURVEYS IN THE STATE OF OHIO."

STATE OF OHIO
RODGER G. SIMON
5101
REGISTERED SURVEYOR

Rodger G. Simon
RODGER G. SIMON
REG. SURVEYOR OHIO Nº 5101

SURVEY FOR

KASPER FOUNDRY CO.

PART of ORIG. SEC. 3 — CARLISLE TOWNSHIP
COUNTY of LORAIN — STATE of OHIO
FEBRUARY, 1991 — SCALE 1" = 100'

LAUNDON • SIMON • CAHL & ASSOC.
ENGINEERS — SURVEYORS
106 MIDDLE AVE. ELYRIA, OHIO 44035

JOB Nº 91-2000

F.B. 220 PGS. 529

259