09-00-087-A
09-00-097-A

9-00-087-105-022, 001
09-00-097-000-006

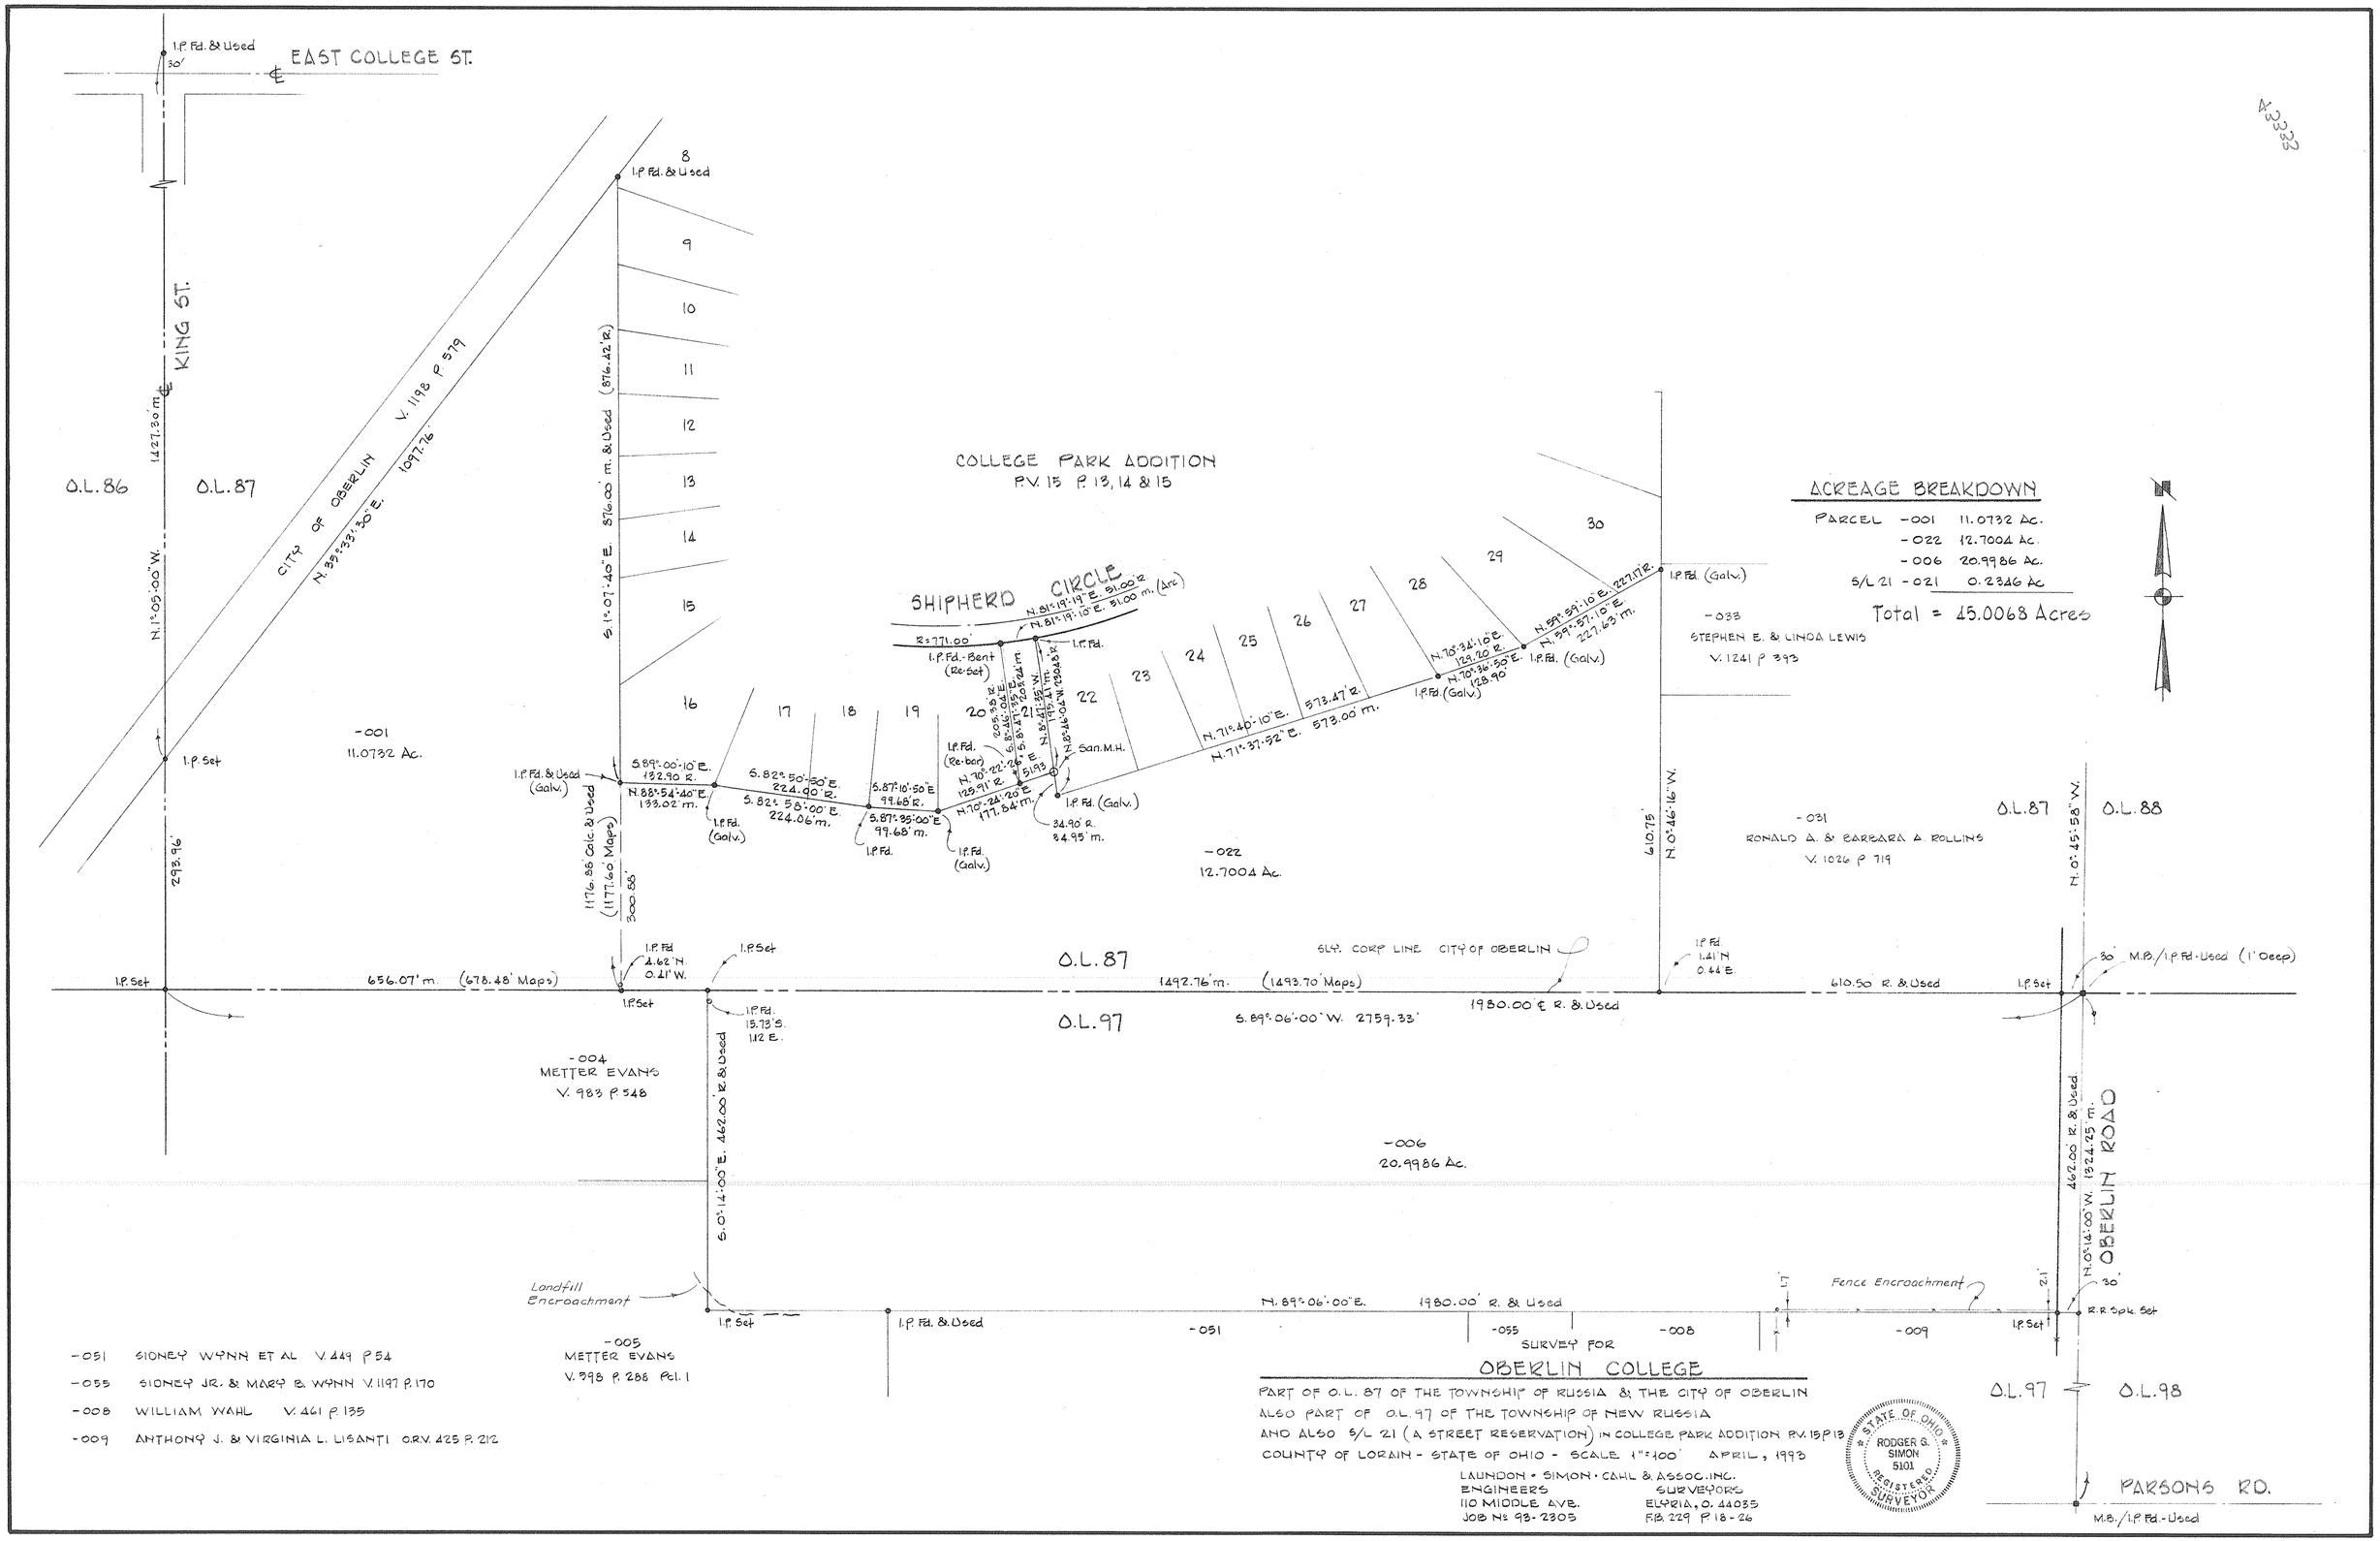

-051 SIDNEY WYNN ET AL V. 449 P. 54
-055 SIDNEY JR. & MARY B. WYNN V. 1197 P. 170
-008 WILLIAM WAHL V. 461 P. 135
-009 ANTHONY J. & VIRGINIA L. LISANTI O.R.V. 425 P. 212

PART OF O.L. 87 OF THE TOWNSHIP OF RUSSIA & THE CITY OF OBERLIN
ALSO PART OF O.L. 97 OF THE TOWNSHIP OF NEW RUSSIA
AND ALSO S/L 21 (A STREET RESERVATION) IN COLLEGE PARK ADDITION P.V. 15 P. 13
COUNTY OF LORAIN - STATE OF OHIO - SCALE 1" = 100' APRIL, 1993

LAUNDON • SIMON • CAHL & ASSOC. INC.
ENGINEERS — 110 MIDDLE AVE. — JOB No. 93-2303
SURVEYORS — ELYRIA, O. 44035 — F.B. 229 P. 18-26

287