06-22-006-102-024 031
6-14 036 037

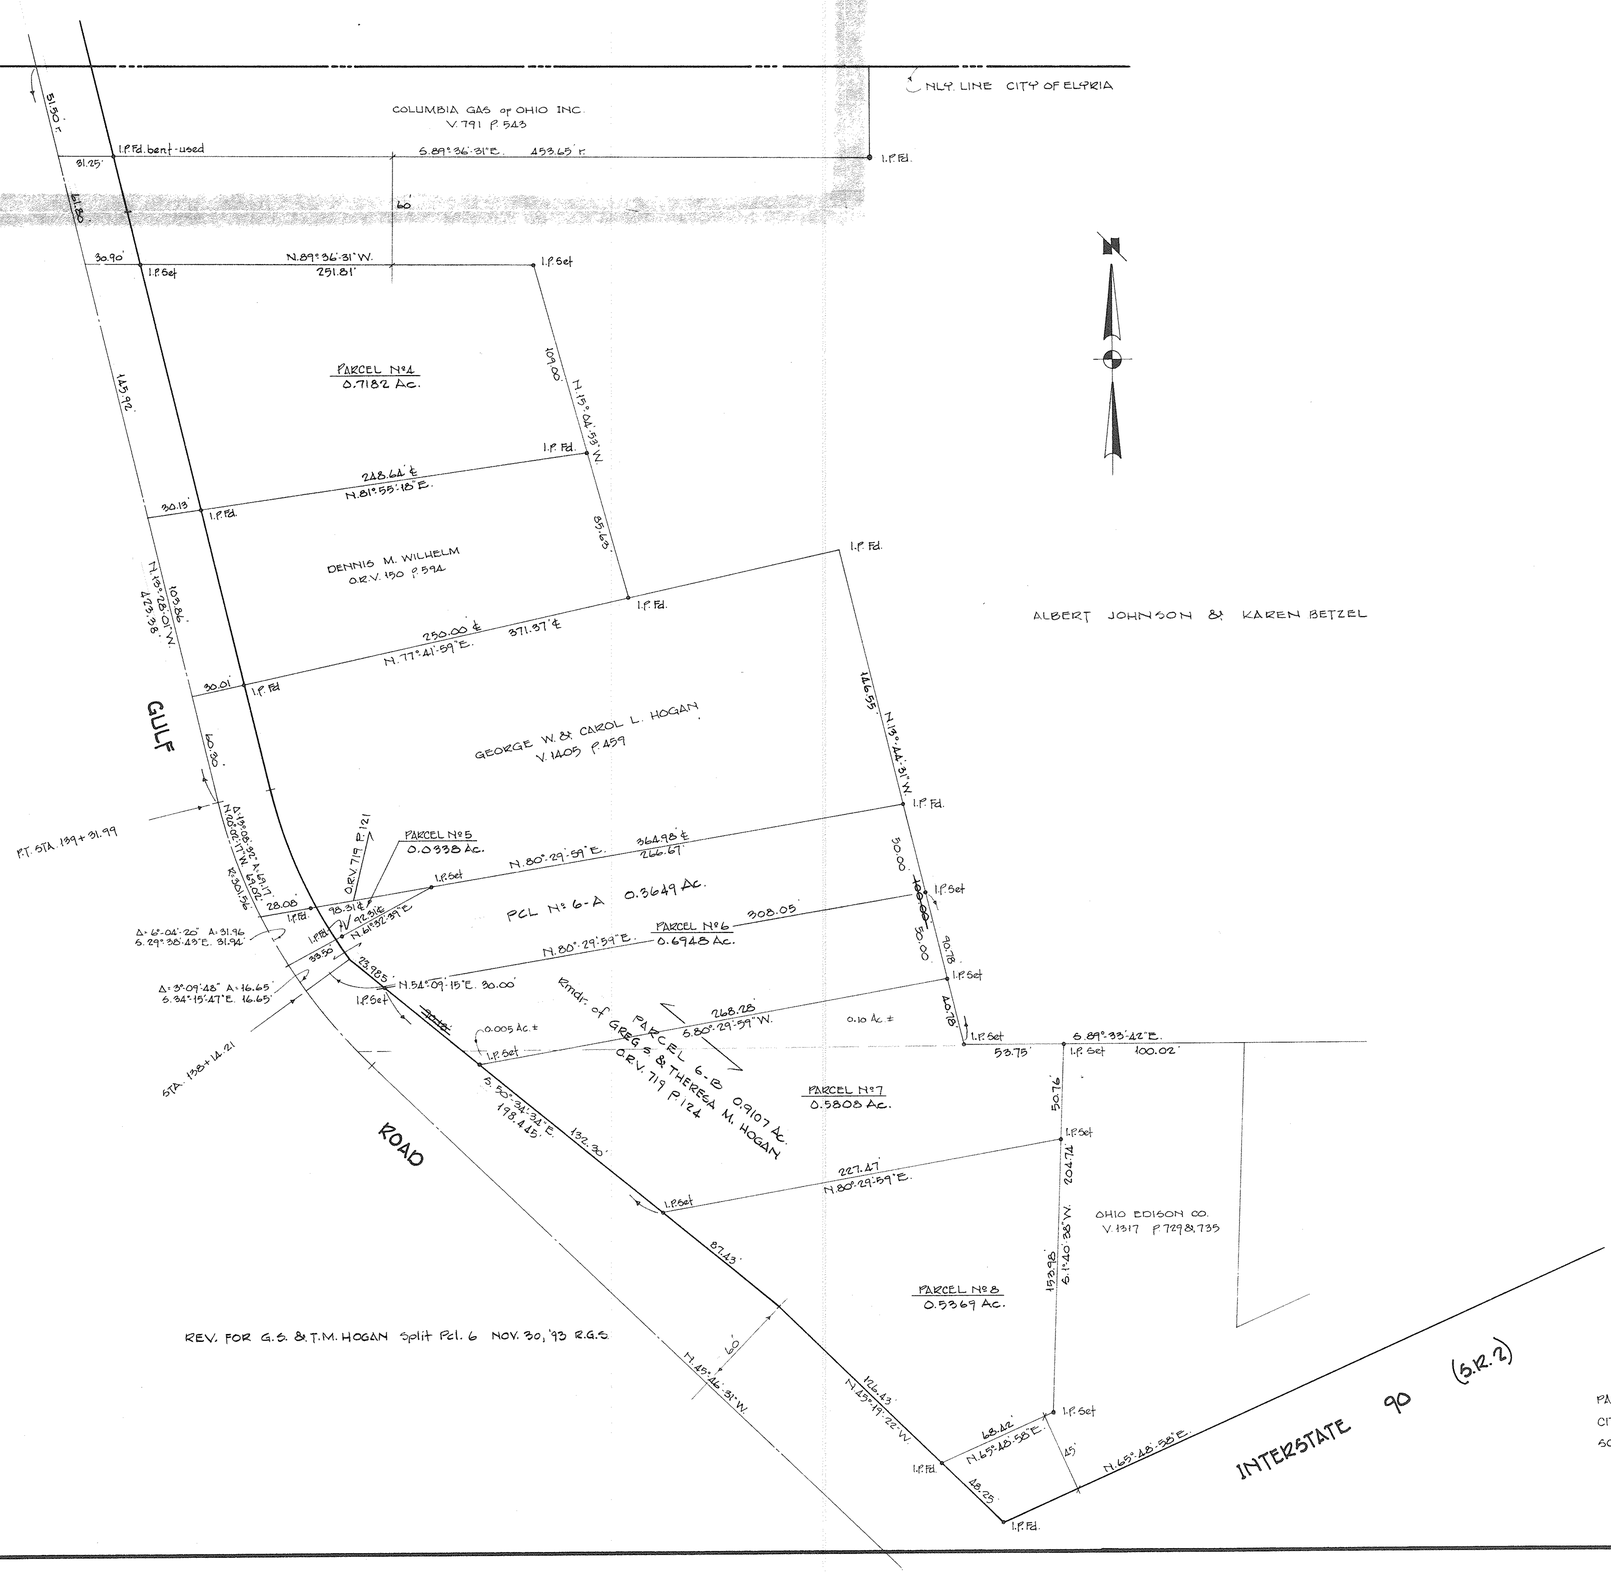

REV. FOR G.S. & T.M. HOGAN Split Pcl. 6 NOV. 30, '93 R.G.S.

SURVEY FOR

ALBERT JOHNSON

PART OF O.L. 6 BURRELL & DAY TRACT OF ELYRIA TWP.
CITY OF ELYRIA LORAIN COUNTY OHIO
SCALE 1" = 40' APRIL, 1990

LAUNDON • SIMON • CAHL & ASSOC.
ENGINEERS SURVEYORS

JOB Nº 90-1926