06·23·008·101·004
6·24

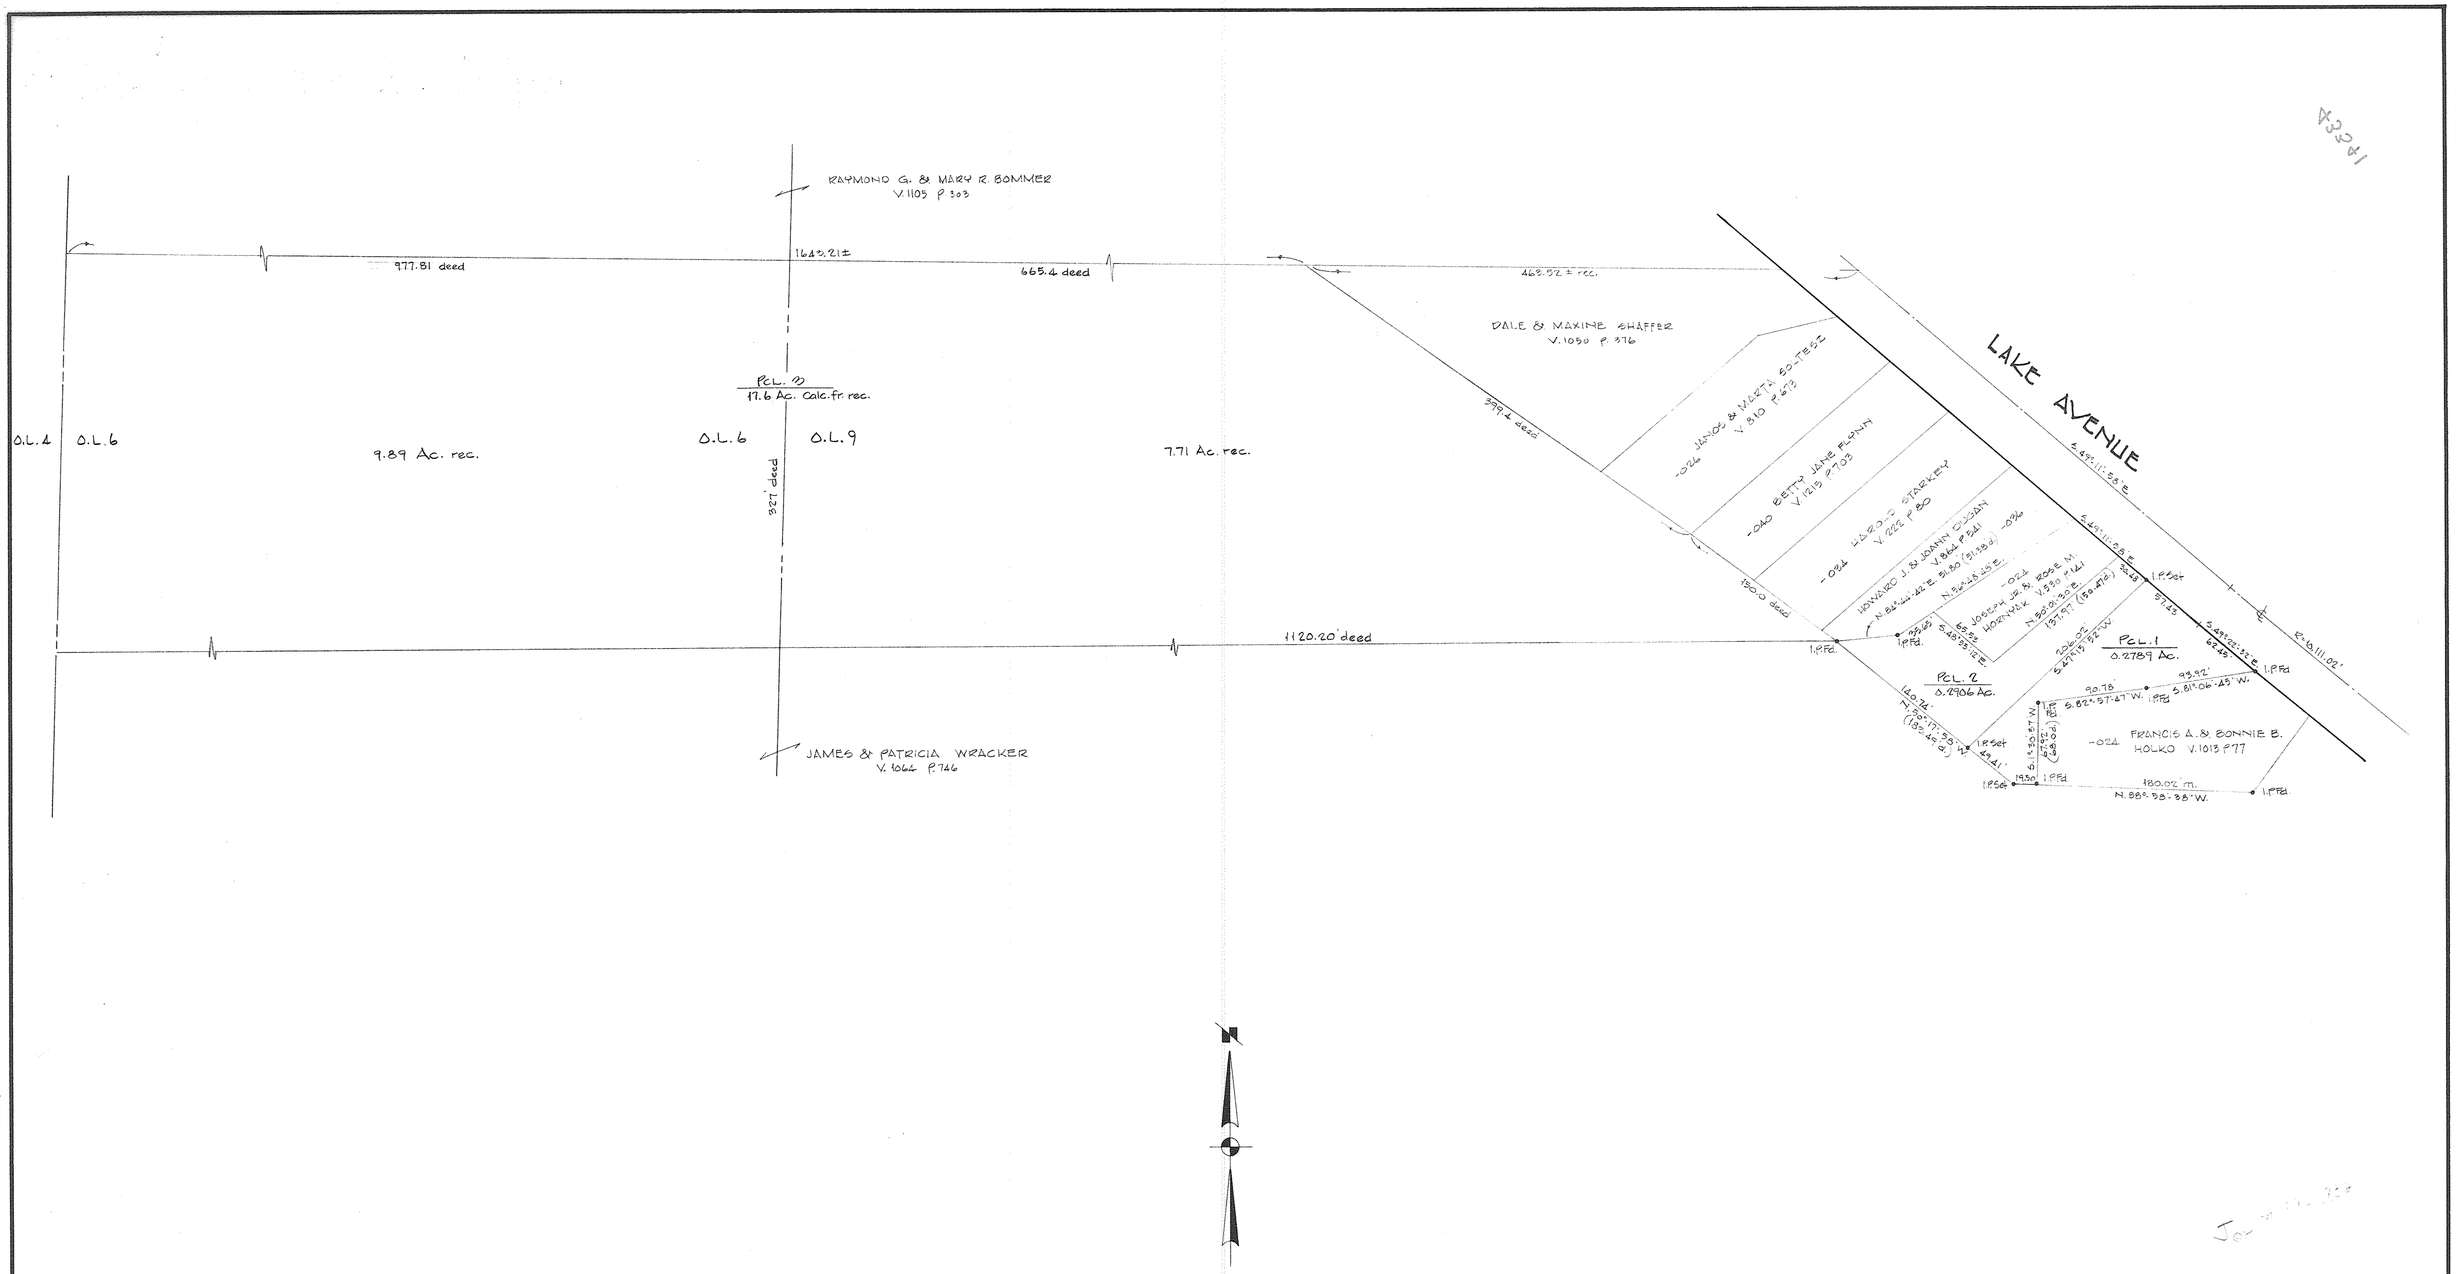

SURVEY AND SKETCH FOR

ELIZABETH HORNYAK

PART OF O.L. 6 & O.L. 9 BRACE TRACT — TOWNSHIP OF ELYRIA

COUNTY OF LORAIN — STATE OF OHIO

SCALE 1"=60' — APRIL, 1990

LAUNDON • SIMON • CAHL & ASSOC.

ENGINEERS — SURVEYORS

2A8